


Map No. _____ Sec. 12 Twp. 26 R. 4
 Well No. 15 - Denny Farm _____
Union Company _____

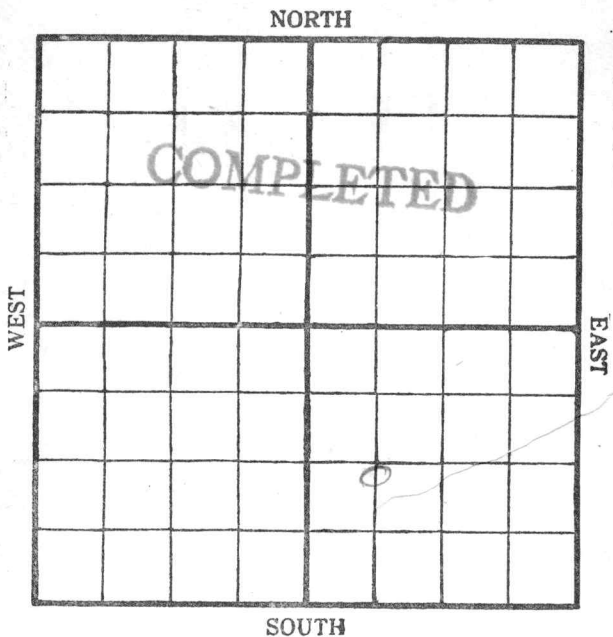

Location _____

Drilling Remarks:

Rig Up _____

Drilling Remarks:

RECORD

Cased _____ in. _____ ft.
 Sand _____
 Gas _____
 Oil _____
 Total Depth _____

PRODUCTION

1st 24 hrs. Nat. _____
 1st 24 hrs. after shot _____
 Gas _____ cu. ft
 Dry Hole _____
 Abandoned _____

Map No. _____ Sec. 12 Twp. 26 R. 4
 Well No. 152 Sunny
Union Company

NORTH

WEST

EAST

SOUTH

Location _____

Rig up _____

Drilling and Remarks:

440

FIRST REPORT

RECORD

Cased _____ in., _____ ft.

Sand _____

Gas _____

Oil _____

Total Depth _____

PRODUCTION

1st 24 hrs. Nat. _____

1st 24 hrs. after shot _____

Gas _____ Cu. Ft.

Dry Hole _____

Abandoned _____

Date

10/31

191

7 Conley


Scout

Map No. _____ Sec. 12 Twp. 26 R. 4Well No. 152 Farm _____

Company _____

NORTH

WEST

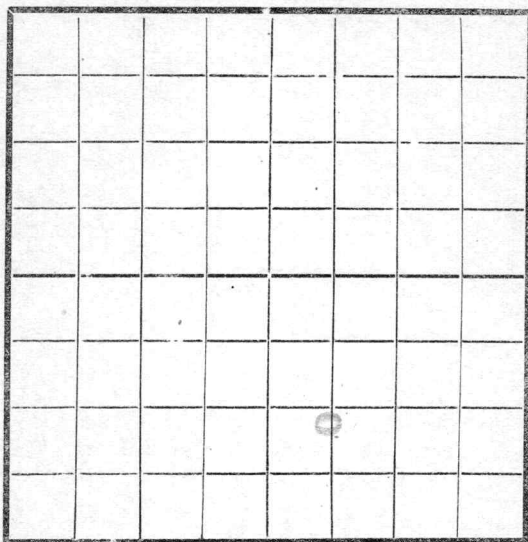

EAST

SOUTH

Location _____

Rig Up _____

Drilling and remarks

550

RECORD

Cased _____ in. _____ Ft.

Sand _____

Gas _____

Oil _____

Total Depth _____

PRODUCTION

1st 24 hrs. Nat. _____

1st 24 hrs. after shot _____

Gas _____ Cu. Ft.

Dry Hole _____

Abandoned _____


Date

11-7, 1917 Candiff Scout

Map No. _____ Sec. 12 Twp. 26 R. 4
 Well No. 15 Denny Farm _____
Union Company _____

NORTH

WEST

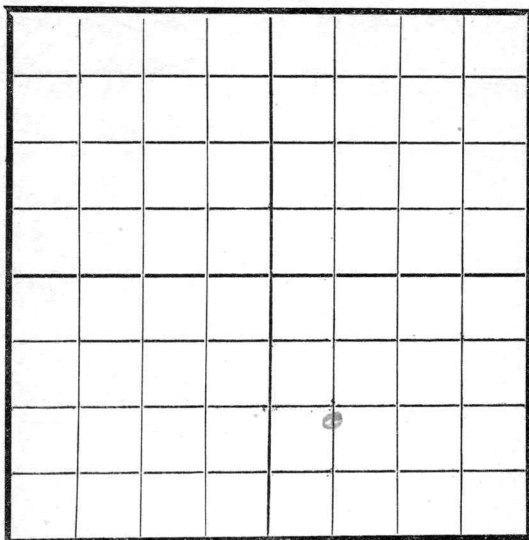

EAST

SOUTH

Location _____
 Rig Up _____
 Drilling and remarks

950

RECORD

Cased _____ in. _____ Ft.
 Sand _____
 Gas _____
 Oil _____
 Total Depth _____

PRODUCTION

1st 24 hrs. Nat. _____
 1st 24 hrs. after shot _____
 Gas _____ Cu. Ft.
 Dry Hole _____
 Abandoned _____

Date


4/14, 1917 Cordell Scout

Map No. _____ Sec. 12 Twp. 26 R. 4Well No. 152 Sunny Farm _____

Company _____

NORTH

WEST

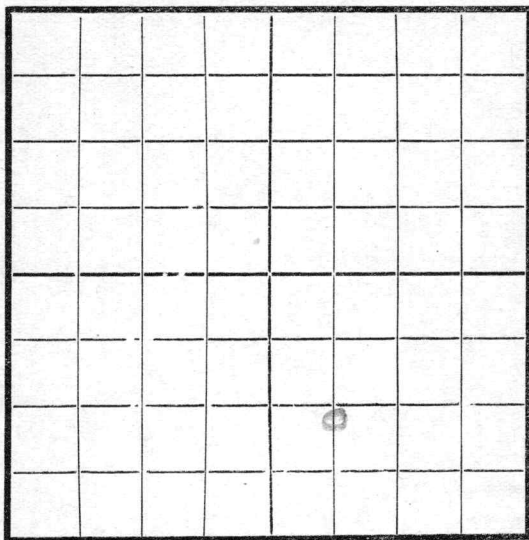

EAST

SOUTH

Location _____

Rig Up _____

Drilling and remarks

RECORD

Cased _____ in. _____ Ft.

Sand _____

Gas _____

Oil _____

Total Depth _____

PRODUCTION

1st 24 hrs. Nat. _____

1st 24 hrs. after shot _____

Gas _____ Cu. Ft.

Dry Hole _____

Abandoned _____

Date

11/21, 1917 Andy Scout


Map No. _____ Sec. 12 Twp. 26 R. 4

Well No. 15 Denny Farm

Union Company

NORTH

WEST

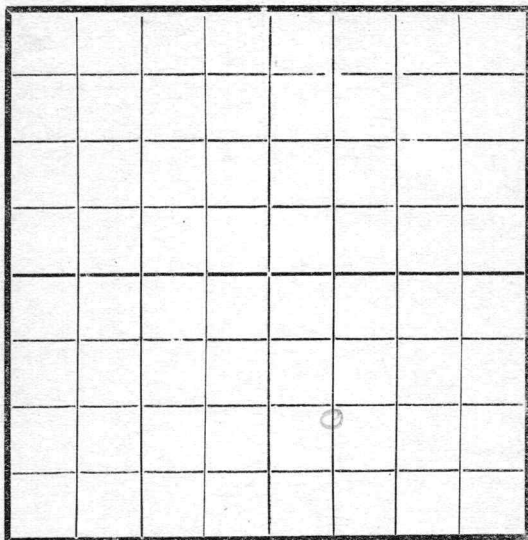

EAST

SOUTH

Location _____

Rig Up _____

Drilling and remarks

1030

RECORD

Cased _____ in. _____ Ft.

Sand _____

Gas _____

Oil _____

Total Depth _____

PRODUCTION

1st 24 hrs. Nat. _____

1st 24 hrs. after shot _____

Gas _____ Cu. Ft.

Dry Hole _____

Abandoned _____


Date

11/28, 1917 Candey Scout

Map No. _____ Sec. 12 Twp. 26 R. 4Well No. 152enny Farm _____
Union Company _____

NORTH

WEST

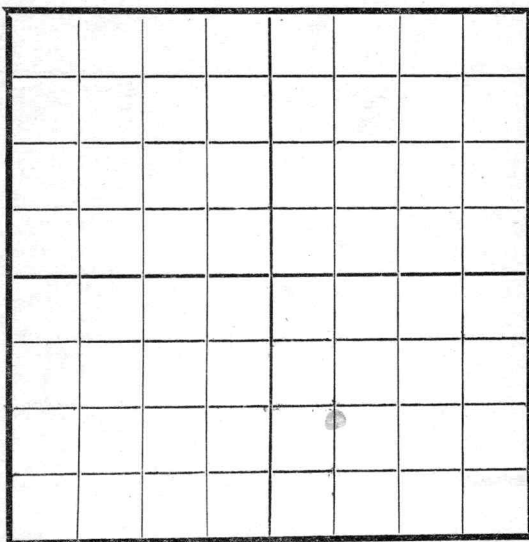

EAST

SOUTH

Location _____

Rig Up _____

Drilling and remarks

1420

RECORD

Cased _____ in. _____ Ft.

Sand _____

Gas _____

Oil _____

Total Depth _____

PRODUCTION

1st 24 hrs. Nat. _____

1st 24 hrs. after shot _____

Gas _____ Cu. Ft.

Dry Hole _____

Abandoned _____

Date

12/5, 1917 Conroy Scout


Form 26—1M Books of 100 Sheets Each.

Map No. _____ Sec. 12 Twp. 26 R. 4

Well No. 15 Denny Farm _____

Union Oil Company _____

NORTH

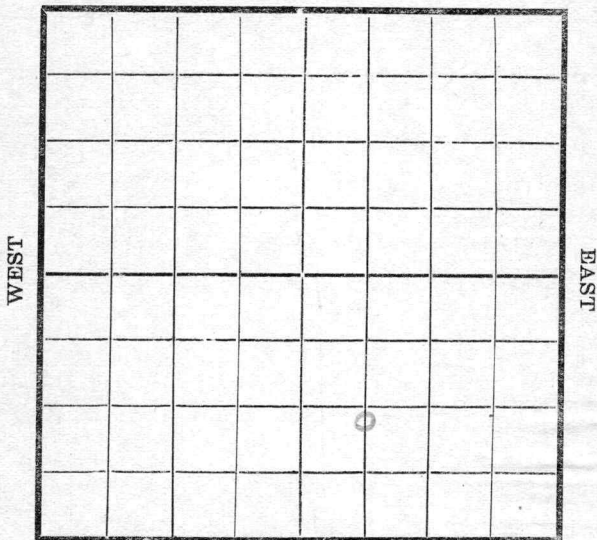

SOUTH

Location _____

Rig Up _____

Drilling and remarks

1780

RECORD

Cased _____ in. _____ Ft.

Sand _____

Gas _____

Oil _____

Total Depth _____

PRODUCTION

1st 24 hrs. Nat. _____

1st 24 hrs. after shot _____

Gas _____ Cu. Ft.


Dry Hole _____

Abandoned _____

Date

1/2, 1918 S. Land Scout

Map No. _____ Sec. 12 Twp. 26 R. 4
 Well No. 15-2-2-1 Farm _____
Union Oil Company

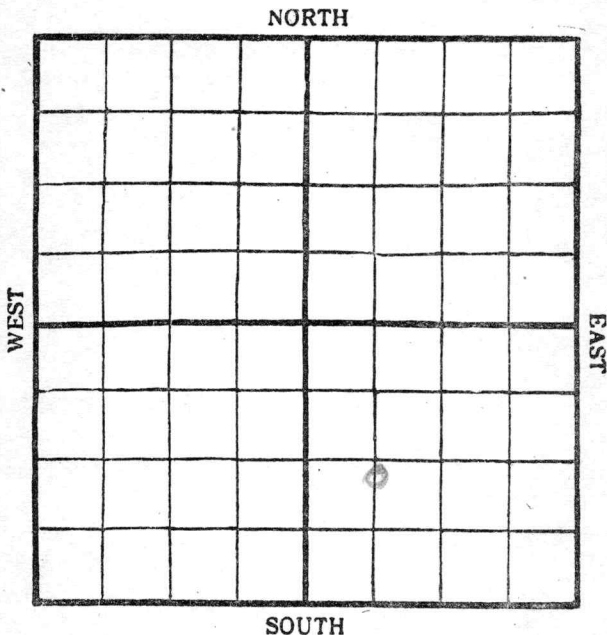

Location _____

Rig Up _____

Drilling and remarks

2350

RECORD

Cased _____ in. _____ Ft.

Sand _____

Gas _____

Oil _____

Total Depth _____

PRODUCTION

1st 24 hrs. Nat. _____

1st 24 hrs. after shot _____

Gas _____ Cu. Ft.

Dry Hole _____


Abandoned _____

Date

1/16, 1918, Condy Scout

Map No. _____ Sec. 12 Twp. 26 R. 4
 Well No. 152 Farm _____
Union Oil Company

NORTH

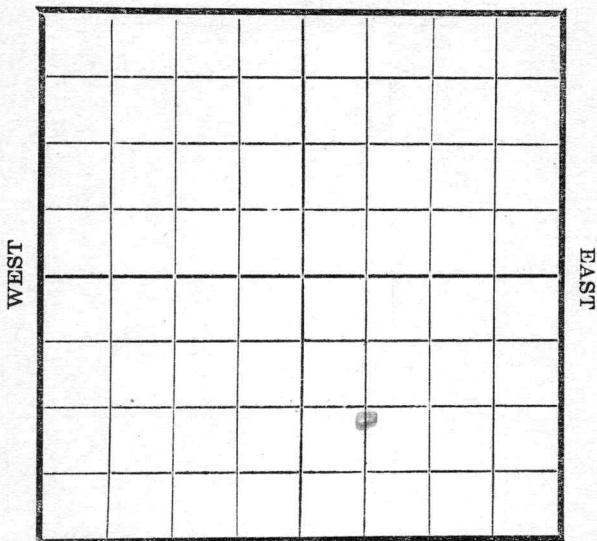

SOUTH

Location _____
 Rig Up _____
 Drilling and remarks

22
2350'

RECORD

Cased _____ in. _____ Ft.
 Sand _____
 Gas _____
 Oil _____
 Total Depth _____

PRODUCTION

1st 24 hrs. Nat. _____
 1st 24 hrs. after shot _____
 Gas _____ Cu. Ft.
 Dry Hole _____
 Abandoned _____

Date

1/23, 1918 Carbide Scout

Map No. _____ Sec. 12 Twp. 26 R. 4


Well No. 152 Henry Farm _____

Union Company

NORTH

WEST

EAST

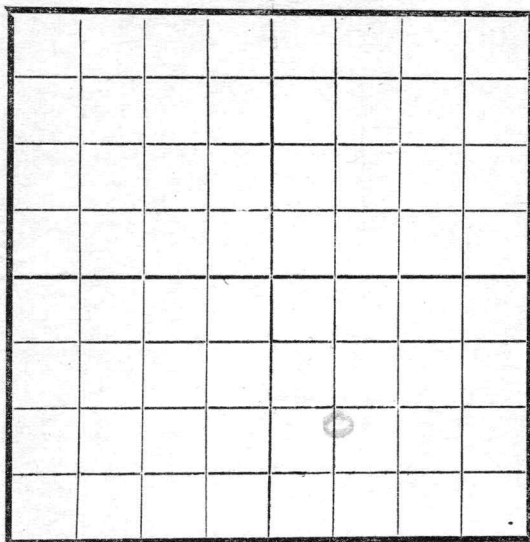

SOUTH

Location _____

Rig Up _____

Drilling and remarks

RECORD

Cased _____ in _____ Ft.

Sand _____

Gas _____

Oil _____

Total Depth _____

PRODUCTION

1st 24 hrs. Nat. _____

1st 24 hrs. after shot _____

Gas _____ Cu. Ft.


Dry Hole _____

Abandoned _____

Date

1/30, 1918 Scout

Map No. _____ Sec. 12 Twp. 26 R. 4
 Well No. 158 Farm _____
 _____ Company _____
 Date Started _____ Ft. from N _____ S _____ E _____ W _____ line
 NORTH

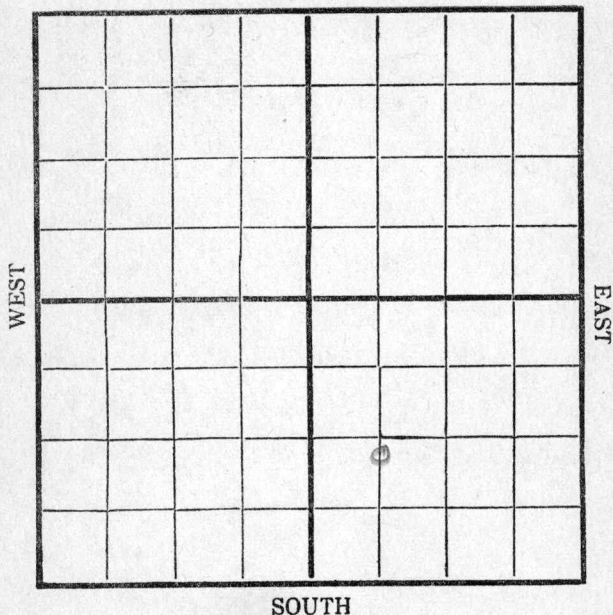

Cased _____ In. _____ Ft.
 Sand _____
 Pay { Gas _____
 Oil _____
 Total Depth _____

Production Remarks

Condition of Well on this date 2/6/18

22 2350

Condy


Scout

Map No. _____ Sec. 12 Twp. 26 R. 4

Well No. 158 Farm _____
Union Company

NORTH

WEST

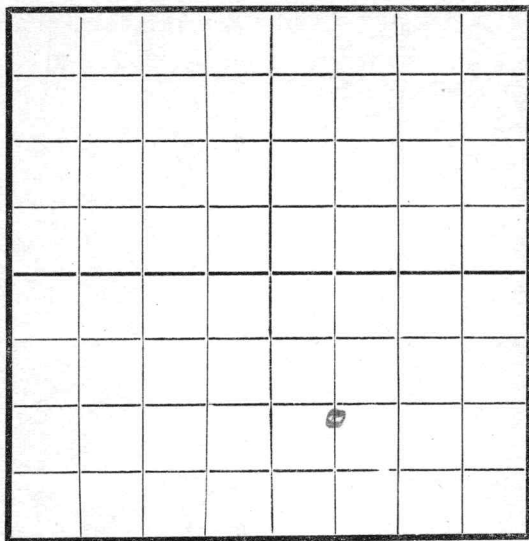

EAST

SOUTH

Location _____

Rig Up _____

Drilling and remarks

LD

2400

RECORD

Cased _____ in. _____ Ft.

Sand _____

Gas _____

Oil _____

Total Depth _____

PRODUCTION

1st 24 hrs. Nat. _____

1st 24 hrs. after shot _____

Gas _____ Cu. Ft.

Dry Hole _____

Abandoned _____


Date

2/13, 1918 Conley Scout

Map No. K 1A Sec. 12 Twp. 26 R. 4
 Well No. 155 Survey Farm _____
Union Company _____

NORTH

WEST

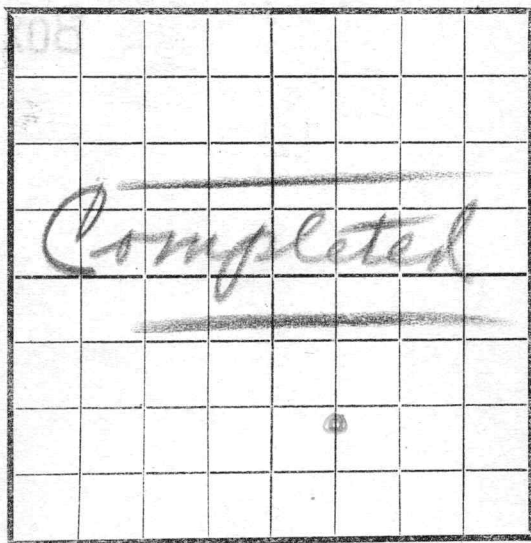

EAST

SOUTH

Location _____

Rig Up _____

Drilling and remarks

*Estimated
at 350*

Bhe

RECORD

Cased _____ in. _____ Ft.

Sand 2412-2504

Gas _____

Oil _____

Total Depth _____

PRODUCTION

1st 24 hrs. Nat. _____

1st 24 hrs. after shot _____

Gas _____ Cu. Ft.

Dry Hole _____

Abandoned _____

Date

7-30, 1911 J. Cardy Scout