
Form 51—8-17—5M

Map No._____ Sec. 11 Twp. 26 R 4

Well No. 24 Shumway Farm

Gypsy Company

NORTH

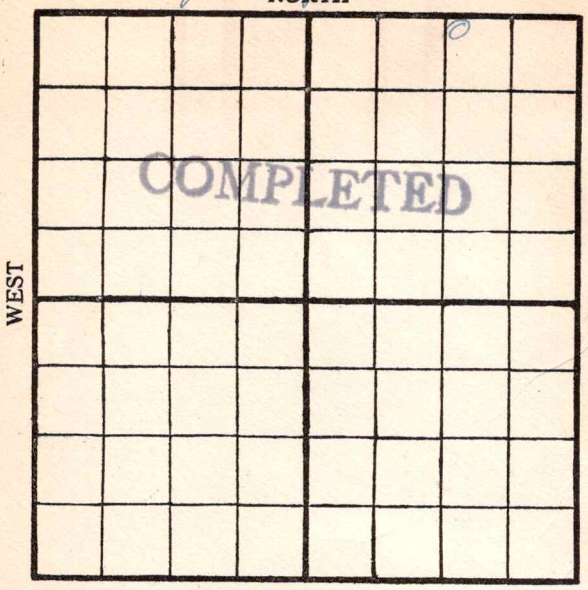

SOUTH

Location_____

Drilling Remarks:

Rig Up_____

Drilling Remarks:

RECORD

Cased_____ in._____ ft.

Sand _____

Gas _____

Oil _____

Total Depth_____

PRODUCTION

1st 24 hrs. Nat._____

1st 24 hrs. after shot_____

Gas_____ cu. ft

Dry Hole_____

Abandoned _____

Form T-135-2-14-17-2m. Books, 50 Sets to Book

Map No. _____ Sec. 11 Twp. 26 4 R. _____

Well No. 24 Shutmway Farm

Gypsy Company

NORTH

WEST EAST

SOUTH

Location ✓

Rig up _____

Drilling and remarks:

FIRST REPORT

RECORD

Cased _____ in. _____ Ft.

Sand _____

Gas _____

Oil _____

Total Depth _____

PRODUCTION

1st 24 hrs. Nat. _____

1st 24 hrs. after shot _____

Gas _____ Cu. Ft

Dry Hole _____

Abandoned _____

Date

11-7, 1917, Candy Scout


Form 26—1M Books of 100 Sheets Each.

Map No._____ Sec. 11 Twp. 26 R. 4

Well No. 24 Shannon Farm

Gypsy Company

NORTH

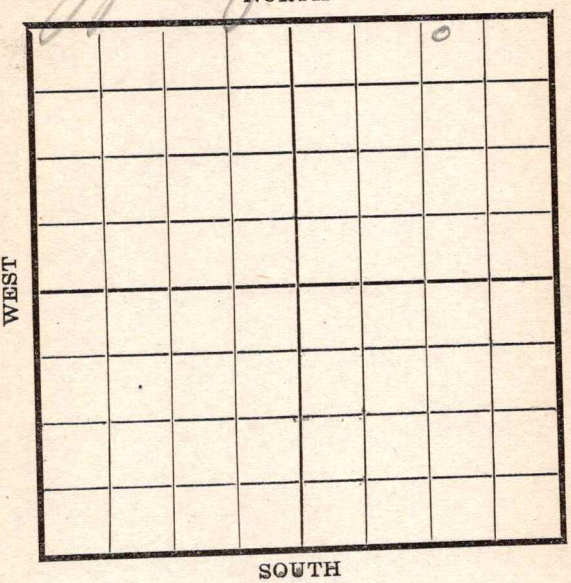

WEST

EAST

SOUTH

Location _____

Rig Up _____

Drilling and remarks

RECORD

Cased _____ in. _____ Ft.

Sand _____

Gas _____

Oil _____

Total Depth _____

PRODUCTION

1st 24 hrs. Nat. _____

1st 24 hrs. after shot _____

Gas _____ Cu. Ft.

Dry Hole _____

Abandoned _____

Date

4/14, 191__ J Condy Scout


Form 26—1M Books of 100 Sheets Each.

Map No. _____ Sec. 11 Twp. 26 R. 4

Well No. 24 Shumway Farm

Gypsy Company

NORTH

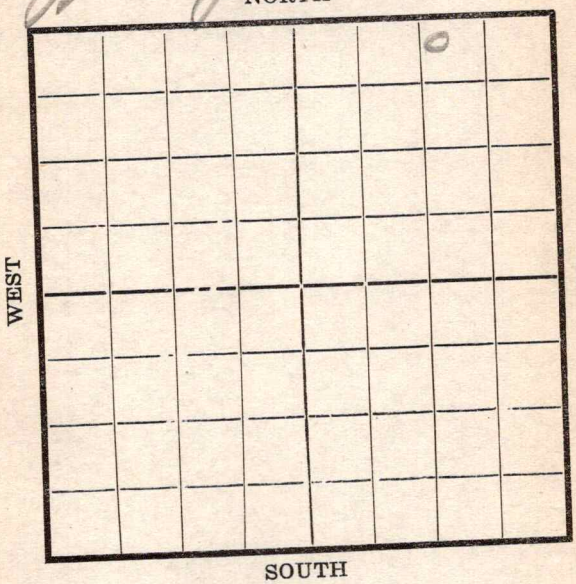

Location _____

Rig Up _____

Drilling and remarks

Rigging

RECORD

Cased _____ in. _____ Ft.

Sand _____

Gas _____

Oil _____

Total Depth _____

PRODUCTION

1st 24 hrs. Nat. _____

1st 24 hrs. after shot _____

Gas _____ Cu. Ft.

Dry Hole _____

Abandoned _____

Date


11/21, 1917 _____ Scout

Form 26—1M Books of 100 Sheets Each.

Map No. _____ Sec. 11 Twp. 26 R. 4

Well No. 2 Gypsy Farm

Gypsy Company

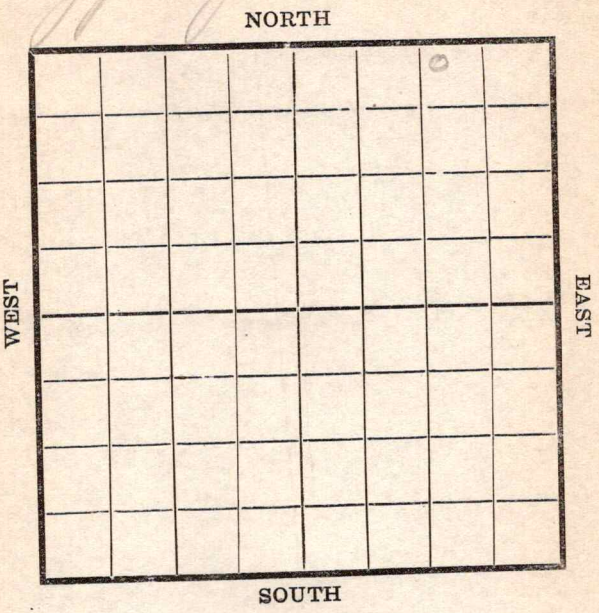

Location _____

Rig Up _____

Drilling and remarks

Gypsy

RECORD

Cased _____ in. _____ Ft.

Sand _____

Gas _____

Oil _____

Total Depth _____

PRODUCTION

1st 24 hrs. Nat. _____

1st 24 hrs. after shot _____

Gas _____ Cu. Ft.

Dry Hole _____

Abandoned _____

Date

11/28, 1917. _____ Scout


Form 26—1M Books of 100 Sheets Each.

Map No. _____ Sec. 11 Twp. 26 R. 4

Well No. 24 Shumway Farm

Gypsy Company

NORTH

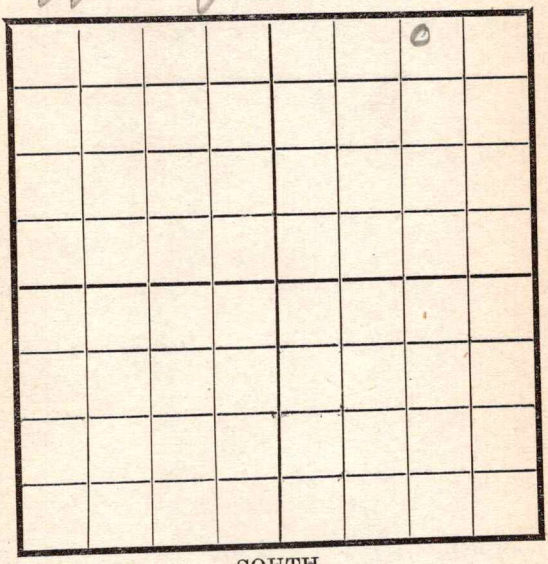

WEST

EAST

SOUTH

Location _____

Rig Up _____

Drilling and remarks

660

RECORD

Cased _____ in. _____ Ft.

Sand _____

Gas _____

Oil _____

Total Depth _____

PRODUCTION

1st 24 hrs. Nat. _____

1st 24 hrs. after shot _____

Gas _____ Cu. Ft.

Dry Hole _____

Abandoned _____

Date

12/5, 1917. Coudy Scout


Form 26—1M Books of 100 Sheets Each.

Map No._____ Sec. 11 Twp. 26 R. 4

Well No. 24 Shumway Farm

Gypsy Oil Company

NORTH

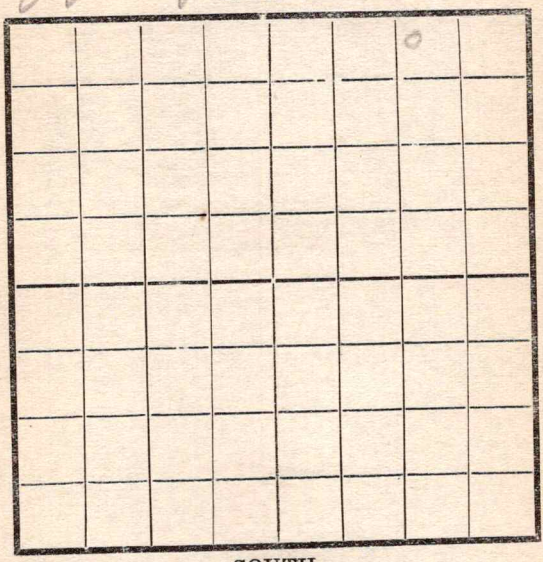

WEST

EAST

SOUTH

Location _____

Rig Up _____

Drilling and remarks

1550

RECORD

Cased _____ in. _____ Ft.

Sand _____

Gas _____

Oil _____

Total Depth _____

PRODUCTION

1st 24 hrs. Nat. _____

1st 24 hrs. after shot _____

Gas _____ Cu. Ft.

Dry Hole _____

Abandoned _____

Date

1/3, 1918. E. Candy Scout


Form 26—1M Books of 100 Sheets Each.

Map No. _____ Sec. 11 Twp. 26 R. 4

Well No. 2 A Shumway Farm

Gypsy Company

NORTH

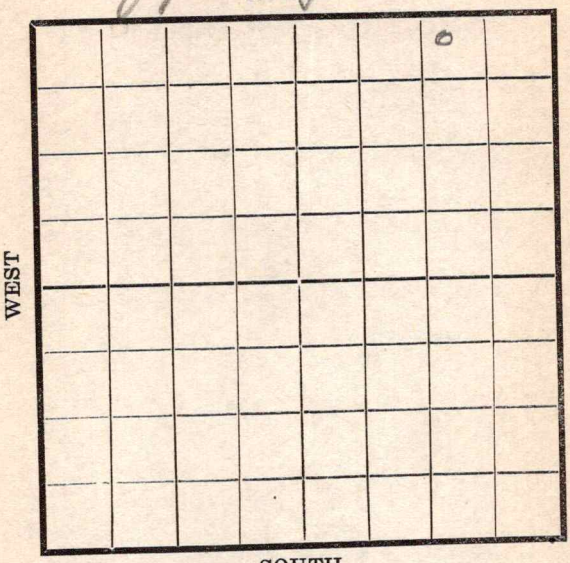

Location	**RECORD**
Rig Up	Cased _____ in. _____ Ft.
Drilling and remarks	Sand
SD 1725	Gas
	Oil
	Total Depth
	PRODUCTION
	1st 24 hrs. Nat.
	1st 24 hrs. after shot
	Gas _____ Cu. Ft.
	Dry Hole
	Abandoned

Date

1/16, 1918 _____ Scout


Form 26—1M Books of 100 Sheets Each.

Map No. _____ Sec. 11 Twp. 26 R. 4

Well No. 24 Shumway Farm

Gypsy Oil Company

NORTH

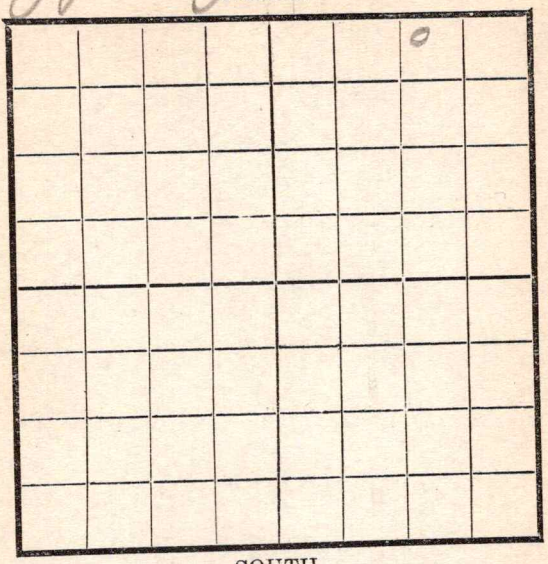

WEST

EAST

SOUTH

Location _____

Rig Up _____

Drilling and remarks

1885

RECORD

Cased _____ in. _____ Ft.

Sand _____

Gas _____

Oil _____

Total Depth _____

PRODUCTION

1st 24 hrs. Nat. _____

1st 24 hrs. after shot _____

Gas _____ Cu. Ft.

Dry Hole _____

Abandoned _____

Date

1/23, 1918. Ernest [illegible] Scout


Form 26—1M Books of 100 Sheets Each.

Map No. _____ Sec. 11 Twp 26 R. 4

Well No. 24 Rhumann Farm

Guffey Company

NORTH

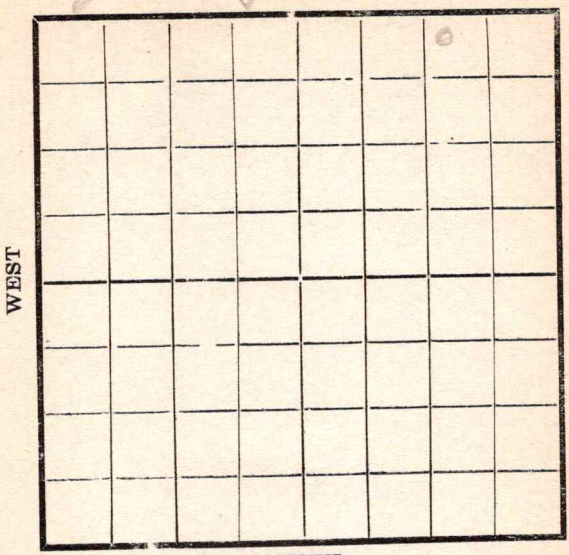

WEST

EAST

SOUTH

Location _____

Rig Up _____

Drilling and remarks

1925

RECORD

Cased _____ in. _____ Ft.

Sand _____

Gas _____

Oil _____

Total Depth _____

PRODUCTION

1st 24 hrs. Nat. _____

1st 24 hrs. after shot _____

Gas _____ Cu. Ft.

Dry Hole _____

Abandoned _____

Date

1/30, 191 _____ Scout


Form 26—1M Books of 100 Sheets Each.

Map No. _____ Sec. 11 Twp. 26 R. 4

Well No. 24 Obrien Farm

Gypsy Company

NORTH

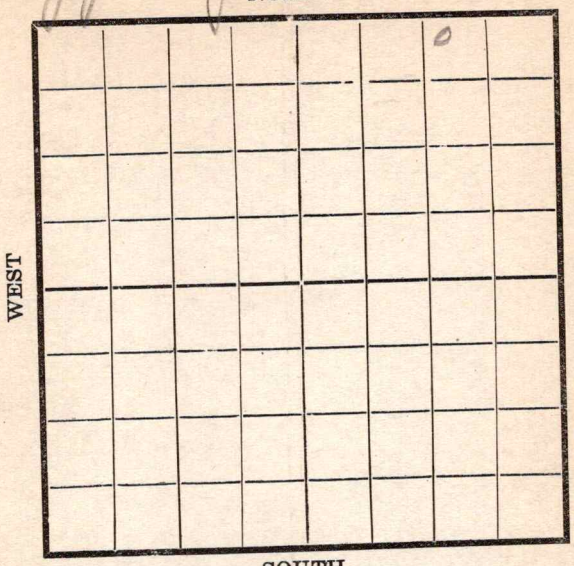

Location _____

Rig Up _____

Drilling and remarks

2050

RECORD

Cased _____ in. _____ Ft.

Sand _____

Gas _____

Oil _____

Total Depth _____

PRODUCTION

1st 24 hrs. Nat. _____

1st 24 hrs. after shot _____

Gas _____ Cu. Ft.

Dry Hole _____

Abandoned _____

Date

2/6, 191_. _____ Scout


Form 26—1M Books of 100 Sheets Each.

Map No. _____ Sec. 11 Twp. 26 R. 4

Well No. 24 Shumway Farm

Gypsy Company

NORTH

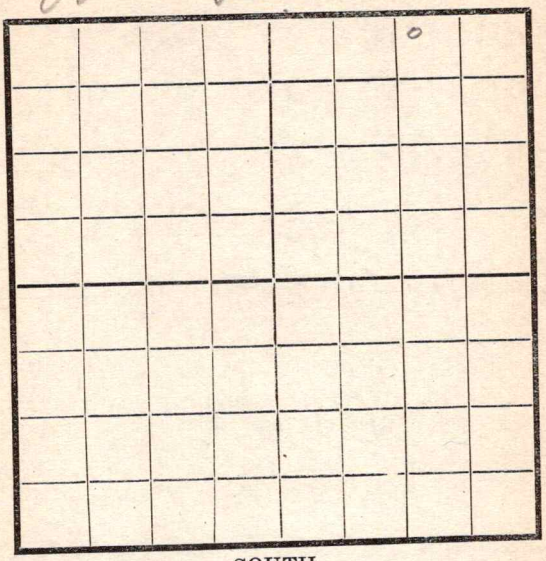

Location _____

Rig Up _____

Drilling and remarks

2300

RECORD

Cased _____ in. _____ Ft.

Sand _____

Gas _____

Oil _____

Total Depth _____

PRODUCTION

1st 24 hrs. Nat. _____

1st 24 hrs. after shot _____

Gas _____ Cu. Ft.

Dry Hole _____

Abandoned _____

Date

3/13, 1918. _____ Scout


Form 26—1M Books of 100 Sheets Each.

Map No. K-14 Sec. 11 Twp. 26 R. 4

Well No. 24 Shumway Farm

Gypsy Company

NORTH

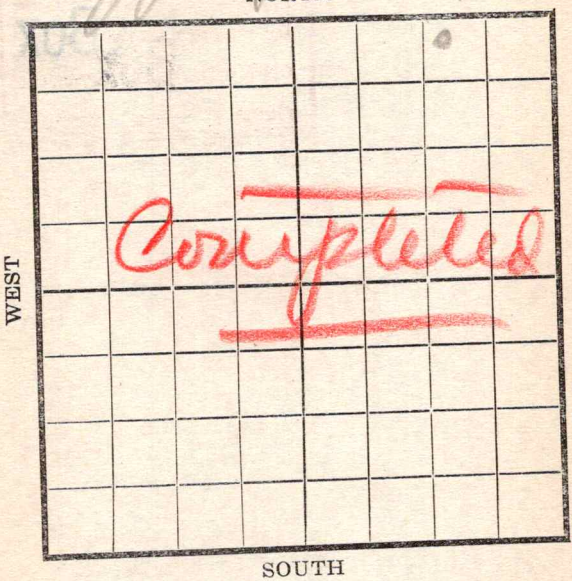

SOUTH

Location

Rig Up

Drilling and remarks

Drabbed
1600 Bbl
24 hrs

RECORD

Cased in. Ft.

Sand 2362-2404

Gas

Oil

Total Depth

PRODUCTION

1st 24 hrs. Nat.

1st 24 hrs. after shot

Gas Cu. Ft.

Dry Hole

Abandoned

Date

7/20, 1918. Scout