


Greenwood
 Map No. Ks Sec. 21 Twp. 23 R. 11
 Well No. 3-Edwards Farm
Empire G. & F. Company

NORTH

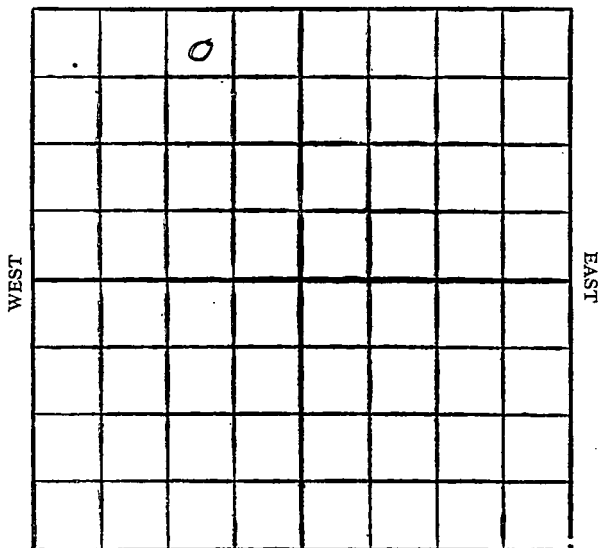

SOUTH

Location

Drilling Remarks

Rig Up

Drilling Remarks

RECORD

Cased in. ft.

Sand

Gas

Oil

Total Depth

PRODUCTION

1st 24 hrs. Nat.

1st 24 hrs. after shot

Gas cu. ft.

Dry Hole

Abandoned


Greenwood

Map No. 15 Sec. 21 Twp. 23 R. 11Well No. 3 Edwards Farm
Empire G. & F. Company330 Ft. from N. Line

_____ Ft. from S. Line

990 Ft. from E. Line

_____ Ft. from W. Line

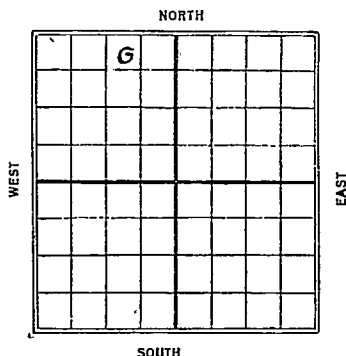1926

Date

REPORT

12/22 Timbers12/30 Rig19271/6 Rigging up1/13 Spudding 3001/19 Drilling 6351/26 " 11002/3 sand 1894-1960 - dreg -
150' oil in hole2/10 sand 1894-1960
180/350 bbls

Sherwood
 16 KANSAS
 Map No. _____ Sec. *21* Twp. *23* R. *11*
 Well No. *3 Edwards*
Comp. S L E Co Company

Contractor

FIRST REPORTS

SECTION PLAT

330 Ft. from N. Line

_____ Ft. from S. Line

990 Ft. from E. Line

_____ Ft. from W. Line

	o		

Location _____

Rig up *Timbers*

Drilling and Remarks:

RECORD

Cased _____ in., _____ ft.

Sand _____

Gas _____

Oil _____

Total Depth _____

PRODUCTION

1st 24 hrs. Nat. _____

1st 24 hrs. after shot _____

Gas _____ Cu. Ft.

Dry Hole _____

Abandoned _____

Date

DEC 22 1926

CHAS. L. SHERWOOD

192

Scout

16 KANSAS Sec. 21 Twp. 23 R. 11
 Map No. 3
 Well No. 3
 Empire S & T Co

Company

Contractor

COMPLETED

SECTION PLAT

330 Ft. from N. Line

Ft. from S. Line

990 Ft. from E. Line

Ft. from W. Line

	0		

Location

Rig up

Drilling and Remarks:

189 350 lbs.

RECORD

Cased in. ft.

Sand 1894-1960

Gas

Oil

Total Depth 1960

PRODUCTION

1st 24 hrs. Nat.

1st 24 hrs. after shot

Gas Cu. Ft.

Dry Hole

Abandoned

Date

FEB 10 1927

192

CHAS. L. SHERWOOD

Scout