
Form 51—8-17—5M

Map No._____ Sec. 11 Twp. 26 R. 4

Well No. 27 Shumway Farm

_____ Gypsy Company

NORTH

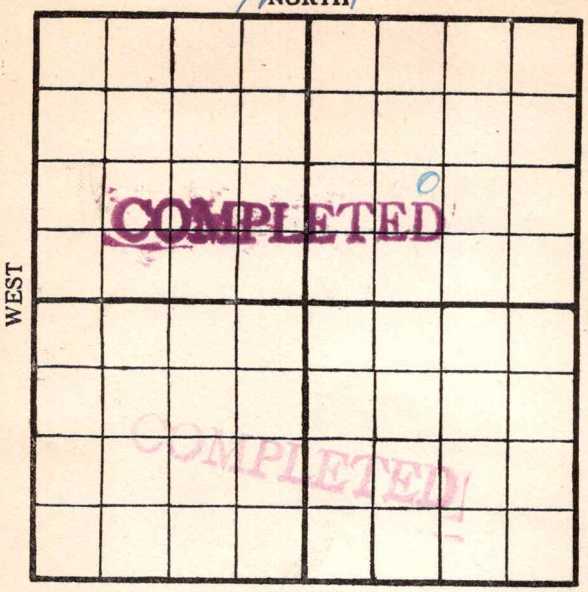

SOUTH

COMPLETED

Location_____

Drilling Remarks:

Rig Up_____

Drilling Remarks:

RECORD

Cased_____ in._____ ft.

Sand _____

Gas _____

Oil _____

Total Depth_____

PRODUCTION

1st 24 hrs. Nat._____

1st 24 hrs. after shot_____

Gas_____ cu. ft

Dry Hole_____

Abandoned _____


Form 26—1M Books of 100 Sheets Each.

Map No._____ Sec. 11 Twp. 26 R. 4

Well No. 27 Shumway Farm

Gypsy Company

NORTH

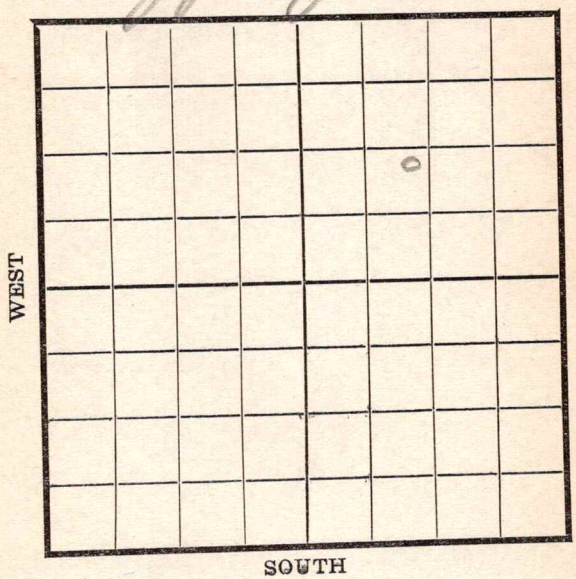

WEST

EAST

SOUTH

Location _____

Rig Up _____

Drilling and remarks

RECORD

Cased _____ in. _____ Ft.

Sand _____

Gas _____

Oil _____

Total Depth _____

PRODUCTION

1st 24 hrs. Nat. _____

1st 24 hrs. after shot _____

Gas _____ Cu. Ft.

Dry Hole _____

Abandoned _____

Date

11/24, 191__ J Crosby Scout


Form 26—1M Books of 100 Sheets Each.

Map No._____ Sec. 11 Twp. 26 R. 4

Well No. 27 Shumway Farm

Gypsy Company

NORTH

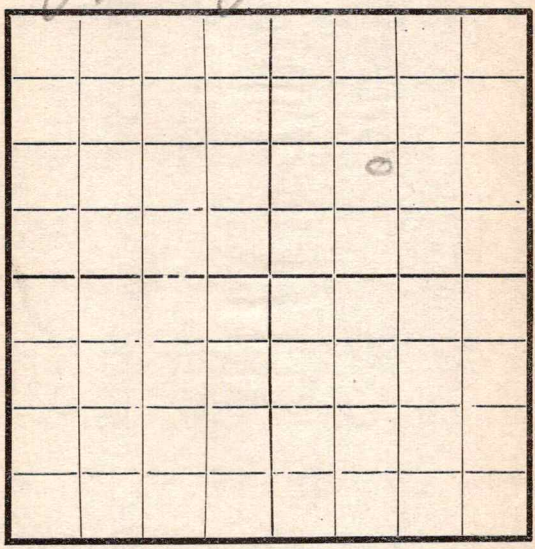

WEST

EAST

SOUTH

Location ✓

Rig Up ✓

Drilling and remarks

RECORD

Cased_____ in._____Ft.

Sand _____

Gas _____

Oil _____

Total Depth _____

PRODUCTION

1st 24 hrs. Nat._____

1st 24 hrs. after shot_____

Gas _____ Cu. Ft.

Dry Hole _____

Abandoned _____

Date

4/21, 191 7 Cundiff Scout


Form 26—1M Books of 100 Sheets Each.

Map No._____ Sec. 11 Twp. 26 R. 4

Well No. 27 Shumway Farm

Guyaney Company

NORTH

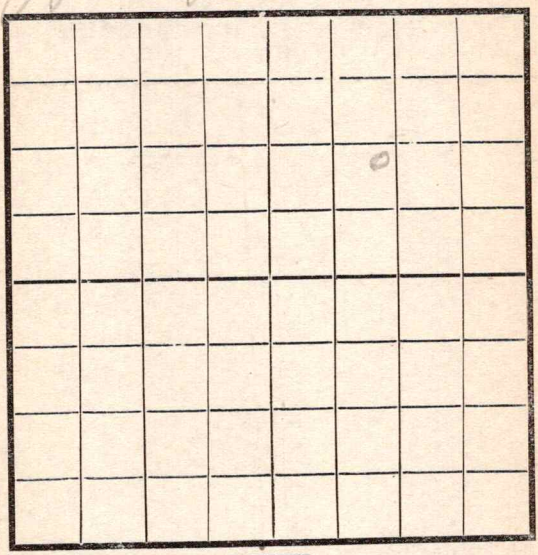

WEST

EAST

SOUTH

Location _____

Rig Up _____

Drilling and remarks

Duco

RECORD

Cased _____ in. _____ Ft.

Sand _____

Gas _____

Oil _____

Total Depth _____

PRODUCTION

1st 24 hrs. Nat. _____

1st 24 hrs. after shot _____

Gas _____ Cu. Ft.

Dry Hole _____

Abandoned _____

Date

11/28, 191 7 Earl Scout


Form 26—1M Books of 100 Sheets Each.

Map No. _____ Sec. 11 Twp. 26 R. 4

Well No. 27 Shumway Farm

Gypsy Company

NORTH

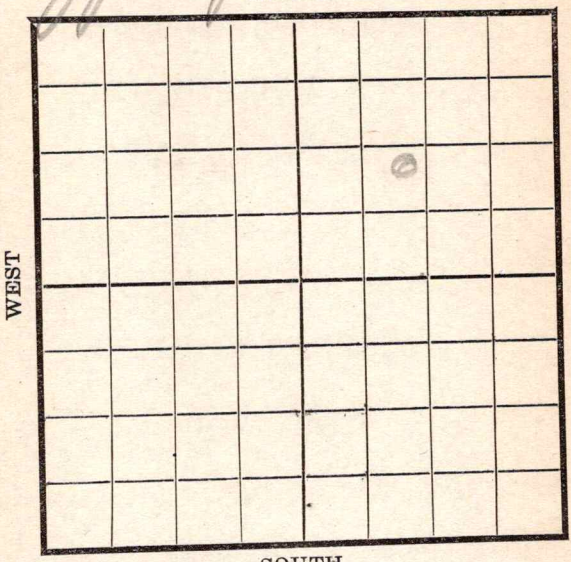

Location _____

Rig Up _____

Drilling and remarks

Abandoning

RECORD

Cased _____ in. _____ Ft.

Sand _____

Gas _____

Oil _____

Total Depth _____

PRODUCTION

1st 24 hrs. Nat. _____

1st 24 hrs. after shot _____

Gas _____ Cu. Ft.

Dry Hole _____

Abandoned _____

Date

12/5, 191 7. Camden Scout

Form T-135-2-14-17-2m. Books, 50 Sets to Book

Map No. _____ Sec. 11 Twp. 26 R. 4

Well No. 27 Shumway Farm

Gypsy Company

NORTH

WEST EAST

SOUTH

Location _____

Rig up V

Drilling and remarks:

FIRST REPORT

RECORD

Cased _____ in. _____ Ft.

Sand _____

Gas _____

Oil _____

Total Depth _____

PRODUCTION

1st 24 hrs. Nat. _____

1st 24 hrs. after shot _____

Gas _____ Cu. Ft.

Dry Hole _____

Abandoned _____

Date

11-7, 191 7, Candy Scout


Form 26—1M Books of 100 Sheets Each.

Map No. _____ Sec. 11 Twp. 24 R. 4

Well No. 27 Shumway Farm

Gypsy _____ Company

NORTH

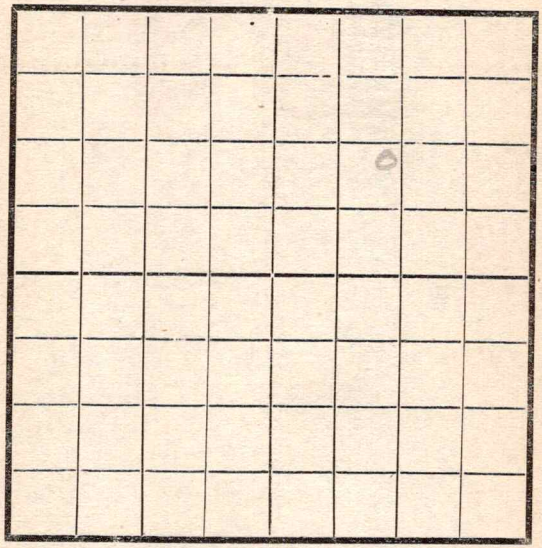

SOUTH

Location _____

Rig Up _____

Drilling and remarks

725

RECORD

Cased _____ in. _____ Ft.

Sand _____

Gas _____

Oil _____

Total Depth _____

PRODUCTION

1st 24 hrs. Nat. _____

1st 24 hrs. after shot _____

Gas _____ Cu. Ft.

Dry Hole _____

Abandoned _____

Date


1/3, 191 8 Cundy Scout

Form 26—1M Books of 100 Sheets Each.

Map No. _____ Sec. 11 Twp. 26 R. 4

Well No. 27 Plummer Farm

Gypsy Oil Company

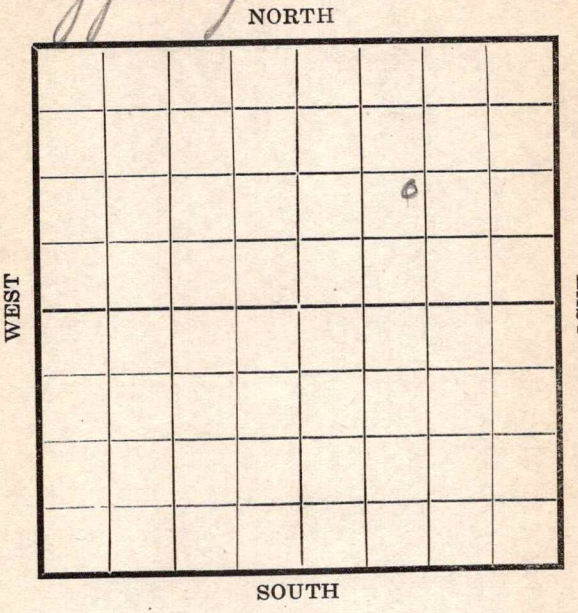

Location _____

Rig Up _____

Drilling and remarks

1125

RECORD

Cased _____ in. _____ Ft.

Sand _____

Gas _____

Oil _____

Total Depth _____

PRODUCTION

1st 24 hrs. Nat. _____

1st 24 hrs. after shot _____

Gas _____ Cu. Ft.

Dry Hole _____

Abandoned _____

Date

1/16, 191 8 _____ Scout


Form 26—1M Books of 100 Sheets Each.

Map No. _____ Sec. 11 Twp. 26 R. 4

Well No. 27 Shumway Farm

Gypsy Oil Company

NORTH

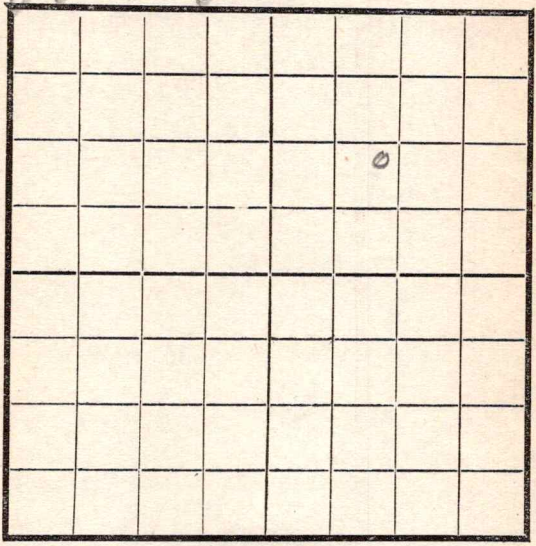

WEST

EAST

SOUTH

Location _____

Rig Up _____

Drilling and remarks

LD 1125'

RECORD

Cased _____ in. _____ Ft.

Sand _____

Gas _____

Oil _____

Total Depth _____

PRODUCTION

1st 24 hrs. Nat. _____

1st 24 hrs. after shot _____

Gas _____ Cu. Ft.

Dry Hole _____

Abandoned _____

Date

1/23, 1918. _____ Scout


Form 26—1M Books of 100 Sheets Each.

Map No. _____ Sec. 11 Twp 26 R. 4

Well No. 27 Shumway Farm

Gypsy Company

NORTH

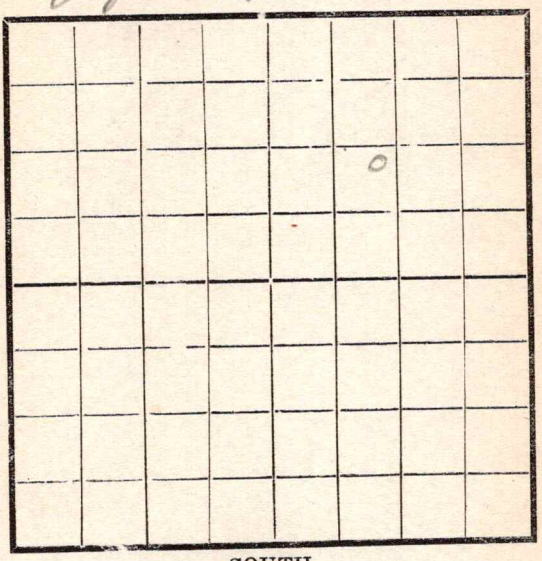

WEST

EAST

SOUTH

Location _____

Rig Up _____

Drilling and remarks

1530

RECORD

Cased _____ in. _____ Ft.

Sand _____

Gas _____

Oil _____

Total Depth _____

PRODUCTION

1st 24 hrs. Nat. _____

1st 24 hrs. after shot _____

Gas _____ Cu. Ft.

Dry Hole _____

Abandoned _____

Date


1/30, 1918 Cundiff Scout

Form 26—1M Books of 100 Sheets Each.

Map No. _____ Sec. 11 Twp. 26 R. 4

Well No. 27 Shumway Farm

Gypsy Company

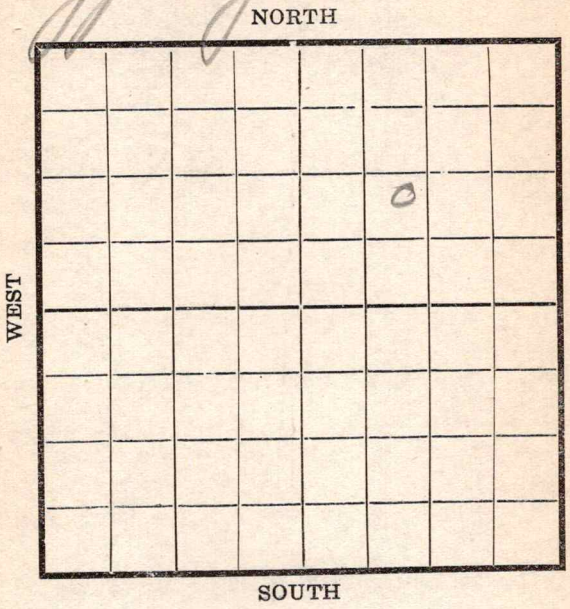

Location _____

Rig Up _____

Drilling and remarks

2D

1530

RECORD

Cased _____ in. _____ Ft.

Sand _____

Gas _____

Oil _____

Total Depth _____

PRODUCTION

1st 24 hrs. Nat. _____

1st 24 hrs. after shot _____

Gas _____ Cu. Ft.

Dry Hole _____

Abandoned _____

Date

2/6, 191_ _____ Scout


Form 26—1M Books of 100 Sheets Each.

Map No. _____ Sec. 11 Twp. 26 R. 4

Well No. 27 Shumway Farm

Gypsy Company

NORTH

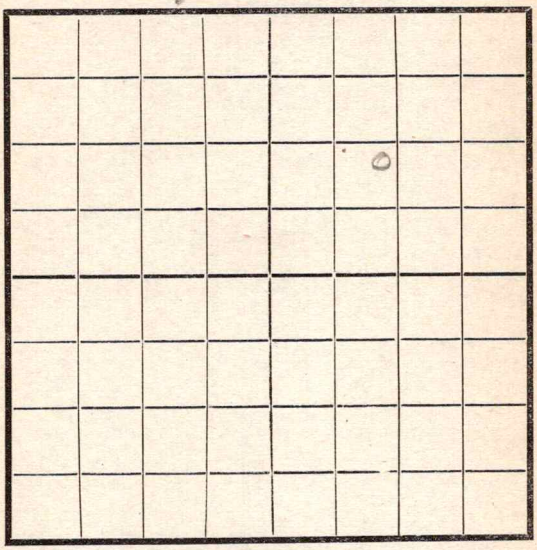

SOUTH

Location _____

Rig Up _____

Drilling and remarks

1540

RECORD

Cased _____ in. _____ Ft.

Sand _____

Gas _____

Oil _____

Total Depth _____

PRODUCTION

1st 24 hrs. Nat. _____

1st 24 hrs. after shot _____

Gas _____ Cu. Ft.

Dry Hole _____

Abandoned _____

Date

2/13, 1918. _____ Scout


Form 26—1M Books of 100 Sheets Each.

Map No._____ Sec. 4 Twp. 26 R. 4

Well No. 27 Shumway Farm

Gypsy Company

NORTH

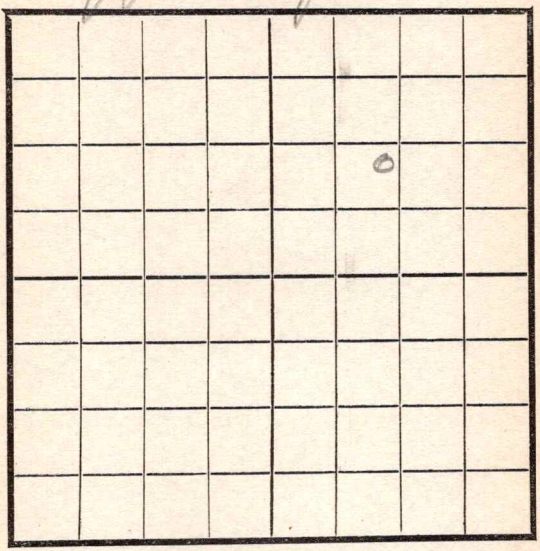

WEST

EAST

SOUTH

Location _____

Rig Up _____

Drilling and remarks

1870

RECORD

Cased _____ in. _____ Ft.

Sand _____

Gas _____

Oil _____

Total Depth _____

PRODUCTION

1st 24 hrs. Nat. _____

1st 24 hrs. after shot _____

Gas _____ Cu. Ft.

Dry Hole _____

Abandoned _____

Date

2/22, 1918. Randy Scout


Form 26—1M Books of 100 Sheets Each.

Map No._____ Sec. 11 Twp. 26 R. 4

Well No. 27 Shannon Farm

Gypsy Oil Company

NORTH

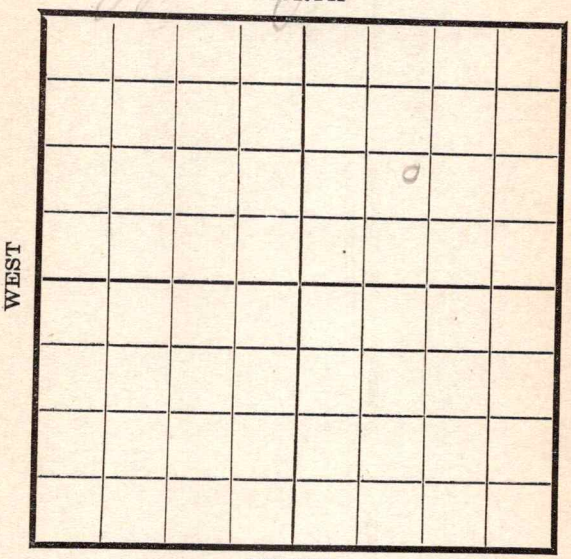

WEST

EAST

SOUTH

Location _____

Rig Up _____

Drilling and remarks

2095'

RECORD

Cased _____ in. _____ Ft.

Sand _____

Gas _____

Oil _____

Total Depth _____

PRODUCTION

1st 24 hrs. Nat. _____

1st 24 hrs. after shot _____

Gas _____ Cu. Ft.

Dry Hole _____

Abandoned _____

Date

3/27, 191__. E Condy Scout


Form 26—1M Books of 100 Sheets Each.

Map No._____ Sec. 11 Twp. 26 R. 4

Well No. 27 Shumway Farm

Gypsy Company

NORTH

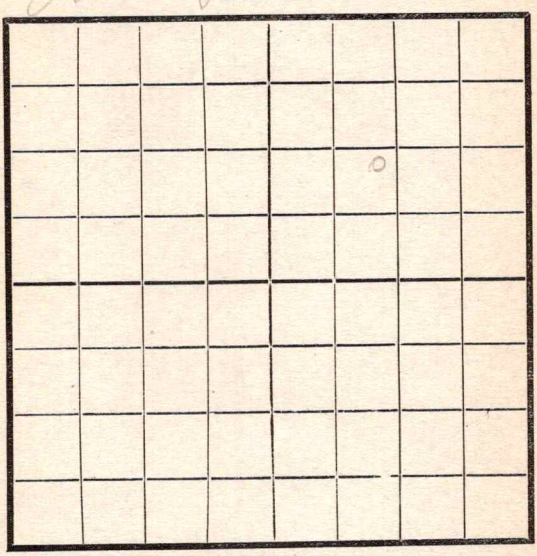

WEST

EAST

SOUTH

Location _____

Rig Up _____

Drilling and remarks

D2 3095

RECORD

Cased_____ in._____Ft.

Sand _____

Gas _____

Oil _____

Total Depth _____

PRODUCTION

1st 24 hrs. Nat._____

1st 24 hrs. after shot_____

Gas _____ Cu. Ft.

Dry Hole _____

Abandoned _____

Date

3/6 _____, 191__8. _____Scout


Form 26—1M Books of 100 Sheets Each.

Map No._____ Sec. 11 Twp. 26 R. 4

Well No. 27 Shumway Farm

Gypsy Company

NORTH

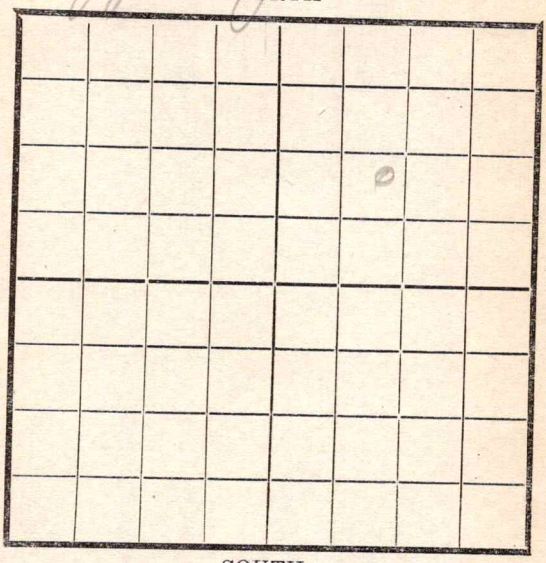

WEST

EAST

SOUTH

Location _____

Rig Up _____

Drilling and remarks

SD 9095

RECORD

Cased _____ in. _____ Ft.

Sand _____

Gas _____

Oil _____

Total Depth _____

PRODUCTION

1st 24 hrs. Nat. _____

1st 24 hrs. after shot _____

Gas _____ Cu. Ft.

Dry Hole _____

Abandoned _____

Date

3/13, 191__. P Cody Scout


Form 26—1M Books of 100 Sheets Each.

Map No. _____ Sec. 11 Twp. 26 R. 4

Well No. 37 Shumway Farm

Gypsy Company

NORTH

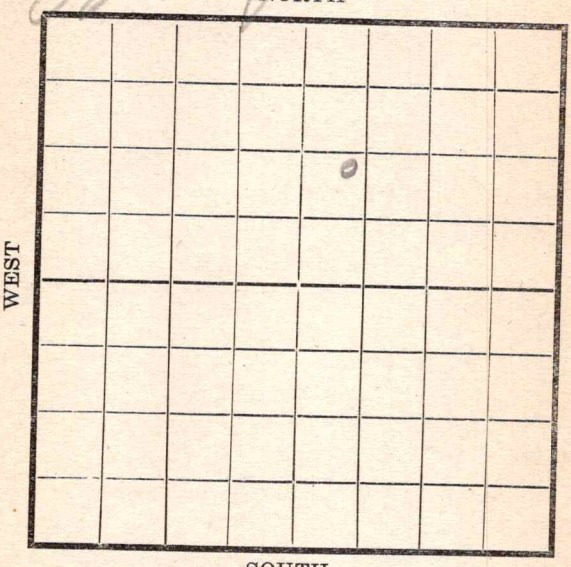

SOUTH

Location _____

Rig Up _____

Drilling and remarks

Wyoming

2343

RECORD

Cased _____ in. _____ Ft.

Sand _____

Gas _____

Oil _____

Total Depth _____

PRODUCTION

1st 24 hrs. Nat. _____

1st 24 hrs. after shot _____

Gas _____ Cu. Ft.

Dry Hole _____

Abandoned _____

Date

3/20, 191__. L Cady Scout


Form 26—1M Books of 100 Sheets Each.

Map No._____ Sec. 11 Twp. 26 R. 4

Well No. 27 Shumway Farm

Company

NORTH

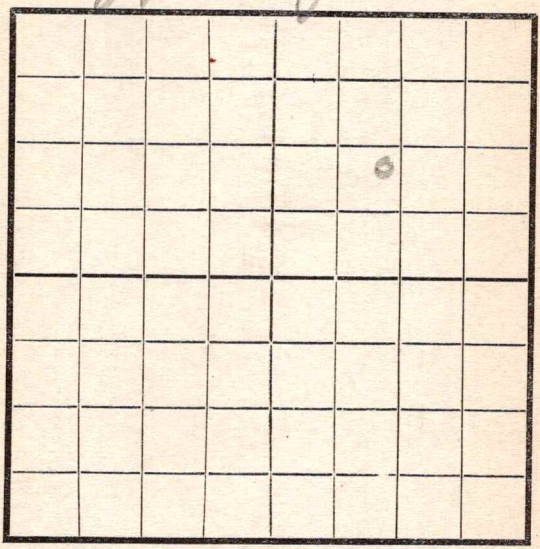

WEST

EAST

SOUTH

Location _____

Rig Up _____

Drilling and remarks

LD 2343

RECORD

Cased_____ in._____Ft.

Sand _____

Gas _____

Oil _____

Total Depth _____

PRODUCTION

1st 24 hrs. Nat._____

1st 24 hrs. after shot_____

Gas _____ Cu. Ft.

Dry Hole _____

Abandoned _____

Date

3/23, 191__. L Cady Scout

Form 0415—6-23-17—500Blks—Beacon 940

Map No. _____ Sec. 11 Twp. 26 R. 4

Well No. 27 Shumway

Gypsy _____ Company

NORTH

WEST

EAST

SOUTH

Location _____

Rig up _____

Drilling and Remarks:

LD 2343

RECORD

Cased _____ in., _____ ft.

Sand _____

Gas _____

Oil _____

Total Depth _____

PRODUCTION

1st 24 hrs. Nat. _____

1st 24 hrs. after shot _____

Gas _____ Cu. Ft.

Dry Hole _____

Abandoned _____

Date

APR 3 1918 191____.

_____ Scout


Form 26—1M Books of 100 Sheets Each.

Map No._____ Sec. 11 Twp. 26 R. 4

Well No. 27 Shumway Farm

Gypsy Company

NORTH

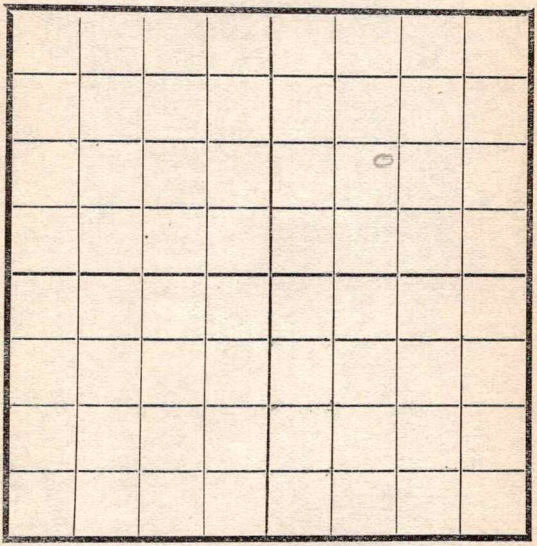

SOUTH

Location _____

Rig Up _____

Drilling and remarks

SD 2343

RECORD

Cased_____ in._____Ft.

Sand _____

Gas _____

Oil _____

Total Depth _____

PRODUCTION

1st 24 hrs. Nat._____

1st 24 hrs. after shot_____

Gas _____ Cu. Ft.

Dry Hole _____

Abandoned _____

Date

4/10, 191 8. _____Scout


Form 26—1M Books of 100 Sheets Each.

Map No. KF Sec. 11 Twp. 26 R. 4

Well No. 27 Shimmons Farm

Gypsy Company

NORTH

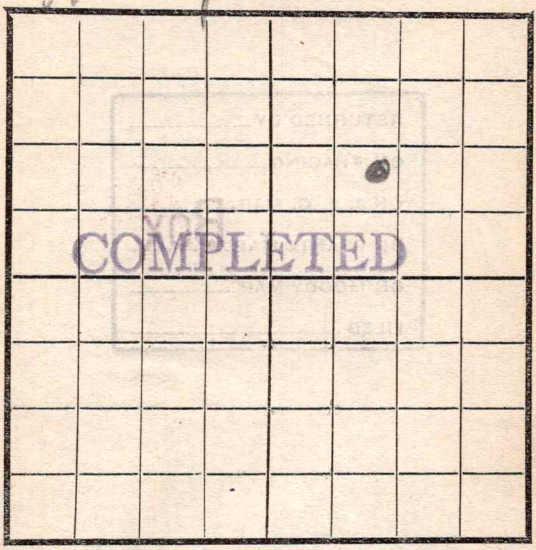

WEST EAST

SOUTH

Location

Rig Up

Drilling and remarks

Worked 2 hrs 24 hrs

RECORD

Cased in Ft.

Sand 2343

Gas 2368

Oil

Total Depth

PRODUCTION

1st 24 hrs. Nat.

1st 24 hrs. after shot

Gas Cu. Ft.

Dry Hole

Abandoned

Date

4/16, 191 8 Scout

Butler

FORM 26-250 BKS. 4-28 WESTERN

K14

MAP NO. KANSAS SEC. 11 TWP. 26S R. 4E


WELL NO. 2 A. J. Rumsey

Gypsy COMPANY

CONTRACTOR

ABANDONED

SECTION PLAT

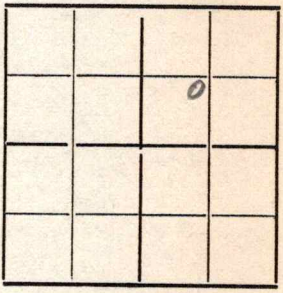

_____ FT. FROM N. LINE

_____ FT. FROM S. LINE

_____ FT. FROM E. LINE

_____ FT. FROM W. LINE

LOCATION

RIG UP

DRILLING AND REMARKS:

RECORD

CASED _____ IN., _____ FT.

SAND

GAS

OIL

TOTAL DEPTH 2715

PRODUCTION

1ST 24 HRS. NAT.

1ST 24 HRS. AFTER SHOT

GAS _____ CU. FT.

DRY HOLE

ABANDONED

DATE

12-8 1919

SCOUT

Form 26—1M—4-19—Mid-West

Map No. K14 Sec. 11 Twp. 26 R. 4


Well No. 27 Shumway

Gypsy Oil Company

Contractor

No card

SECTION PLAT

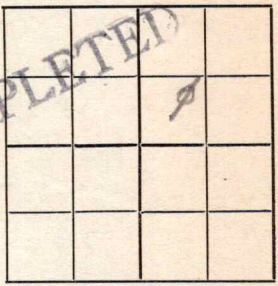

---Ft. from N. Line

1120 Ft. from S. Line

---Ft. from E. Line

1120 Ft. from W. Line

COMPLETED

Location ---

Rig up ---

Drilling and Remarks:

This is an old well drilled deeper

RECORD

Cased ---in., ---ft.

Sand ---

Gas ---

Oil ---

Total Depth ---

PRODUCTION

1st 24 hrs. Nat. ---

1st 24 hrs. after shot ---

Gas ---Cu. Ft.

Dry Hole 2790

Abandoned ---