

Greenwood
 Map No. **KANSAS** Sec. **21** Twp. **23** R. **11**
 Well No. **1 "C" - Edwards** Farm
Texas Co. Company

NORTH

WEST

EAST

					O		

SOUTH

Location.....

Drilling Remarks

.....

.....

RECORD

Cased..... in..... ft.

Sand.....

Gas.....

Oil.....

Total Depth.....

Rig Up.....

Drilling Remarks

.....

.....

PRODUCTION

1st 24 hrs. Nat.....

1st 24 hrs. after shot.....

Gas..... cu. ft.

Dry Hole.....

Abandoned.....


Map No. **KANSAS** Sec. **21** Twp. **23** R. **11**
Well No. **1-"C"** **Edwards** Farm
Texas Co Company

330 Ft. from N. Line

..... Ft. from S. Line

..... Ft. from E. Line

990 Ft. from W. Line

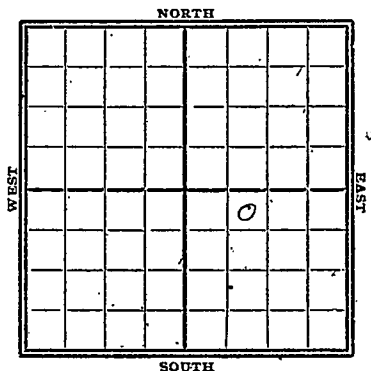

1928

Date	REPORT
11/14	Ro G.
11/21	Bldg Rig
11/28	Spdg.
12/5	Drly 400'
12/12	fs g 550'
12/19	
12/26	drly 1255'
1929	
1/2	sand 1860-98
	TD 1900'
	shot 90 gts
	100 bbls oil
	Somp.

K 16 KANSAS

MAP No. _____ SEC. 21 TWP. 23 R. 11


WELL No. "C" Edwards

Texas Co COMPANY

CONTRACTOR

FIRST REPORTS

SECTION PLAT

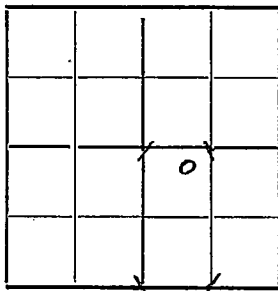

330 Ft. FROM N. LINE

_____ Ft. FROM S. LINE

_____ Ft. FROM E. LINE

990 Ft. FROM W. LINE

LOCATION No. 4

RIG UP

DRILLING AND REMARKS:

RECORD

CASED _____ IN. _____ FT.

SAND _____

GAS _____

OIL _____

TOTAL DEPTH _____

PRODUCTION

1ST 24 HRS. NAT. _____

1ST 24 HRS. AFTER SHOT _____

GAS _____ Cu. Ft.

DRY HOLE _____

ABANDONED _____

DATE

NOV 14 1928

CHAS. L. SHERWOOD

SCOUT

K16 KANSAS

Map No. _____ Sec. 21 Twp. 23 R. 11Well No. 1 "C" EdwardsTexas Co. _____ Company

_____ Contractor

COMPLETED

SECTION PLAT

330 Ft. from N. Line

_____ Ft. from S. Line

_____ Ft. from E. Line

990 Ft. from W. Line

		0	

Location _____

Rig up _____

Drilling and Remarks:

90/100 Bl.

RECORD

Cased _____ in., _____ ft.

Sand 1860-1898

Gas _____

Oil _____

Total Depth 1900'

PRODUCTION

1st 24 hrs. Nat. _____

1st 24 hrs. after shot _____

Gas _____ Cu. Ft.

Dry Hole _____

Abandoned _____

Date

JAN 2 1929

CHAS. L. SHERWOOD

192

Scout