


Map No. _____ Sec. 11 Twp. 26 R. 4
 Well No. 36 Shumway Farm _____
Gypsy Company _____
 NORTH

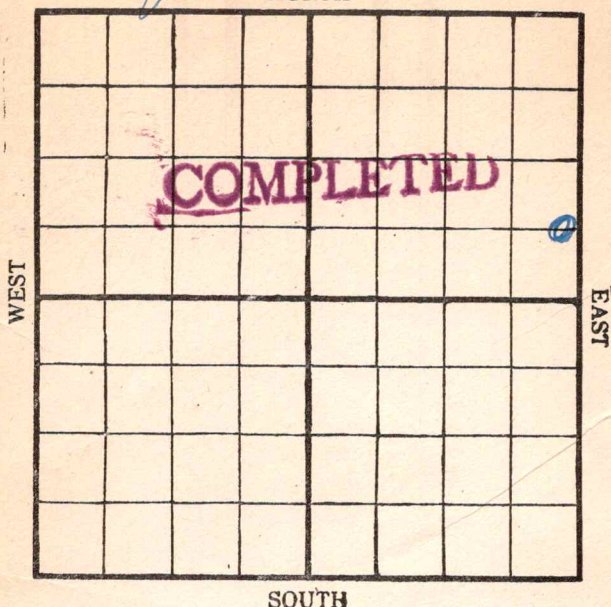

Location _____

Rig Up _____

Drilling Remarks:

Drilling Remarks:

RECORD

PRODUCTION

Cased _____ in. _____ ft.
 Sand _____
 Gas _____
 Oil _____
 Total Depth _____

1st 24 hrs. Nat. _____
 1st 24 hrs. after shot _____
 Gas _____ cu. ft.
 Dry Hole _____
 Abandoned _____

Map No. K14 Sec. 11 Twp. 26 R. 4Well No. 36 Shumway Farm
Gypsy Company

NORTH

WEST

EAST

SOUTH

Location -----

Rig Up -----

Drilling and remarks -----

RECORD

Cased ----- in. ----- Ft.

Sand -----

Gas -----

Oil -----

Total Depth -----

PRODUCTION

1st 24 hrs. Nat. -----

1st 24 hrs. after shot -----

Gas ----- Cu. Ft.

Dry Hole -----

Abandoned -----

Date

2/13, 1918 O. Condit Scout

Form 26—1M Books of 100 Sheets Each.

Map No. K14 Sec. 11 Twp. 26 R. 4

Well No. 36 Shumway Farm

Company

NORTH

WEST

EAST

SOUTH

Location -----

Rig Up -----

Drilling and remarks

205

McIntyre Drilling
El Dorado

RECORD

Cased ----- in. ----- Ft.

Sand -----

Gas -----

Oil -----

Total Depth -----

PRODUCTION

1st 24 hrs. Nat. -----

1st 24 hrs. after shot -----

Gas ----- Cu. Ft.

Dry Hole -----

Abandoned -----

Date

2/20, 1918


Scout

Map No. K14 Sec. 11 Twp. 36 R. 4
Well No. 36 Shumway Farm
Gypsy Company

NORTH

WEST

EAST

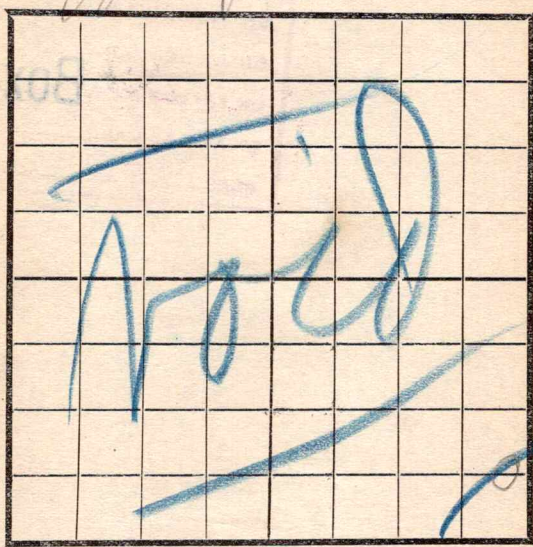

SOUTH

Location _____
Rig Up _____
Drilling and remarks _____

RECORD

Cased _____ in. _____ Ft.
Sand _____
Gas _____
Oil _____
Total Depth _____

PRODUCTION

1st 24 hrs. Nat. _____
1st 24 hrs. after shot _____
Gas _____ Cu. Ft.
Dry Hole _____
Abandoned _____


Date 2/28, 1918 Carley Scout

Map No. KH Sec. 11 Twp. 26 R. 4
 Well No. 36 Shumway Farm
Gypsy Company

NORTH

WEST

EAST

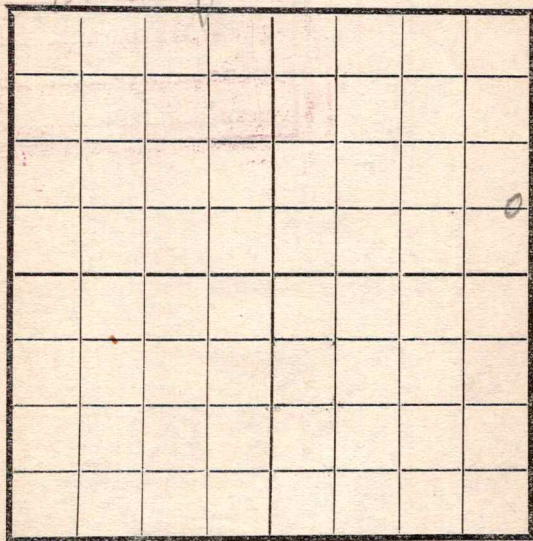

SOUTH

Location _____
 Rig Up _____
 Drilling and remarks _____

RECORD

Cased _____ in. _____ Ft.
 Sand _____
 Gas _____
 Oil _____
 Total Depth _____

PRODUCTION

1st 24 hrs. Nat. _____
 1st 24 hrs. after shot _____
 Gas _____ Cu. Ft.
 Dry Hole _____
 Abandoned _____

Corrected


Date

2/28, 1918 Candy Scout

Map No. K14 Sec. 11 Twp. 26 R. 4
 Well No. 36 Shumway Farm
Gypsy Company

NORTH

WEST

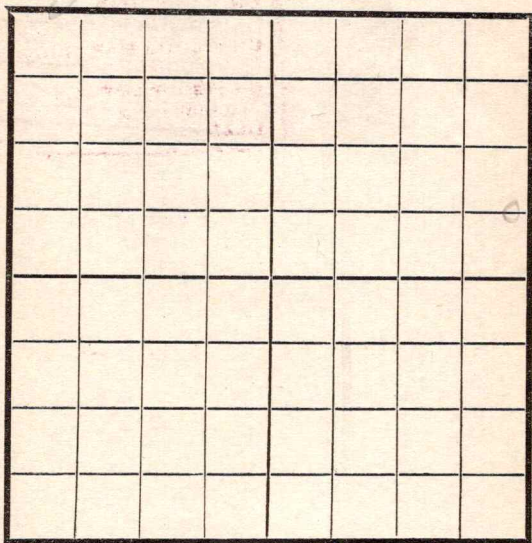

EAST

SOUTH

Location -----

Rig Up -----

Drilling and remarks

685

RECORD

Cased ----- in. ----- Ft.

Sand -----

Gas -----

Oil -----

Total Depth -----

PRODUCTION

1st 24 hrs. Nat. -----

1st 24 hrs. after shot -----

Gas ----- Cu. Ft.

Dry Hole -----

Abandoned -----

Date

7/27, 1918 S. Conkey Scout

Map No. TH Sec. 11 Twp. 26 R. 4


Well No. 36 Shimmerway Farm

Gypsy Company

NORTH

WEST

EAST

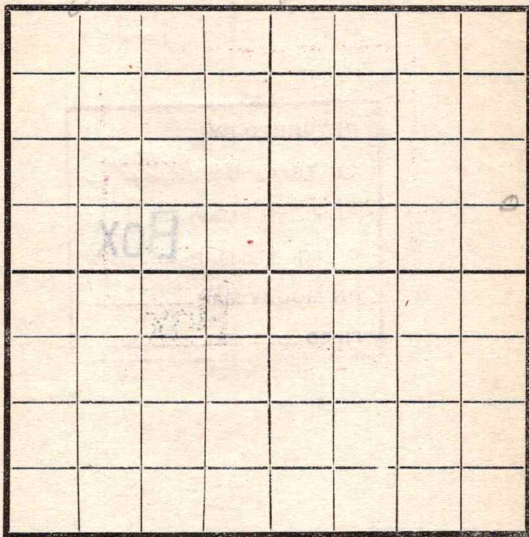

SOUTH

Location -----

Rig Up -----

Drilling and remarks

RECORD

Cased ----- in. ----- Ft.

Sand -----

Gas -----

Oil -----

Total Depth -----

PRODUCTION

1st 24 hrs. Nat. -----

1st 24 hrs. after shot -----

Gas ----- Cu. Ft.

Dry Hole -----

Abandoned -----

Date


3/6, 1918 S. Condy Scout

Map No. K14 Sec. 11 Twp. 26 R. 4

Well No. 36 Shumway Farm
Egypt Company

NORTH

WEST

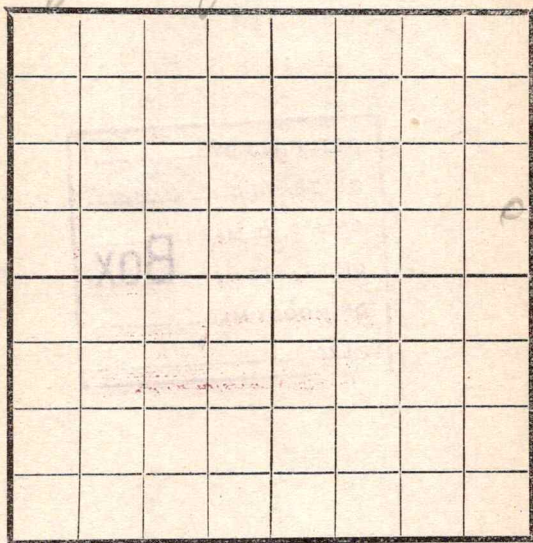

EAST

SOUTH

Location -----

Rig Up -----

Drilling and remarks

1180

RECORD

Cased ----- in. ----- Ft.

Sand -----

Gas -----

Oil -----

Total Depth -----

PRODUCTION

1st 24 hrs. Nat. -----

1st 24 hrs. after shot -----

Gas ----- Cu. Ft.

Dry Hole -----

Abandoned -----


Date

2/13, 1911 S. C. O'Leary Scout

Map No. K14 Sec. 11 Twp. 26 R. 4Well No. 36 Shumway FarmGypsy Company

NORTH

WEST

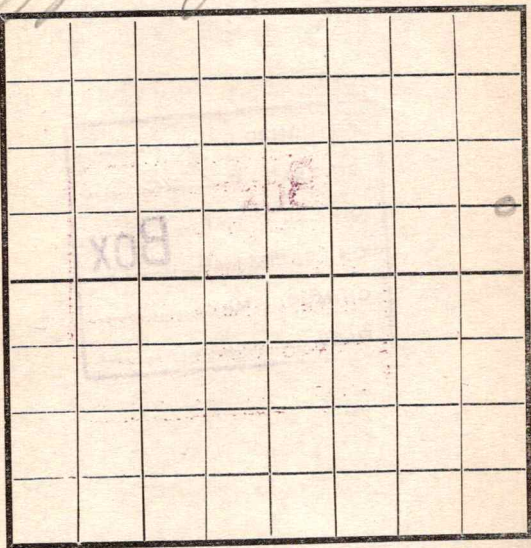

EAST

SOUTH

RECORD

Location -----

Cased ----- in. ----- Ft.

Rig Up -----

Sand -----

Drilling and remarks

Gas -----

Oil -----

Total Depth -----

PRODUCTION

1st 24 hrs. Nat. -----

1st 24 hrs. after shot -----

Gas ----- Cu. Ft.

Dry Hole -----

Abandoned -----

Date


3/20, 1911 J. C. Landry Scout

Map No. _____ Sec. 11 Twp. 26 R. 4

Well No. 36 Shumway Farm
Shumway Company

NORTH

WEST

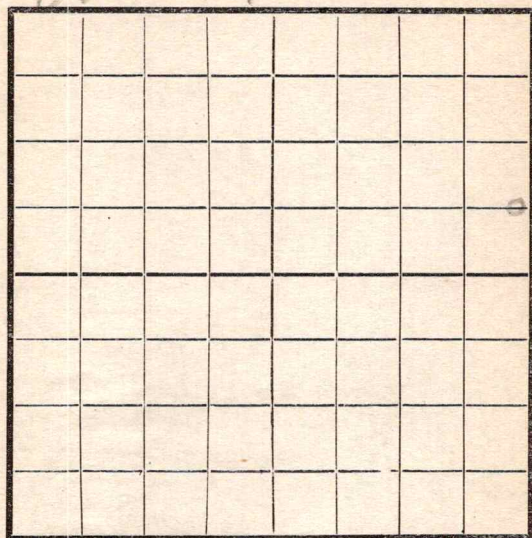

EAST

SOUTH

RECORD

Location _____

Cased _____ in. _____ Ft.

Rig Up _____

Sand _____

Drilling and remarks

Gas _____

Oil _____

Total Depth _____

2040

PRODUCTION

1st 24 hrs. Nat. _____

1st 24 hrs. after shot _____

Gas _____ Cu. Ft.

Dry Hole _____

Abandoned _____

Date

3/27, 1918 C. C. Cady Scout

Map No. _____ Sec. 11 Twp. 26 R. 4Well No. 36 Shumway
Gypsy Company

NORTH

WEST

EAST

SOUTH

Location _____

Rig up _____

Drilling and Remarks:

LD 2040

RECORD

Cased _____ in., _____ ft.

Sand _____

Gas _____

Oil _____

Total Depth _____

PRODUCTION

1st 24 hrs. Nat. _____

1st 24 hrs. after shot _____

Gas _____ Cu. Ft.

Dry Hole _____

Abandoned _____

Date


APR 3 1918

191

Cardiff

Scout

Map No. _____ Sec. 11 Twp. 26 R. 4
 Well No. 36 Shumway Farm _____
Gypsy Company _____
 NORTH

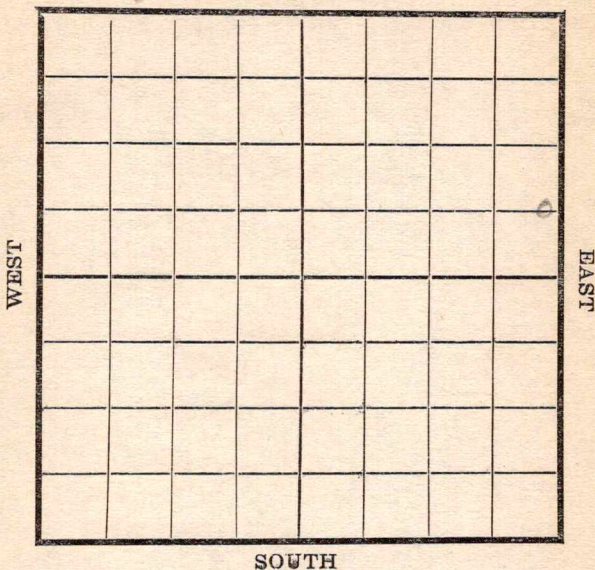

Location _____
 Rig Up _____
 Drilling and remarks

22 2335

RECORD

Cased _____ in. _____ Ft.
 Sand _____
 Gas _____
 Oil _____
 Total Depth _____

PRODUCTION

1st 24 hrs. Nat. _____
 1st 24 hrs. after shot _____
 Gas _____ Cu. Ft.
 Dry Hole _____
 Abandoned _____

Date

4/10, 1918 S. Conley Scout

Map No.----- Sec. 11 Twp. 26 R. 4


Well No. 36 Shumway Farm

Gypsum Company

NORTH

WEST

EAST

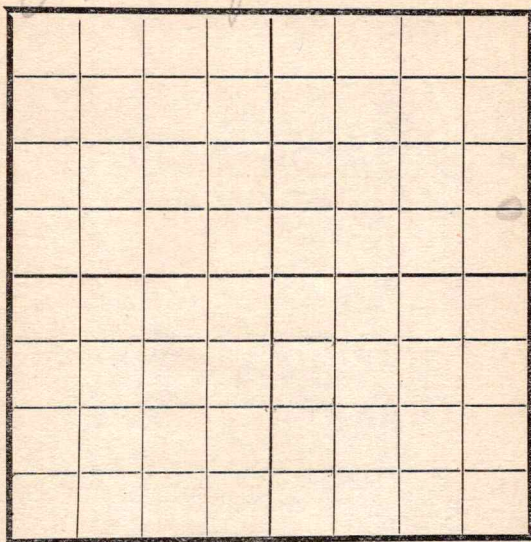

SOUTH

Location -----

Rig Up -----

Drilling and remarks

*Tap sand
2535*

RECORD

Cased ----- in. ----- Ft.

Sand -----

Gas -----

Oil -----

Total Depth -----

PRODUCTION

1st 24 hrs. Nat. -----

1st 24 hrs. after shot -----

Gas ----- Cu. Ft.

Dry Hole -----

Abandoned -----


Date

4/17, 1911 S. C. Sandberg Scout

Map No. 474 Sec. 11 Twp. 26 R. 4Well No. 36 Shumway FarmSupper Company

NORTH

WEST

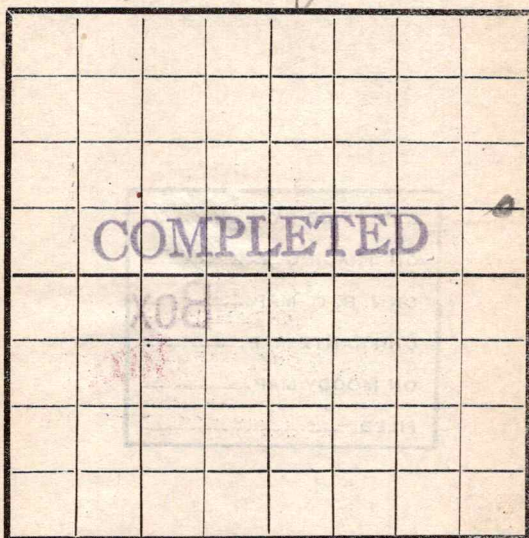

EAST

SOUTH

RECORD

Location -----

Cased ----- in ----- Ft.

Rig Up -----

Sand 2360-2398

Drilling and remarks

Gas -----

Oil -----

Total Depth -----

PRODUCTION

1st 24 hrs. Nat. -----

1st 24 hrs. after shot -----

Gas ----- Cu. Ft.

Dry Hole -----

Abandoned -----


Date

4/24 8 Cord 191 Scout

Map No. K14 Sec. 11 Twp. 26 R. 4

Well No. _____ Farm _____
 _____ Company _____

NORTH

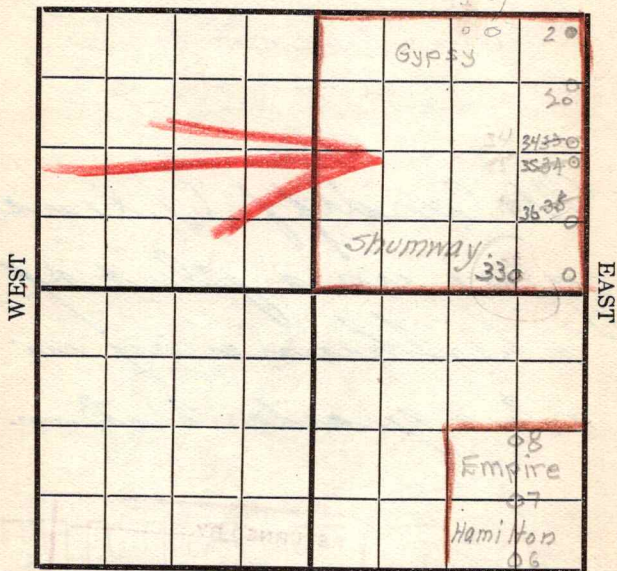

SOUTH

Location _____
 Rig Up _____
 Drilling and remarks _____

RECORD

Cased _____ in. _____ Ft.
 Sand _____
 Gas _____
 Oil _____
 Total Depth _____

PRODUCTION

1st 24 hrs. Nat. _____
 1st 24 hrs. after shot _____
 Gas _____ Cu. Ft.
 Dry Hole _____
 Abandoned _____

Date _____

_____, 191____ Scout _____

Our map shows
as this Ticket.
Please check up
this location.

Mr Cardiff Please
give us a plat of
the Shumway in
this quarter section.

RETURNED BY	_____
ON TRACING	_____ <i>JRM</i>
ON J. S. C. MAP	_____
ON FRANTZ MAP	_____ Box
ON MOODY MAP	_____
FILED	_____