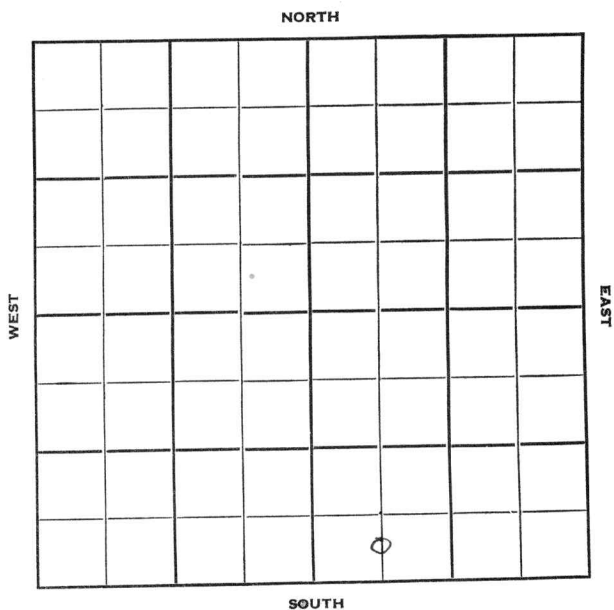


Section 12 Township 26 Range 4EWell No. #2 FowlerCompany Gross Drlg.

Butler

Sec. 12 Twp. 26 R. 4E

Well No. #2 Fowler Farm

Gross Drlg. Company

Martin & Cash - Contr. Contractor


El Dorado Pool

 Ft. from N. Line

400' Ft. from S. Line

 Ft. from E. Line

540' Ft. from W. Line

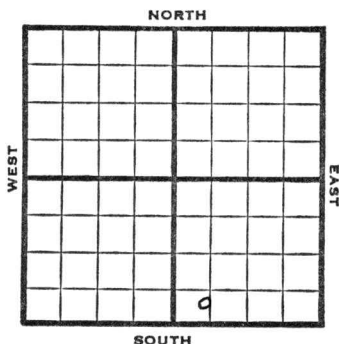

C S L SW SE

1951 Elev. 1373' REPORT

9/5 Spud 8-30-51
8" @ 45
Drlg. 2196'

1952
1/2 Spud 8-30-51
Oil well TD 2488' 8" @ 45'
Simp. 2446-65' 5" @ 2453'
TD 2488'
Comp. 20 BOPD & water.

COMPLETED

County Butler State KansasSec. 12 (Blk. Twp.) 26 (Sur. Rge.) 4E Map No.Operator Gross Drlg.Well No. 2 Farm FowlerElev. Location C S L SW SE400 Ft. From S Line SE540 Ft. From W Line Quarter1st. Report SEP 5 1951


Completion

Remarks

Martin & Cash - Contr.Spudding Date 8-30-51Drlg. Data Eldorado Pool8" @ 45 drlg. 2196

J. E. TYRA

County Butler State Kansas
 Sec. 12 (Blk. 26 (Sur. 4E Map No.
 Twp.) Rge.)
 Operator Gross D. lg.
 Well No. 2 Farm Fowler
 Elev. 1373 Location C S L SW SE

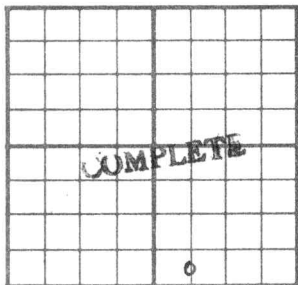

400 Ft. From S Line SE

540 Ft. From W Line Quarter

1st. Report

Completion JAN 2 1952

Remarks Eldorado Pool

Martin & Cash - Contr.

Spudding Date 8-30-51

Drlg. Data Oil well TD 2488

8" @ 45 Simp. 2446-65 5" @ 2453

TD 2488 Comp. 20 bopd & water

J. E. TYRA