

NORTH

					0		

SOUTH

Drilling Remarks

Drilling Remarks

RECORD

Total Depth.....

PRODUCTION

Abandoned.....

Map No. KANSAS Sec. 21 Twp. 23 R. 11
 Well No. 6 "C" Edwards Farm
Texas Co. Company


..... Ft. from N. Line

990 Ft. from S. Line

..... Ft. from E. Line

990 Ft. from W. Line

1929

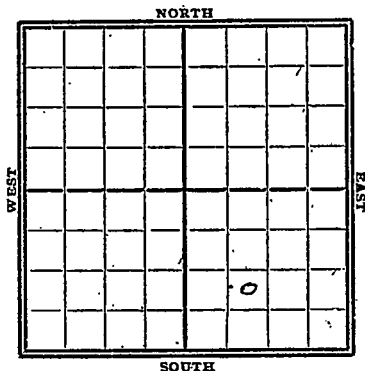

Date

REPORT

6/12	Location
6/19	Regr. up.
6/26	Spdg 215'
7/2	Ordy 800'
7/10	" 1360'
7/17	" 1750'
7/24	sand 1885-1978
	TD 1978'
	shot 260 gtr
	665 bbl oil
	Sump.

Greenwood

16 **KANSAS** Sec. 21 Twp. 23 R. 11
 Map No. _____
 Well No. 6 "C" Edwards
 Texas Co. _____ Company

Contractor

FIRST REPORTS

SECTION PLAT

_____ Ft. from N. Line

990 Ft. from S. Line

_____ Ft. from E. Line

990 Ft. from W. Line

		o	

Location _____ ✓

Rig up _____

Drilling and Remarks: _____

RECORD

Cased _____ in., _____ ft.

Sand _____

Gas _____

Oil _____

Total Depth _____

PRODUCTION

1st 24 hrs. Nat. _____

1st 24 hrs. after shot _____

Gas _____ Cu. Ft.

Dry Hole _____

Abandoned _____

Date

JUN 12 1929

192

CHAS. L. SHERWOOD

Scout

Greenwood
 Map No. **16 KANSAS** Sec. **21** Twp. **23** R. **11**
 Well No. **6 "C" Edwards**
Texas Co Company _____ Contractor _____

COMPLETE

SECTION PLAT

_____ Ft. from N. Line

990 Ft. from S. Line

_____ Ft. from E. Line

990 Ft. from W. Line

		0	

Location _____

Rig up _____

Drilling and Remarks: _____

RECORD

Cased _____ in.

Sand 1885-1978

Gas _____

Oil _____

Total Depth 1978

PRODUCTION

1st 24 hrs. Nat. _____

1st 24 hrs. after shot _____

Gas _____ Cu.

Dry Hole _____

Abandoned _____

860 / 665 - lbs.

Date

JUL 24 1929

19

CHAS. L. SHERWOOD

Se