


Ellis
 Baumer
 Deep Rock Oil Co.
 County _____ No. 6
 Farm _____ Company _____

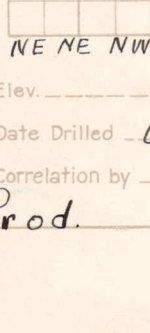

Twp.

6	5	4	3	2	1
7	8	9	10	11	12
13	14	15	16	17	18
19	20	21	22	23	24
25	26	27	28	29	30
31	32	33	34	35	36

Elev. _____ T.D. 3491'
 Date Drilled 6-21-37
 Correlation by _____
 Prod. _____ Pot 29920

