


Map No. KANSAS Sec. 22 Twp. 23 R. 11^E
Well No. 1- Patterson Farm
Phillips Pet Company

NORTH

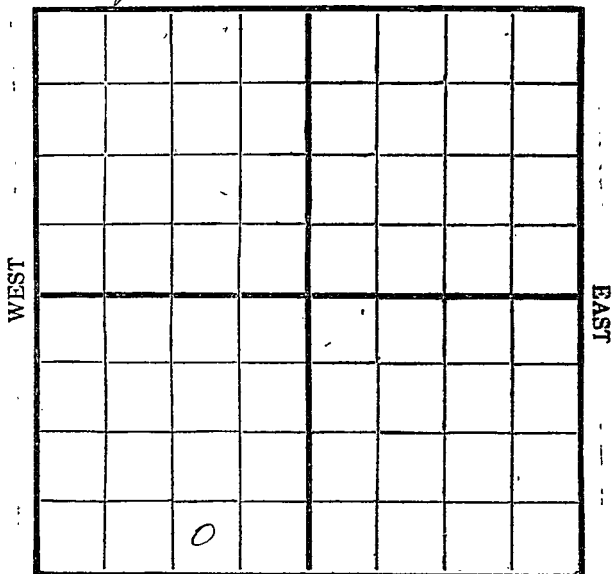

SOUTH

Location _____
Drilling Remarks _____

RECORD

Cased _____ in. _____ ft.
Sand _____
Gas _____
Oil _____
Total Depth _____

Rig Up _____
Drilling Remarks _____

PRODUCTION

1st 24 hrs. Nat. _____
1st 24 hrs. after shot _____
Gas _____ cu. ft. _____
Dry Hole _____
Abandoned _____


Map No. KANSAS Sec. 22 Twp. 23 R. 11^E
Well No. 1- Patterson Farm
Phillips Pet Company

 Ft. from N. Line

330 Ft. from S. Line

940 Ft. from E. Line

 Ft. from W. Line

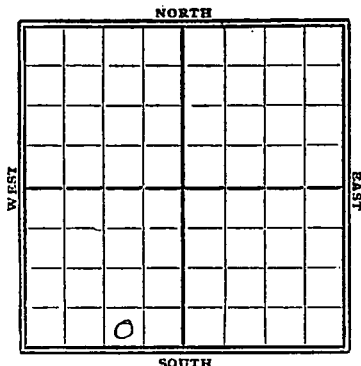

1929

Date

REPORT

11/30	Location.
11/27	Wagon up
12/4	Weld 425'
12/11	" 1040'
12/23	sand 1917-79'
	T.D. 1981'
	shot 190 at
	142 bbls oil
	Sump

*Greenwood*Map No. **KANSAS** Sec. *22* Twp. *23* R. *11E*Well No. *1 Patterson**Phillips Pet.* Company

Contractor

SECTION PLAT

.....Ft. from N. Line

330 Ft. from S. Line*990* Ft. from E. Line

.....Ft. from W. Line

FIRST REPORT

Location *✓*

Rig up.....

Drilling and Remarks:

RECORD

Cased.....in.,ft.

Sand.....

Gas.....

Oil.....

Total Depth.....

PRODUCTION

1st 24 hrs. Nat.....

1st 24 hrs. after shot.....

Gas.....Cu. Ft.

Dry Hole.....

Abandoned.....

Date

NOV 20 1929

192

CHAS. L. SHERWOOD

Scout

Greenwood

Map No. **KANSAS** Sec. *22* Twp. *23* R. *11*
 Well No. *1 Patterson*
Phillips Pet Co Company
 Contractor

COMPLETE

.....Ft. from N. Line
330 Ft. from S. Line
990 Ft. from E. Line
Ft. from W. Line

SECTION PLAT

	0		

Location.....
 Rig-up.....
 Drilling and Remarks:

190/142 Bbs.

RECORD

Cased.....in.,ft.
 Sand *1917-1979*
 Gas.....
 Oil.....
 Total Depth *1981'*

PRODUCTION

1st 24 hrs. Nat.....
 1st 24 hrs. after shot.....
 Gas.....Cu. Ft.
 Dry Hole.....
 Abandoned.....

Date
DEC 23 1929

CHAS. L. SHERWOOD

.....192.....Scout