


Section 22 Township 23 Range 11 E

Well No. #1 Rice

Company A. W. Bennett

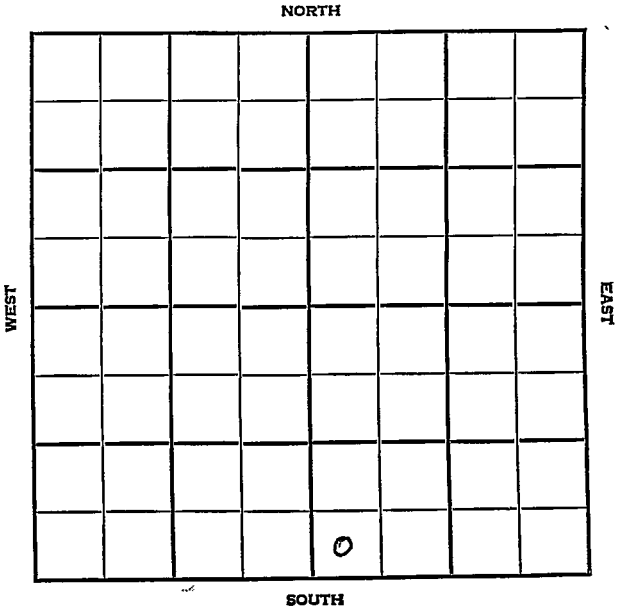

SEC.	TWP.	R.
22	23	11E

WELL NO.

#1 Rice

FARM

COMPANY

A.W. Bennett

CONTRACTOR

Jackman & Jackman

Seely-Wick


_____ Ft. from N. Line

_____ Ft. from S. Line

_____ Ft. from E. Line

_____ Ft. from W. Line

SW SW SE

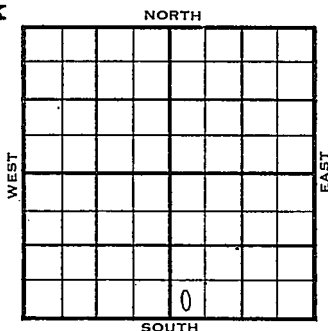

1956

ELEVATION

REPORT

2-15

Comm. 2-4-56

8" @ 50

TD 1969

5 1/2 @ 1967

Bart 1967

4-25

DD 1984

PB 1981, frac

DD 2010

PB 1973, frac

Comp. 4 bopd, 15 bw

TD 1969'

COMPLETED

County Greenwood Elev. _____
 Sec. 22 Twp. 23 Rge. 11E
 Company A. W. Bennett
 Farm Name Rice No. 1

TOPS	DEPTH	LOG	DATUM	Loc. in Sec.
Anh.				SW SW SE
Tr.				
H.				
Tr.				
Dg.				
Bl.				
L.				Geol. _____
K.C.				Contr. _____
B.K.C.				
Ce.				Jackman &
C.				Jackman
M.	Part.	1967		Pool
M.				Seely-Wick
K.				
Mz.				
Me.				
V.				
S.				
S.				
A.				
R.				
Pe.				
G.				
TD.	1969			

FEB	15	55
FIRST REPORT		

Date Comm. 2-4-56
8" @ 50 TD 1969 5" @ 1967

[Handwritten signature]

O.W.W.O.

County Greenwood Elev. 11E
 Sec. 22 Twp. 23N Rge. 11E
 Company A. W. Bennett
 Farm Name Rice No. 1

TOPS	DEPTH	LOG	DATUM	Loc. in Sec.
Anh.				SW SW SE
Tp.				
H.				
Tr.				
Dg.				
Bl.				
L.				Geol.
K.C.				Contr.
B.K.C.				Jackman &
Ce.				Jackman.
C.				Pool
M. <u>Bart</u>	<u>1967</u>			Seely-Wick
M.				
K.				
Mz.				
Ma.				
V.				
S.				
S.				
A.				
R.				
Pe.				
G.				
TD.	<u>1969</u>			

COMPLETE

Date Comm. 2-4-56 APR. 25 1956

8" @ 50 TD 1969 5" @ 1967

DD 1984 PB 1981 frac DD 2010

PB 1973 frac Comp. 4 bopd 15 bw