
Form 51 5M 8-24 16567

Map No. Kansas Sec. 26 Twp. 23 R. 11

Well No. 1 Ellis Farm

Saule & Son Company

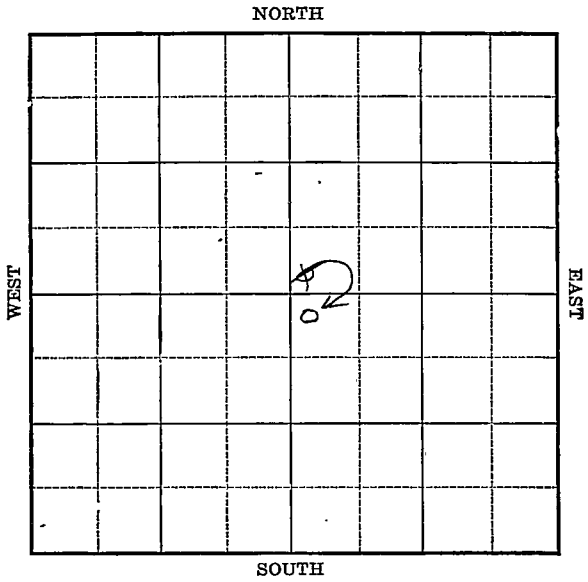

Location

Drilling Remarks

Rig Up

Drilling Remarks

RECORD

Cased in. ft.

Sand

Gas

Oil

Total Depth

PRODUCTION

1st 24 hrs. Nat.

1st. 24 hrs. after shot

Gas cu. ft.

Dry Hole

Abandoned

Form 252A 5M 2-24 15129

Map No. K Sec. 26 Twp. 23 R. 11 E

Well No. #1 Ellis Farm

Sauls & Son Company


Simmons Est.

200 Ft. from N. Line

~~2700~~ Ft. from S. Line

____ Ft. from E. Line

200 Ft. from W. Line

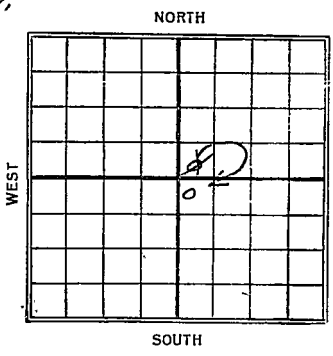

offset

Date 1924	REPORT
11/19	Rig
12/17	set 10" 1144 - S.D. Indef.
1925	
1/21	Dlg 1750'
2/13	1917-1932 Shot 40 qts
	Pumping 25 Bbls (Tel)
3/17	Top 1917 8" 1918
	1932-52 Plug back
	to 1947 Shot 80 qts
	1974-45 300 Bbls 24 hrs
	41 Gravity (Tel)

Form 26—M Bks.—3-23—11959.

Map No. (16) KANSAS Sec. 26 Twp. 23 R. 11 E


Well No. #1 E Ellis

Sauls & Son Company

Contractor

FIRST REPORT

SECTION PLAT

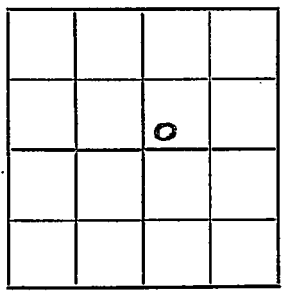

_____Ft. from N. Line

200 Ft. from S. Line

_____Ft. from E. Line

200 Ft. from W. Line

Location _____

Rig up _____

Drilling and Remarks:

Rig

RECORD

Cased _____ in., _____ ft.

Sand _____

Gas _____

Oil _____

Total Depth _____

PRODUCTION

1st 24 hrs. Nat. _____

1st 24 hrs. after shot _____

Gas _____ Cu. Ft.

Dry Hole _____

Abandoned _____

Date

NOV 10 1924

_____ 192____.

M. A. BENEAR

_____ Scout

Form 26—1M Bks.—3-23—11959.

Map No. _____ Sec. 26 Twp. 23 R. 11

Well No. 1 E Ellis

Sauls & Son Company

_____ Contractor


COMPLETED SECTION PLAT

200 Ft. from N. Line

_____ Ft. from S. Line

_____ Ft. from E. Line

200 Ft. from W. Line

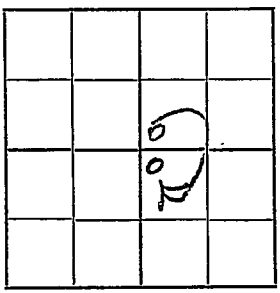

Location _____

Rig up _____

Drilling and Remarks:

sand 1917-32
T.D. 1952
P.B. 1957
80/ Swabbing

RECORD

Cased _____ in., _____ ft.

Sand _____

Gas _____

Oil _____

Total Depth _____

PRODUCTION

1st 24 hrs. Nat. _____

1st 24 hrs. after shot _____

Gas _____ Cu. Ft.

Dry Hole _____

Abandoned _____

Date 20 to 25 bbls

3/1 1925

M. A. BENEAR Scout