
Greenwood KANSAS

SECTION 22 TOWNSHIP 23S RANGE 11E

WELL NO. #2 Rice

COMPANY A.W. Bennett

NORTH SE SW SE

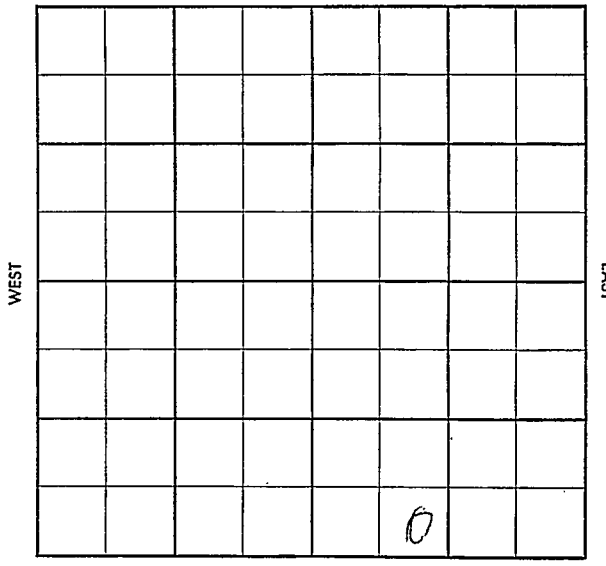

FORM 504-3 SUNRAY

S-513-B

County Greenwood Elev.

Sec. 22 Twp. 23 Rge. 11E

Company A. W. Bennett

Farm Name Rice No. 2


TOPS	DEPTH	LOG	DATUM
Anh.			
Tp.			
H.			
Tr.			
Dg.			
B.L.			
L.			
K.C.			
B.K.C.			
Ce.			
C.			
M.			
M.			
K.			
Mz.			
Mq.			
V.			
S.			
S.			
A.			
R.			
Pf.			
G.			
T.D.			

Loc. in Sec. App SE SW SE

Geol.

Contr. Eureka Drlg.

Pool Seeley-Wick

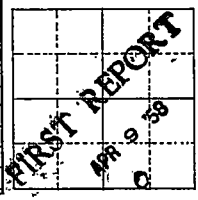

Date Comm. 4/5/58

7" @ 130, Drlg. 1558.

Co. Lse. No. Sec. T. R.

Twp. X Pool

Co. X Field

S-513-B

County Greenwood Elev.

Sec. 22 Twp. 23 Rge. 11E

Company A. W. Bennett

Farm Name Rice No. 2

TOPS	DEPTH	LOG	DATUM
Anh.			
Tp.			
H.			
Tr.			
Dg.			
B. L.			
L. Stv Sd	1904		
K.C.			
B.K.C.			
Ce.			
C.			
M.			
M.			
K.			
Mz.			
Mq.			
V.			
S.			
S.			
A.			
R.			
Pf.			
G.			
T.D.	1975		

Loc. in Sec. App SE SW SE

Geol.

Contr. Eureka Drlg.

Pool Seeley-Wick

MAY 7 '58

ABANDONED

0

Date Comm. 4/5/58

7" @ 130, Drlg. 1558. APR 16 '58 APR 23 '58 APR 30 '58

MAY 7 '58 cmd 1904-75 fm sd

D&A

Co. Lse. No. Sec. T. R.