


Section 12 Township 26 Range 4E

Well No. #3 Hoyt

Company Gross Supply

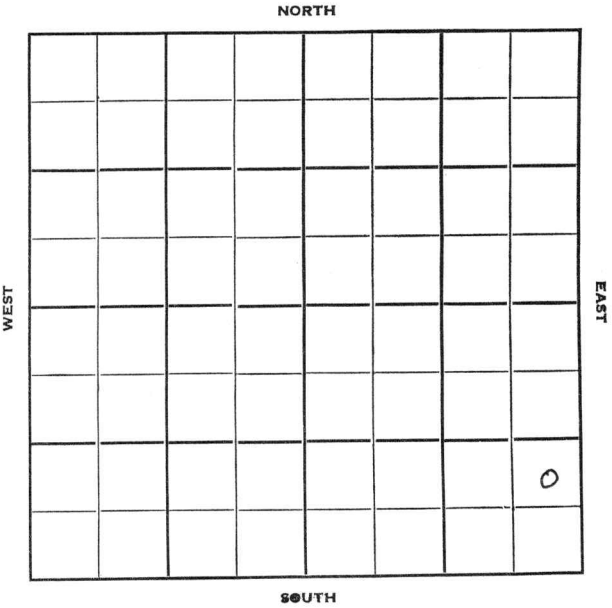

Butler **KANSAS**

Sec. 12 Twp. 26 R. 4E

Well No. #3 Hoyt Farm

Gross Supply Company

Martin & Cash - Contr. Contractor


 Ft. from N. Line

990' Ft. from S. Line

330' Ft. from E. Line

 Ft. from W. Line

NE SE SE

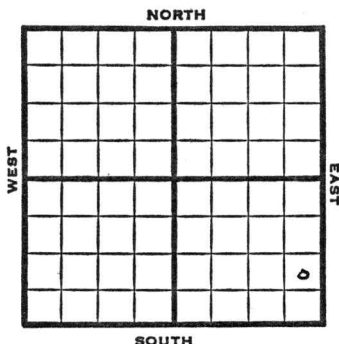

1951

REPORT
Elev. 1371'

5/2 Pits

6/6 Oil well TD 1690'
Lans 1644' 4" @ 1653' TD 1690'
B/15 BOPH 2000 A P/20 BOPD Comp.

COMPLETED

County **Butler** State **Kansas**Sec. **12** (Blk. Twp.) **26** (Sur. Rge.) **4E** Map No.Operator **Gross Supply**Well No. **3** Farm **Hoyt**Elev. Location **NE SE SE**

FIRST REPORT

0

990 Ft. From **S** Line **SE**330 Ft. From **E** Line Quarter1st. Report **MAY 2 1951**

Completion

Remarks


Martin & Cash - Contr.

Spudding Date

Drlg. Data

Pits

J. E. TYRA

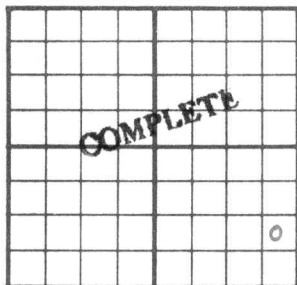County Butler State KansasSec. 12 (Blk.
Twp.) 26 (Sur.
Rge.) 4E Map No.Operator Gross SupplyWell No. 3 Farm HoytElev. 1371 Location NE SE SE990 Ft. From S Line SE330 Ft. From E Line Quarter1st. ReportCompletion JUN 6 1951RemarksMartin & Cash - Contr.Spudding DateDrlg. Data Oil well TD 1690Lans. 1644 4" @ 1653 TD 1690B/ 15 boph 2000 A P/ 20 bopd Comp.

J. E. TYRA