
DX 78-1 Greenwood **KANSAS**

Section 27 Township 23 Range 11E

Well No. #21 Ellis

Company George Sheehan

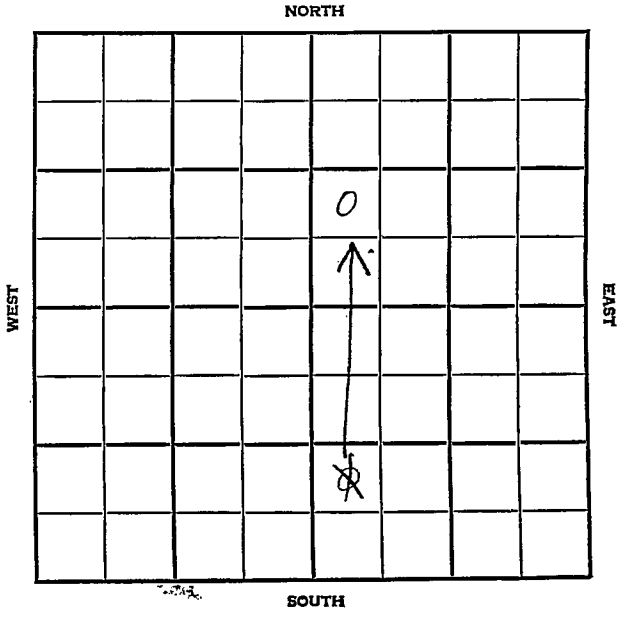

Greenwood KANSAS;

SEC.	TWP.	R.
27	23	11E

WELL NO.


#21 Ellis FARM

COMPANY

George Sheehan

CONTRACTOR

Jackman & Jackman
Seeley-Wick

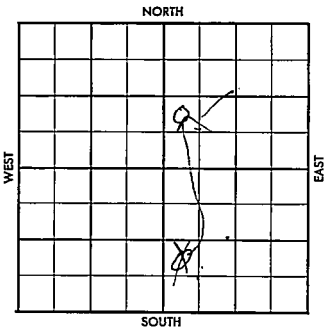

_____ FT. FROM N. LINE

_____ FT. FROM S. LINE

_____ FT. FROM E. LINE

_____ FT. FROM W. LINE

NW SW SE NE

	ELEVATION	
1956	1108' Gr.	REPORT
8-8	Comm. 8-1-56 8" @ 83 w/75 5" @ 1898 WOC TD 1917'	
8-15	DD 1938 Frac 20 x 10 P/ 176.1 BOPD, no/wtr. P/ 25 bopd, no/wtr. Bartl. 1894'; TD 1917'	

COMPLETED

FORM 513 SUNRAY

County Greenwood Elev.

Sec. 27 Twp. 23 Rge. 17E

Company George Sheehan

Farm Name Ellis No. 21

TOPS	DEPTH	LOG	DATUM
Anh.			
Tp.			
H.			
Tr.			
Dg.			
Bl.			
L.			
K.C.			
B.K.C.			
Ce.			
C.			
M.			
M.			
K.			
Mz.			
Mq.			
V.			
S.			
S.			
A			
R.			
P€.			
G.			
T.D.	1917		

Loc. in Sec. NW SW SE

Geol.

Contr. Jackman & Jackman

Pool Seeley-Wick

FIRST REPORT

Date Comm. 8-1-56

AUG 8 '56

8" @ 83/75 5" @ 1898 WOC

AUG 1 5 1956

CORRECTION

FORM 513 SUNRAY

County Greenwood Elev. 1108 gr.

Sec. 27 Twp. 28 Rge. 11E

Company George Sheehan

Farm Name Ellis No. 21


TOPS	DEPTH	LOG	DATUM
Anh.			
Tp.			
H.			
Tr.			
Dg.			
Bl. Bartl	1894		
L.			
K.C.			
B.K.C.			
Ce.			
C.			
M.			
M.			
K.			
Mz.			
Mo.			
V.			
S.			
S.			
A			
R.			
P€.			
G.			
T.D.	1917		

Loc. in Sec. NW SW ~~SE~~ NE

Geol.

Contr. Jackman & Jackman

Pool Seeley-Wick

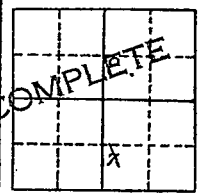

Date Comm. 8-1-56

AUG 15 '56

8" @ 83/75 5" @ 1898 WOC.

AUG 15 '56 DD 1938 TD Frac

20 x 10 P. 176.1 Bbls

No/w P 25 Bbls no/w

Co. Lse. No. Sec. T. R.