


Greenwood

KANSAS

SECTION 27 TOWNSHIP 23 RANGE 11E

WELL NO. #22 Ellis

COMPANY Geo. Sheehan

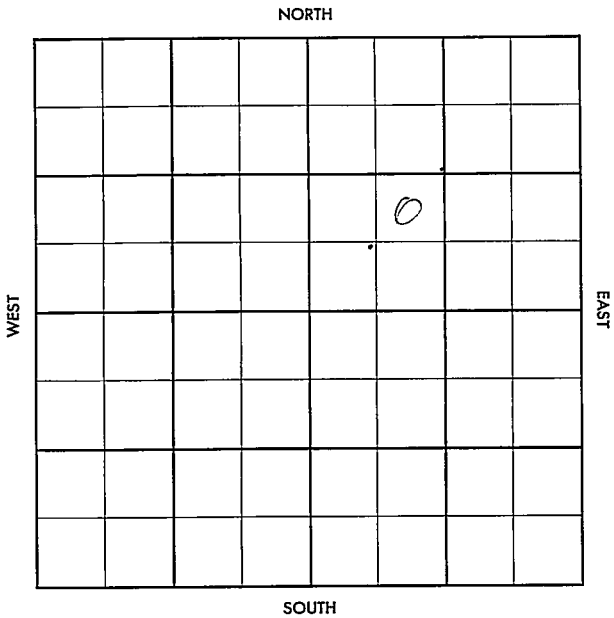

County Greenwood Elev. _____
 Sec. 27 Twp. 23 Rge. 11E
 Company Geo. Sheehan
 Farm Name Ellis No. 22

TOPS	DEPTH	LOG	DATUM	Loc. in Sec.
Ank.				NE SW NE
Tr.				
H.				
Tr.				
Dg.				
BL. <u>DTVL SD</u>	<u>1919</u>			
L.				Geol.
K.C.				Contr.
B.K.C.				Jackman & Jack
Ce.				man Tools
C.				Pool
M.				Seeley-Rick
M.				
K.				
Mz.				
Mo.				
V.				
S.				
S.				
A.				
R.				
Pe.				
G.				
TD.	<u>1921</u>			

COMPLETE

Date Comm. 9-29-56

8" @ 87, 5" @ 1920r 56

CO DD 1959

TD sd from 1919-54 PB

1954 Frac P. 1-10 B0

Flw 50 B0 in 8 hrs Tr. wt

P. 25 B0pd no wtr.

County Greenwood Elev. _____
Sec. 27 Twp. 23 Rge. 11E
Company Geo. Sheehan
FarmName Ellis No. 22

TOPS	DEPTH	LOG	DATUM	Loc. in Sec.
Anh.				NE SW NE
Tp.				
H.				
Tr.				
Dg.				
Bl. <u>btvl sd</u>	<u>1919</u>			
L.				Geol. _____
K.C.				Contr. _____
B.K.C.				Jackman & Jack
Ce.				man Tools
C.				Pool
M.				Seeley-Wick
M.				
K.				
Mz.				
Mq.				
V.				
S.				
S.				
A.				
R.				
PE.				
G.				
T.D.	<u>1921</u>			

Date Comm. 9-29-56 FIRST REPORT
8" @ 87, 5" @ 1920 OCT 10 '56

8001 # 5 100

R.G.