


Map No. _____ Sec. 17 Twp. 26 R. 4
 Well No. 37 Empire Farm _____
 _____ Company

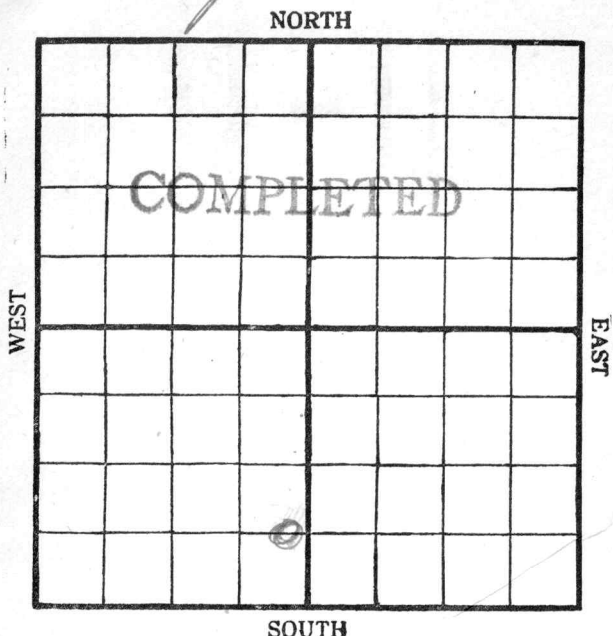

Location _____

Rig Up _____

Drilling Remarks:

Drilling Remarks:

200 Bore (Long 2260-2408)

6/12/18

RECORD

PRODUCTION

Cased _____ in. _____ ft.

1st 24 hrs. Nat. _____

Sand _____

1st 24 hrs. after shot _____

Gas _____

Gas _____ cu. ft.

Oil _____

Dry Hole _____

Total Depth _____

Abandoned _____

Map No. 14 Sec. 13 Twp. 26 R. 4Well No. 37 FarmCompany Company

NORTH

WEST

EAST

SOUTH

Location ✓Rig Up ✓

Drilling and remarks

FIRST REPORT

RECORD

Cased _____ in. _____ Ft.

Sand _____

Gas _____

Oil _____

Total Depth _____

PRODUCTION

1st 24 hrs. Nat. _____

1st 24 hrs. after shot _____

Gas _____ Cu. Ft.

Dry Hole _____

Abandoned _____

Date


4/24, 1918 S. Candy Scout

Map No. _____ Sec. 12 Twp. 26 R. 4Well No. 37 _____ Farm _____

Company _____

NORTH

WEST

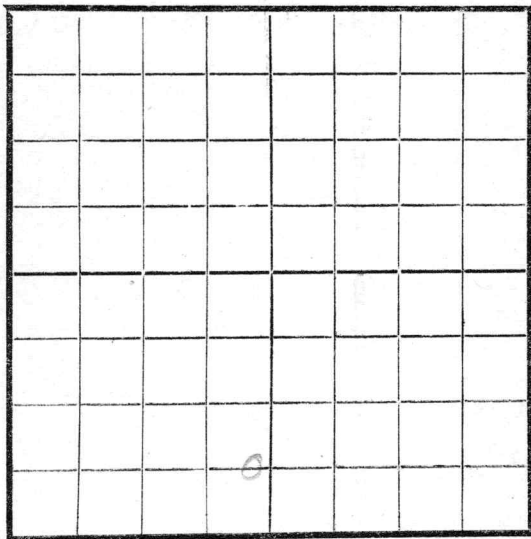

EAST

SOUTH

Location _____

Rig Up _____

Drilling and remarks

500
Weekly
Drilling Co
E. L. Donado Co

RECORD

Cased _____ in _____ Ft

Sand _____

Gas _____

Oil _____

Total Depth _____

PRODUCTION

1st 24 hrs. Nat. _____

1st 24 hrs. after shot _____

Gas _____ Cu. Ft.

Dry Hole _____

Abandoned _____

Date

5/1

191


J. C. Condy

Scout

Map No. _____ Sec. 12 Twp. 26 R. 4
Well No. 37 Canyon Farm _____
Canyon Company _____

NORTH

WEST

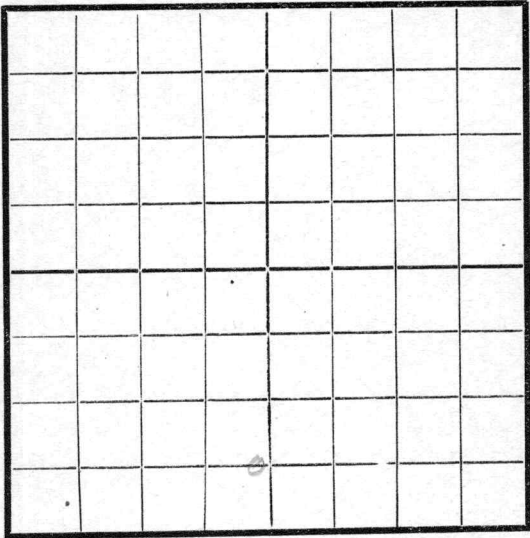

EAST

SOUTH

RECORD

Location _____
Rig Up _____
Drilling and remarks

Cased _____ in. _____ Ft.
Sand _____
Gas _____
Oil _____
Total Depth _____

840

PRODUCTION

1st 24 hrs. Nat. _____
1st 24 hrs. after shot _____
Gas _____ Cu. Ft.
Dry Hole _____
Abandoned _____


Date

5/8, 1918 S. Canyon Scout

Map No. _____ Sec. 12 Twp. 26 R. 4
 Well No. 37 Empire Farm _____
 _____ Company

NORTH

WEST

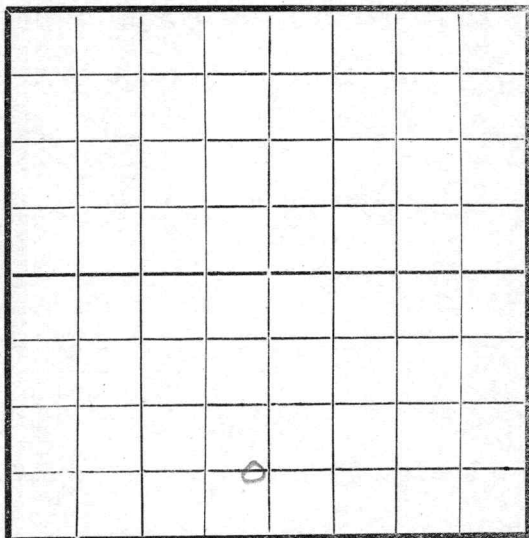

EAST

SOUTH

Location _____

Rig Up _____

Drilling and remarks

1100

RECORD

Cased _____ in. _____ Ft.

Sand _____

Gas _____

Oil _____

Total Depth _____

PRODUCTION

1st 24 hrs. Nat. _____

1st 24 hrs. after shot _____

Gas _____ Cu. Ft.


Dry Hole _____

Abandoned _____

Date

5/15, 1918 Empire Scout

Map No. _____ Sec. 12 Twp. 26 R. 4
 Well No. 37 _____ Farm _____
Engine _____ Company _____
 NORTH

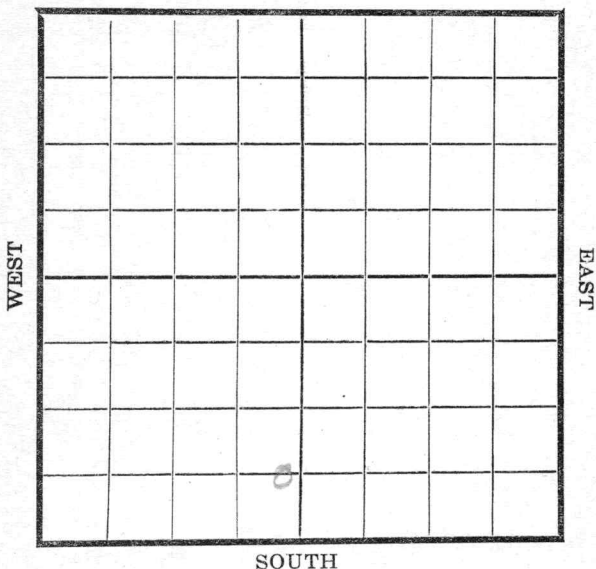

Location _____
 Rig Up _____
 Drilling and remarks

1358

RECORD

Cased _____ in. _____ Ft.
 Sand _____
 Gas _____
 Oil _____
 Total Depth _____

PRODUCTION

1st 24 hrs. Nat. _____
 1st 24 hrs. after shot _____
 Gas _____ Cu. Ft.
 Dry Hole _____
 Abandoned _____

Date

5/22 1918 Condy Scout


Map No. _____ Sec. 13 Twp. 26 R. 4

Well No. 37 Farm _____

_____ Company

NORTH

WEST

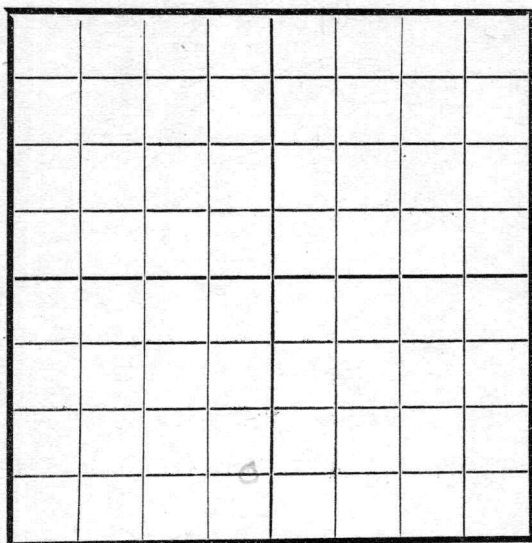

EAST

SOUTH

Location _____

Rig Up _____

Drilling and remarks

RECORD

Cased _____ in _____ Ft.

Sand _____

Gas _____

Oil _____

Total Depth _____

PRODUCTION

1st 24 hrs. Nat. _____

1st 24 hrs. after shot _____

Gas _____ Cu. Ft.

Dry Hole _____

Abandoned _____

Date


5/29, 1918 S. Condy Scout

Map No. _____ Sec. 12 Twp. 26 R. 4

Well No. 378 _____ Farm _____
Empire _____ Company

NORTH

WEST

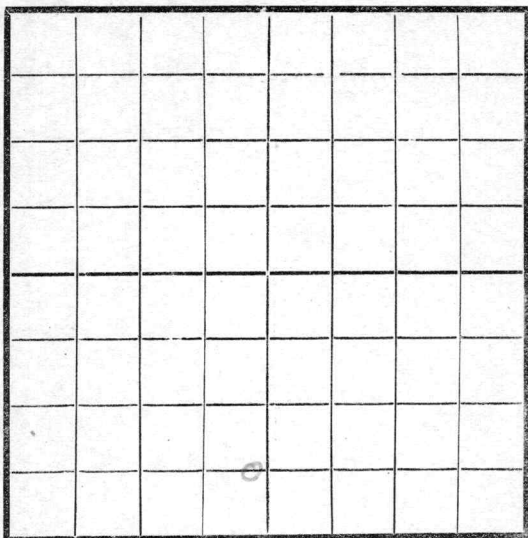

EAST

SOUTH

Location _____

Rig Up _____

Drilling and remarks

2210

RECORD

Cased _____ in. _____ Ft.

Sand _____

Gas _____

Oil _____

Total Depth _____

PRODUCTION

1st 24 hrs. Nat. _____

1st 24 hrs. after shot _____

Gas _____ Cu. Ft.

Dry Hole _____

Abandoned _____

Date

6/5, 1918 S. Condy Scout

Map No. 114 Sec. 12 Twp. 26 R. 4Well No. 37 AugustCompany EngelContractor Wickley Drilling Co.

NORTH

WEST

EAST

SOUTH

COMPLETED

Location _____

Rig up _____

Drilling and Remarks:

Est at
200
1360

RECORD

Cased _____ in., _____ ft.

Sand 2360-2408

Gas _____

Oil _____

Total Depth _____

PRODUCTION

1st 24 hrs. Nat. _____

1st 24 hrs. after shot _____

Gas _____ Cu. Ft.

Dry Hole _____

Abandoned _____

Date

6/12/18

191

Scout