


Map No. _____ Sec. 12 Twp. 26 R. 4
 Well No. 38 Empire Farm
Empire Oil & Gas Co. Company

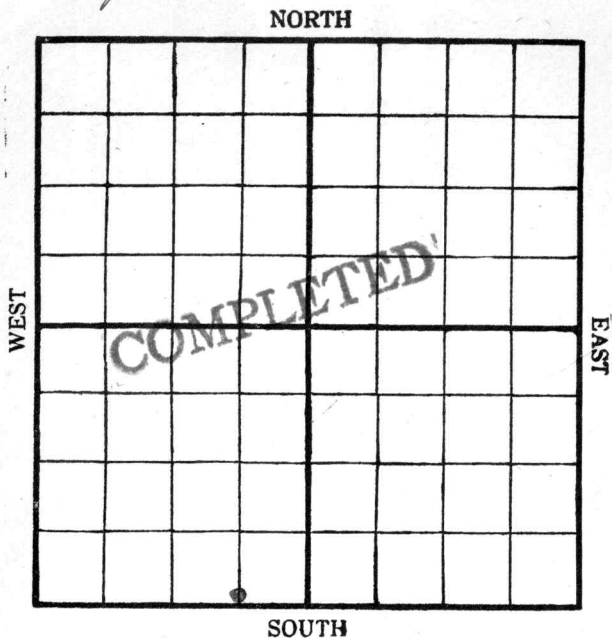

Location _____

Rig Up _____

Drilling Remarks:

Drilling Remarks:

RECORD

PRODUCTION

Cased _____ in. _____ ft.

1st 24 hrs. Nat. _____

Sand _____

1st 24 hrs. after shot _____

Gas _____

Gas _____ cu. ft.

Oil _____

Dry Hole _____

Total Depth _____

Abandoned _____


Map No. K14 Sec. 12 Twp. 26 R. 4

Well No. 38 Farm

Engine Company

NORTH

WEST

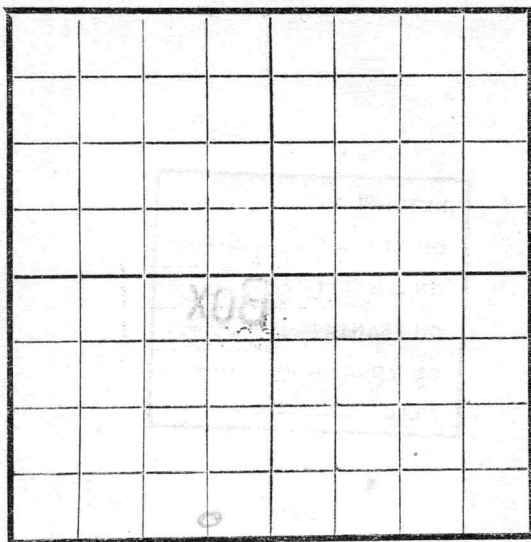

EAST

SOUTH

Location ✓

Rig Up ✓

Drilling and remarks

RECORD

Cased _____ in. _____ Ft

Sand _____

Gas _____

Oil _____

Total Depth _____

PRODUCTION

1st 24 hrs. Nat. _____

1st 24 hrs. after shot _____

Gas _____ Cu. Ft.

Dry Hole _____

Abandoned _____

FIRST REPORT


Date

579, 1918 Scout

Map No. _____ Sec. 12 Twp. 26 R. 4
 Well No. 38 Engineer Farm _____
Engineer Company _____

NORTH

WEST

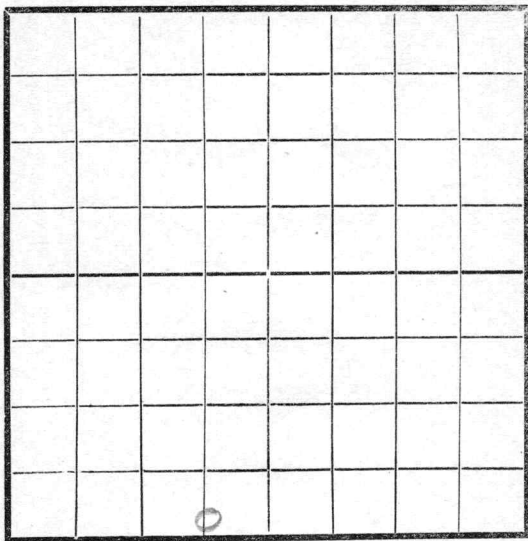

EAST

SOUTH

Location _____
 Rig Up _____
 Drilling and remarks _____

*Rigging up
 McJunkins and
 Lamar
 E. P. Duda*

RECORD

Cased _____ in. _____ Ft.
 Sand _____
 Gas _____
 Oil _____
 Total Depth _____

PRODUCTION

1st 24 hrs. Nat. _____
 1st 24 hrs. after shot _____
 Gas _____ Cu. Ft.
 Dry Hole _____
 Abandoned _____

Date

5/15, 1918 Condy Scout


Map No. _____ Sec. 12 Twp. 26 R. 4Well No. 38 Empire Farm _____

Company _____

NORTH

WEST

EAST

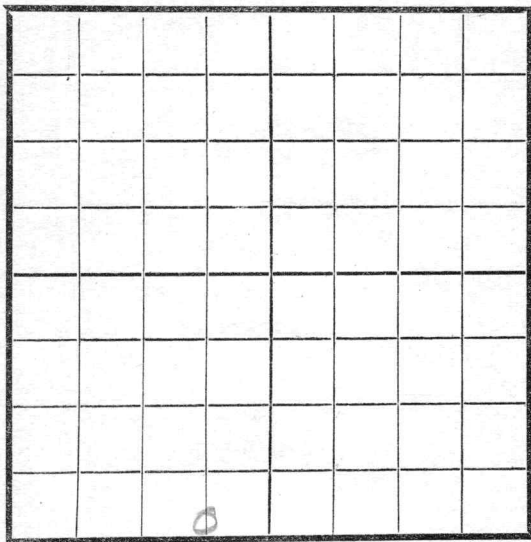

SOUTH

Location _____

Rig Up _____

Drilling and remarks

300

RECORD

Cased _____ in _____ Ft.

Sand _____

Gas _____

Oil _____

Total Depth _____

PRODUCTION

1st 24 hrs. Nat. _____

1st 24 hrs. after shot _____

Gas _____ Cu. Ft.

Dry Hole _____

Abandoned _____

Date

5/22/1918


Scout

Map No. _____ Sec. 27 Twp. 26 R. 4Well No. 38 Canyon Farm _____

Company _____

NORTH

WEST

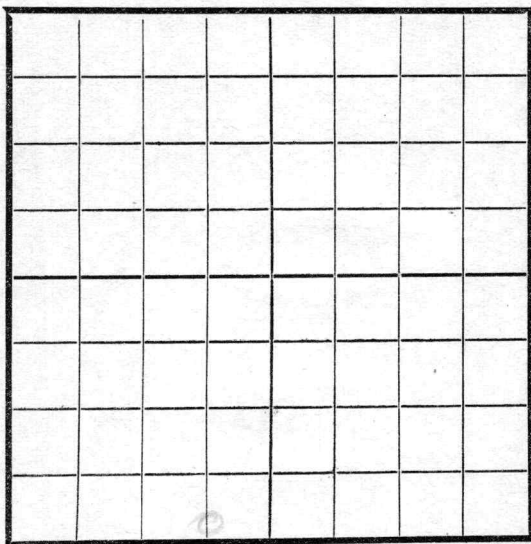

EAST

SOUTH

Location _____

Rig Up _____

Drilling and remarks

850

RECORD

Cased _____ in. _____ Ft.

Sand _____

Gas _____

Oil _____

Total Depth _____

PRODUCTION

1st 24 hrs. Nat. _____

1st 24 hrs. after shot _____

Gas _____ Cu. Ft.

Dry Hole _____

Abandoned _____

Date

5/29, 1918 Canyon Scout


Map No. _____ Sec. 12 Twp. 26 R. 4

Well No. 38 Canyon Farm _____

_____ Company

NORTH

WEST

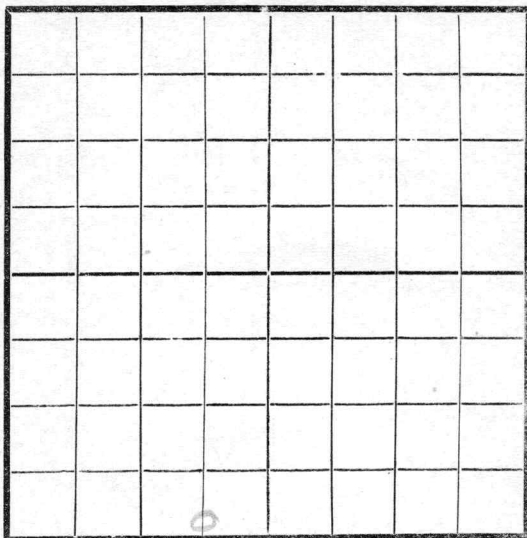

EAST

SOUTH

Location _____

Rig Up _____

Drilling and remarks

850

RECORD

Cased _____ in. _____ Ft.

Sand _____

Gas _____

Oil _____

Total Depth _____

PRODUCTION

1st 24 hrs. Nat. _____

1st 24 hrs. after shot _____

Gas _____ Cu. Ft.

Dry Hole _____

Abandoned _____

Date

6/5, 1918 C. Conley Scout

Map No. _____ Sec. 12 Twp. 26 R. 4Well No. 38 Engine


_____ Company

_____ Contractor

NORTH

WEST

EAST

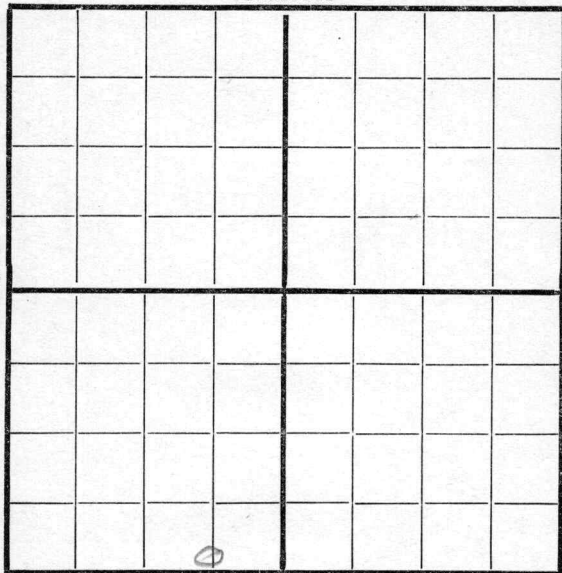

SOUTH

Location _____

Rig up _____

Drilling and Remarks:

1400**RECORD**

Cased _____ in., _____ ft.

Sand _____

Gas _____

Oil _____

Total Depth _____

PRODUCTION

1st 24 hrs. Nat. _____

1st 24 hrs. after shot _____

Gas _____ Cu. Ft.

Dry Hole _____

Abandoned _____

Date

6/12 1918 J. Cardy Scout

Map No. _____ Sec. 12 Twp. 26 R. 4Well No. 38 Empire Farm __________Empire Company _____

NORTH

WEST

EAST

SOUTH

Location _____

Rig Up _____

Drilling and remarks

1825

RECORD

Cased _____ in _____ Ft.

Sand _____

Gas _____

Oil _____

Total Depth _____

PRODUCTION

1st 24 hrs. Nat. _____

1st 24 hrs. after shot _____

Gas _____ Cu. Ft.


Dry Hole _____

Abandoned _____

Date

6/19, 1918 C. C. C. C. Scout

Map No. _____ Sec. 12 Twp. 26 R. 4
Well No. 38 E engine 7
E engine _____ Company _____
Contractor _____

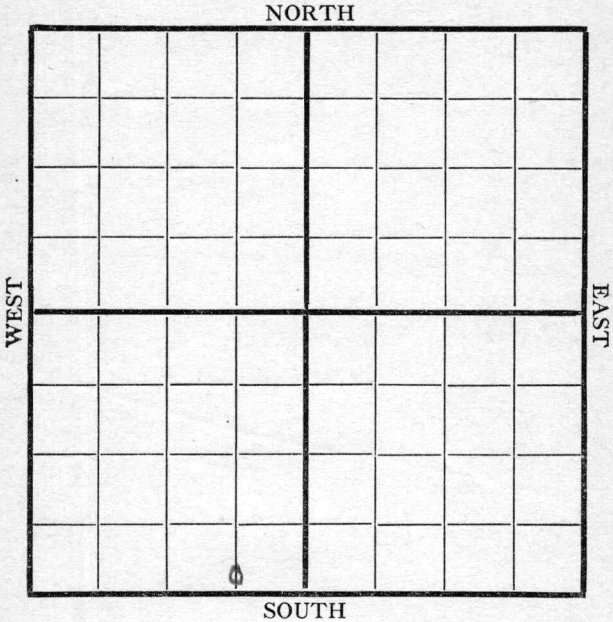

	RECORD
Location _____	Cased _____ in., _____ ft.
Rig up _____	Sand _____
Drilling and Remarks: 2185	Gas _____
	Oil _____
	Total Depth _____
	=====
	PRODUCTION
	1st 24 hrs. Nat. _____
	1st 24 hrs. after shot _____
	Gas _____ Cu. Ft.
	Dry Hole _____
	Abandoned _____

Date _____
6/26 1918 C. C. Cuddy Scout

Map No. _____ Sec. 17 Twp. 26 R. 4
Well No. 38 Engart
_____Engart Company

Contractor

NORTH							
WEST							
							EAST
SOUTH							


Location _____ Rig up _____ Drilling and Remarks: <u>2335</u>	RECORD
	Cased _____ in., _____ ft.
	Sand _____
	Gas _____
	Oil _____
	Total Depth _____
	PRODUCTION
	1st 24 hrs. Nat. _____
	1st 24 hrs. after shot _____
	Gas _____ Cu. Ft.
	Dry Hole _____
	Abandoned _____

Date 7/3 1918 P. Condit Scout

Map No. K14 Sec. 12 Twp. 26 R. 24Well No. 38 EmyartEmpire CompanyLamar & McJunkin Contractor

NORTH

WEST

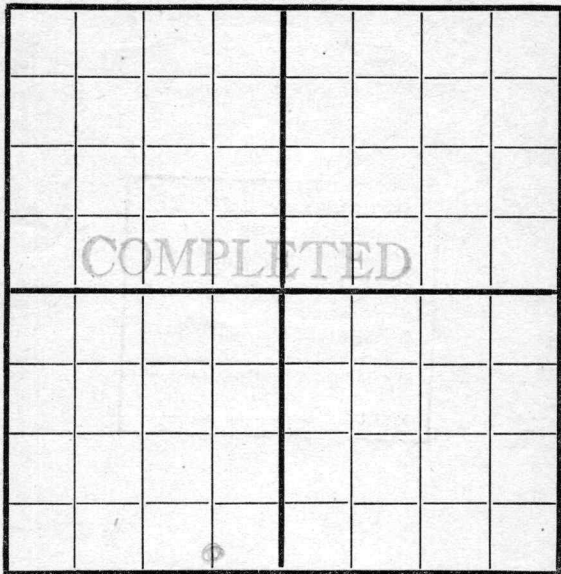

EAST

SOUTH

RECORD

Location _____

Cased _____ in., _____ ft.

Rig up _____

Sand 2421-2484

Drilling and Remarks:

Gas _____

Oil _____

Total Depth _____

PRODUCTION

1st 24 hrs. Nat. _____

1st 24 hrs. after shot _____

Gas _____ Cu. Ft.

Dry Hole _____

Abandoned _____

Date

7/10 1918 Condyff Scout