
Form 51—12-17—5M—Mid-West.

Map No. _____ Sec. 12 Twp. 26 R. 4

Well No. 1 to 6 inc. Farm

_____ Company

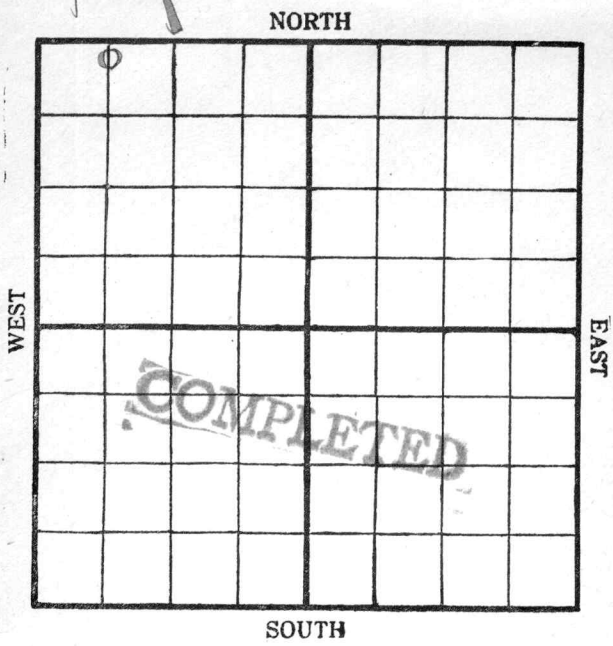

Location _____

Drilling Remarks:

Rig Up _____

Drilling Remarks:

RECORD

Cased _____ in. _____ ft.

Sand _____

Gas _____

Oil _____

Total Depth _____

PRODUCTION

1st 24 hrs. Nat. _____

1st 24 hrs. after shot _____

Gas _____ cu. ft.

Dry Hole _____

Abandoned _____


Form 26—1M Books of 100 Sheets Each.

Map No. K14 Sec. 12 Twp. 26 R. 4

Well No. 20 August Farm

Enyeart Company

NORTH

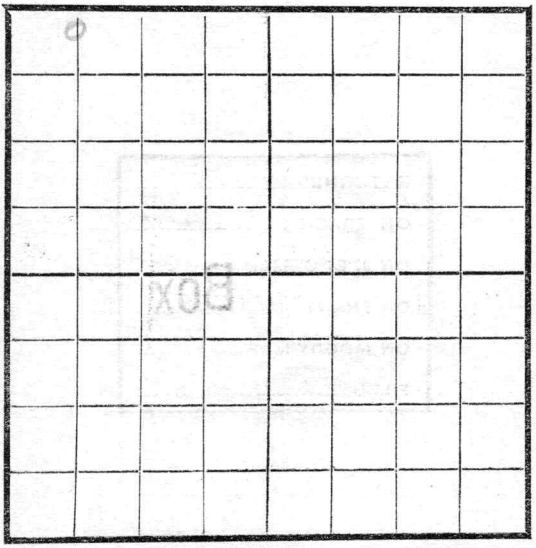

SOUTH

Location

Rig Up

Drilling and remarks

FIRST REPORT

RECORD

Cased in Ft

Sand

Gas

Oil

Total Depth

PRODUCTION

1st 24 hrs. Nat.

1st 24 hrs. after shot

Gas Cu. Ft.

Dry Hole

Abandoned

Date

5/9, 191

Scout

Form 26—1M Books of 100 Sheets Each—4-15-18


Map No. _____ Sec. 13 Twp. 26 R. 4

Well No. 40 Empire

Empire Company

Marshall & McGinnis Contractor

El Dorado Ks

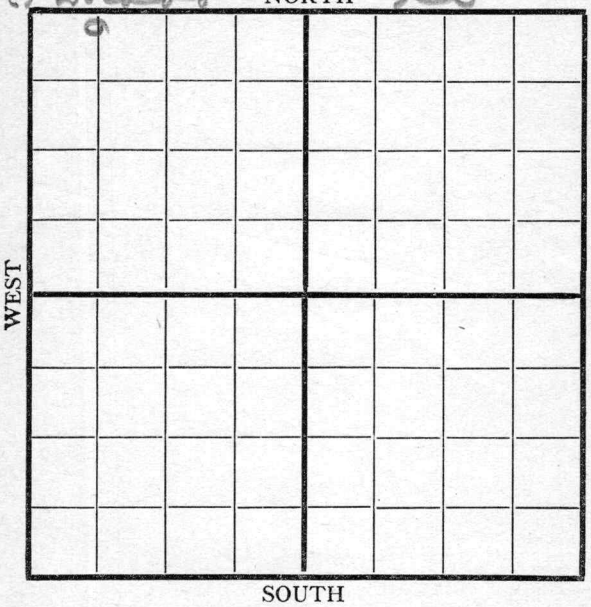

Location _____

Rig up _____

Drilling and Remarks:

100'

RECORD

Cased _____ in., _____ ft.

Sand _____

Gas _____

Oil _____

Total Depth _____

PRODUCTION

1st 24 hrs. Nat. _____

1st 24 hrs. after shot _____

Gas _____ Cu. Ft.

Dry Hole _____

Abandoned _____

Date

6/3 6 191 8 Scout


Form 26—1M Books of 100 Sheets Each—4-15-18

Map No. ____ Sec. 17 Twp. 26 R. 4

Well No. 40 August

Empire Company

Contractor

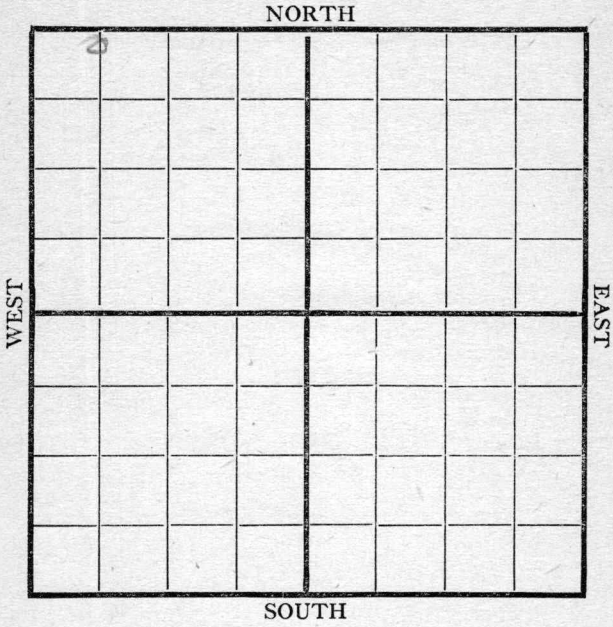

Location

Rig up

Drilling and Remarks:

825

RECORD

Cased ____ in., ____ ft.

Sand

Gas

Oil

Total Depth

PRODUCTION

1st 24 hrs. Nat.

1st 24 hrs. after shot

Gas ____ Cu. Ft.

Dry Hole

Abandoned

Date

7/3 191 ____ Scout


Form 26—1M Books of 100 Sheets Each—4-15-18

Map No. ____ Sec. 12 Twp. 36 R. 4

Well No. 40 Empire

Empire Co. Company

Contractor

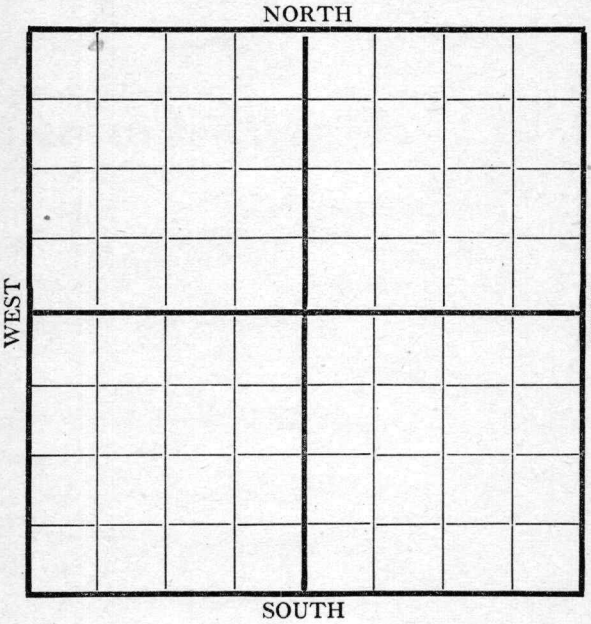

Location ____

Rig up ____

Drilling and Remarks:

1150

RECORD

Cased ____ in., ____ ft.

Sand ____

Gas ____

Oil ____

Total Depth ____

PRODUCTION

1st 24 hrs. Nat. ____

1st 24 hrs. after shot ____

Gas ____ Cu. Ft.

Dry Hole ____

Abandoned ____

Date

7/10 191 8. C. A. Dill Scout


Form 26—1M Books of 100 Sheets Each—4-15-18

Map No. ____ Sec. 12 Twp. 26 R. 4

Well No. 40 Engine

Company

Contractor

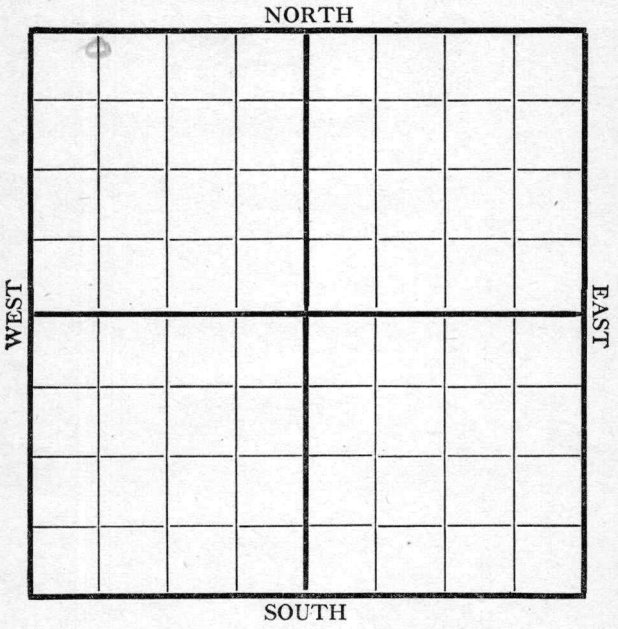

Location

Rig up

Drilling and Remarks:

1480

RECORD

Cased ____ in., ____ ft.

Sand

Gas

Oil

Total Depth

PRODUCTION

1st 24 hrs. Nat.

1st 24 hrs. after shot

Gas ____ Cu. Ft.

Dry Hole

Abandoned

Date

7/17 1918

Scout


Form 26—1M Books of 100 Sheets Each—4-15-18

Map No. _____ Sec. 12 Twp. 26 R. 4

Well No. 4 Ortega

Company

Contractor

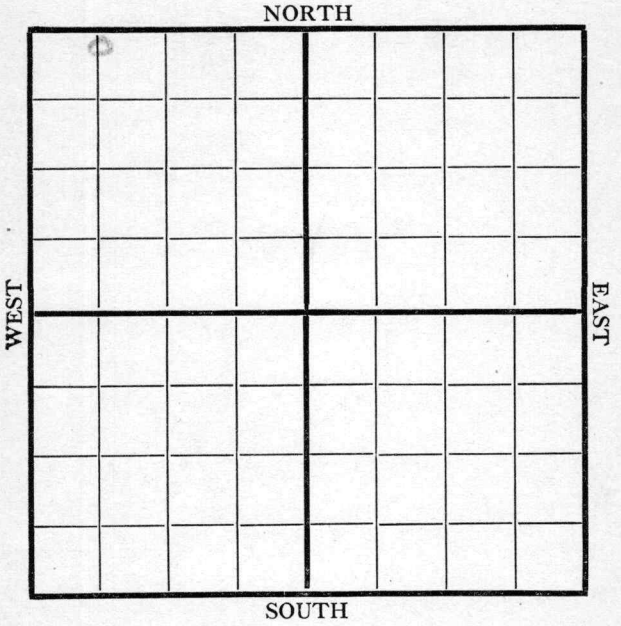

Location _____

Rig up _____

Drilling and Remarks:

1715

RECORD

Cased _____ in., _____ ft.

Sand _____

Gas _____

Oil _____

Total Depth _____

PRODUCTION

1st 24 hrs. Nat. _____

1st 24 hrs. after shot _____

Gas _____ Cu. Ft.

Dry Hole _____

Abandoned _____

Date

7/24 191 8 Scout


Form 26—1M Books of 100 Sheets Each—4-15-18

Map No. ____ Sec. 12 Twp. 26 R. 4

Well No. 40 Empire

Empire Company

Contractor

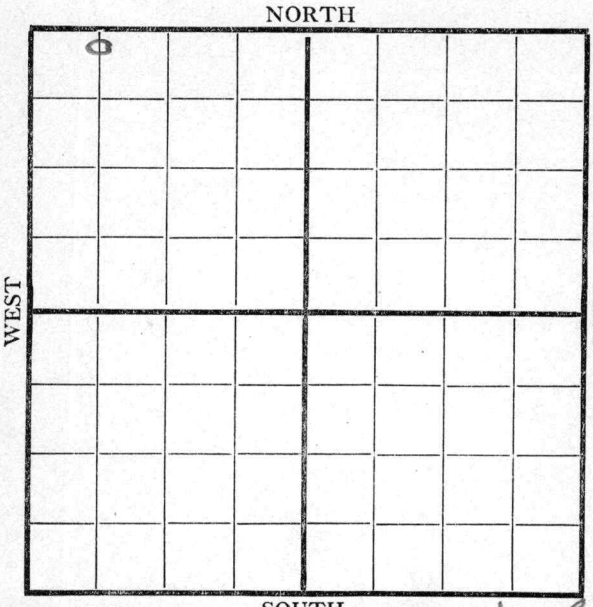

200' [redacted] x 660 [redacted] WL

Location

Rig up

Drilling and Remarks:

1980

RECORD

Cased ____ in., ____ ft.

Sand

Gas

Oil

Total Depth

PRODUCTION

1st 24 hrs. Nat.

1st 24 hrs. after shot

Gas ____ Cu. Ft.

Dry Hole

Abandoned

Date

7/31 191 8 Scout


Form 26—1M Books of 100 Sheets Each—4-15-18

Map No. _____ Sec. 13 Twp. 26 R. 4

Well No. 40 E mynat

Empire Company

_____ Contractor

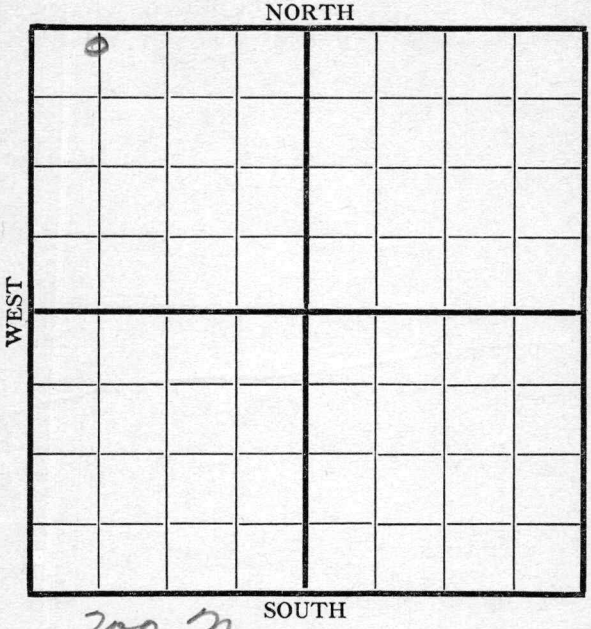

200 N

Location 660 W

Rig up _____

Drilling and Remarks:

2130

RECORD

Cased _____ in., _____ ft.

Sand _____

Gas _____

Oil _____

Total Depth _____

PRODUCTION

1st 24 hrs. Nat. _____

1st 24 hrs. after shot _____

Gas _____ Cu. Ft.

Dry Hole _____

Abandoned _____

Date 8/7 191 8 _____ Scout

Form 26—1M Books of 100 Sheets Each—4-15-18


Map No. _____ Sec. 13 Twp. 26 R. 4

Well No. 40 Emmett

Cyril

_____ Company

_____ Contractor

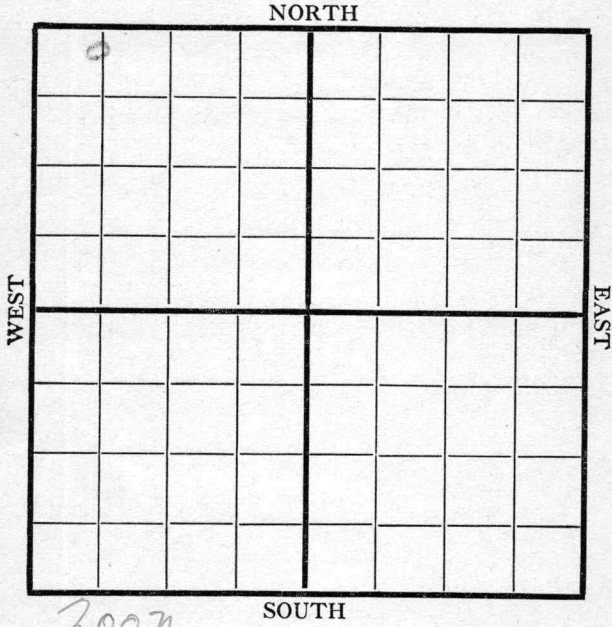

200N
660W

Location _____

Rig up _____

Drilling and Remarks:

T. D. 2356

RECORD

Cased _____ in., _____ ft.

Sand _____

Gas _____

Oil _____

Total Depth _____

PRODUCTION

1st 24 hrs. Nat. _____

1st 24 hrs. after shot _____

Gas _____ Cu. Ft.

Dry Hole _____

Abandoned _____

Date

8/15 191 8 Cyclone Scout


Form 26—1M Books of 100 Sheets Each—4-15-18

Map No. K 4 Sec. 17 Twp. 26 R. 4

Well No. 40 Enyart

Empire Company

Contractor

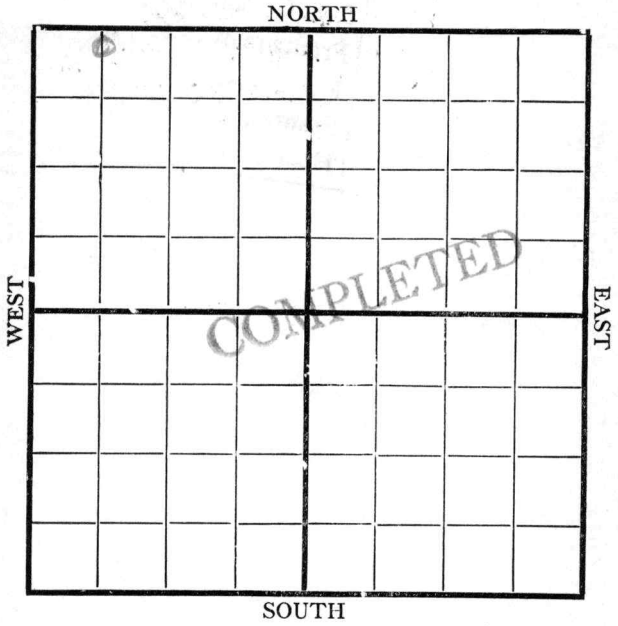

Location 200'N-660'W

Rig up

Drilling and Remarks:

RECORD

Cased in., ft.

Sand 2356-2397

Gas

Oil

Total Depth

PRODUCTION

1st 24 hrs. Nat. 1500/446

1st 24 hrs. after shot

Gas Cu. Ft.

Dry Hole

Abandoned

Date

8/20 191 8. Coyle Scout