

Map No. _____ Sec. 11 Twp. 26 R. 4Well No. 18-Orban Farm __________Carter Company _____

NORTH

WEST

EAST

SOUTH

COMPLETED

0

Location _____

Rig Up _____

Drilling Remarks:

Drilling Remarks:

RECORD

Cased _____ in. _____ ft.

Sand _____

Gas _____

Oil _____

Total Depth _____

PRODUCTION

1st 24 hrs. Nat. _____


1st 24 hrs. after shot _____

Gas _____ cu. ft.

Dry Hole _____

Abandoned _____

Map No. _____ Sec. 11 Twp. 26 R. 4
 Well No. 18 Orleans Farm _____
Carter Company _____

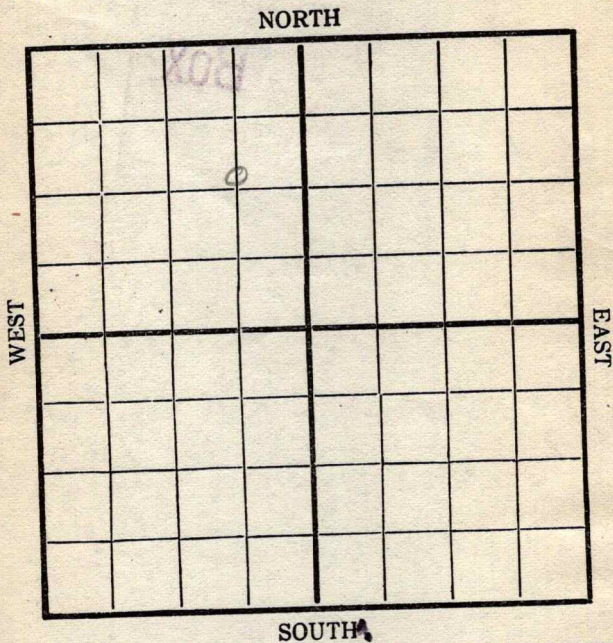

Location _____
 Rig Up ☒ _____
 Drilling and remarks _____

FIRST REPORT

RECORD

Cased _____ in. _____ Ft.
 Sand _____
 Gas _____
 Oil _____
 Total Depth _____

PRODUCTION

1st 24 hrs. Nat. _____
 1st 24 hrs. after shot _____
 Gas _____ Cu. Ft.
 Dry Hole _____
 Abandoned _____


Date _____

_____, 191 7 Carter Scout

Map No. _____ Sec. 11 Twp. No 4 R. _____
 Well No. 18. Oarboan Farm _____
Carter Company _____

NORTH

WEST

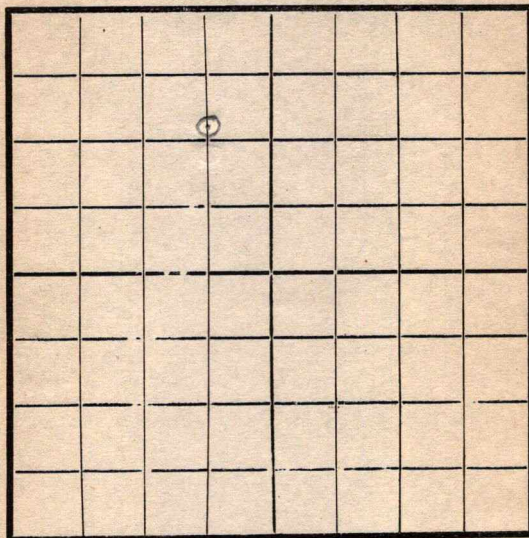

EAST

SOUTH

Location _____
 Rig Up ☒ _____
 Drilling and remarks _____

RECORD

Cased _____ in. _____ Ft.
 Sand _____
 Gas _____
 Oil _____
 Total Depth _____

PRODUCTION

1st 24 hrs. Nat. _____
 1st 24 hrs. after shot _____
 Gas _____ Cu. Ft.
 Dry Hole _____
 Abandoned _____


Date

8-24, 1917 Lantz Scout _____

Map No. _____ Sec. 11 Twp. 26 R. 4Well No. 18 Orban Farm _____Carter Company _____

NORTH

WEST

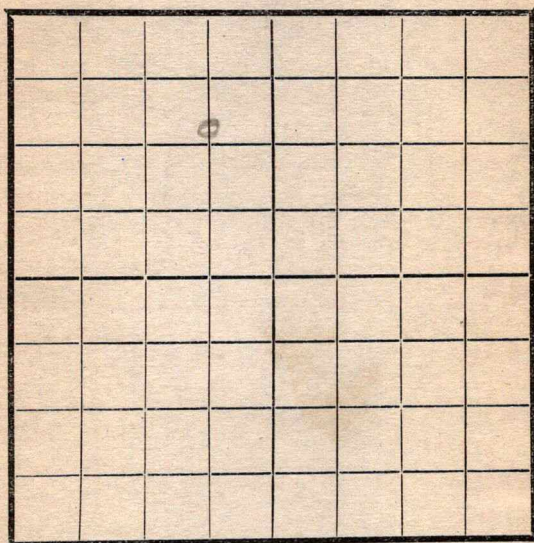

EAST

SOUTH

Location _____

Rig Up _____

Drilling and remarks

1653

RECORD

Cased _____ in. _____ Ft

Sand _____

Gas _____

Oil _____

Total Depth _____

PRODUCTION

1st 24 hrs. Nat. _____

1st 24 hrs. after shot _____

Gas _____ Cu. Ft

Dry Hole _____

Abandoned _____


Date

10/9, 1917 C. Carter Scout _____

Map No. _____ Sec. 11 Twp. 26 R. 4
 Well No. 18 Orban Farm _____
Carter Company _____

NORTH

WEST

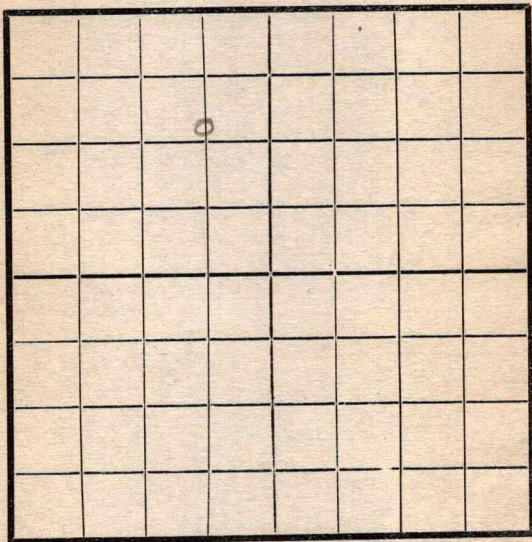

EAST

SOUTH

Location _____

Rig Up _____

Drilling and remarks

1785

RECORD

Cased _____ in. _____ Ft

Sand _____

Gas _____

Oil _____

Total Depth _____

PRODUCTION

1st 24 hrs. Nat. _____

1st 24 hrs. after shot _____

Gas _____ Cu. Ft

Dry Hole _____

Abandoned _____


Date

10/17, 1917 C. D. Jeff Scout _____

Map No. _____ Sec. 11 Twp. 26 R. 4
 Well No. 18 Orlean Farm _____
Carter Company _____

NORTH

WEST

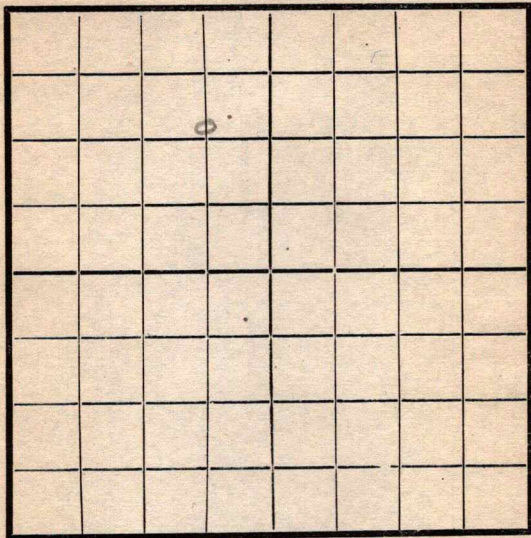

EAST

SOUTH

Location _____
 Rig Up _____
 Drilling and remarks

2050

RECORD

Cased _____ in. _____ Ft.
 Sand _____
 Gas _____
 Oil _____
 Total Depth _____

PRODUCTION

1st 24 hrs. Nat. _____
 1st 24 hrs. after shot _____
 Gas _____ Cu. Ft.
 Dry Hole _____
 Abandoned _____

Date


10/24, 1917 Carter

Scout

Map No. _____ Sec. 11 Twp. 26 R. 4Well No. 18 Orban Farm _____
Carter Company _____

NORTH

WEST

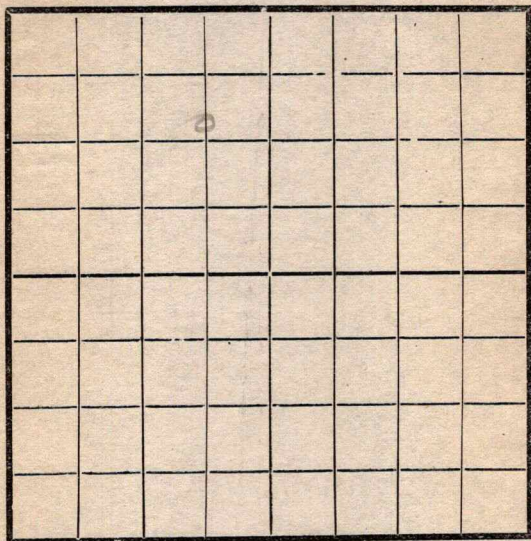

EAST

SOUTH

Location _____

Rig Up _____

Drilling and remarks

2250

RECORD

Cased _____ in. _____ Ft.

Sand _____

Gas _____

Oil _____

Total Depth _____

PRODUCTION

1st 24 hrs. Nat. _____

1st 24 hrs. after shot _____

Gas _____ Cu. Ft.

Dry Hole _____

Abandoned _____

Date


10/31, 1917 Carter Scout _____

Map No. _____ Sec. 11 Twp. 26 R. 4Well No. 1801b Farm _____

Company _____

NORTH

WEST

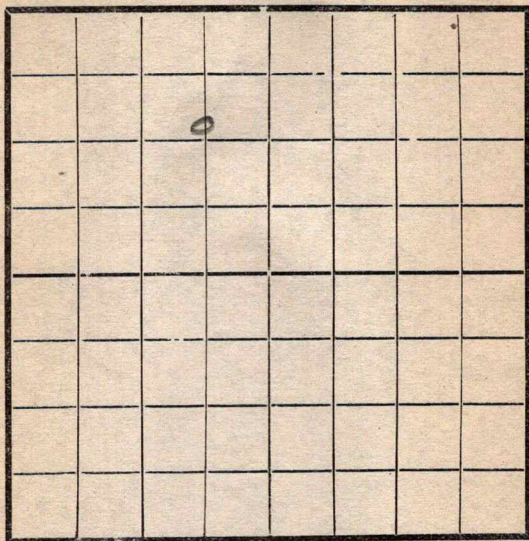

EAST

SOUTH

Location _____

Rig Up _____

Drilling and remarks

2335

RECORD

Cased _____ in. _____ Ft.

Sand _____

Gas _____

Oil _____

Total Depth _____

PRODUCTION

1st 24 hrs. Nat. _____

1st 24 hrs. after shot _____

Gas _____ Cu. Ft.

Dry Hole _____

Abandoned _____


Date

11-7, 1917 Conroy Scout _____

Map No. _____ Sec. 11 Twp. 26 R. 4
 Well No. 18 Oilman Farm _____
Center Company _____

NORTH

WEST

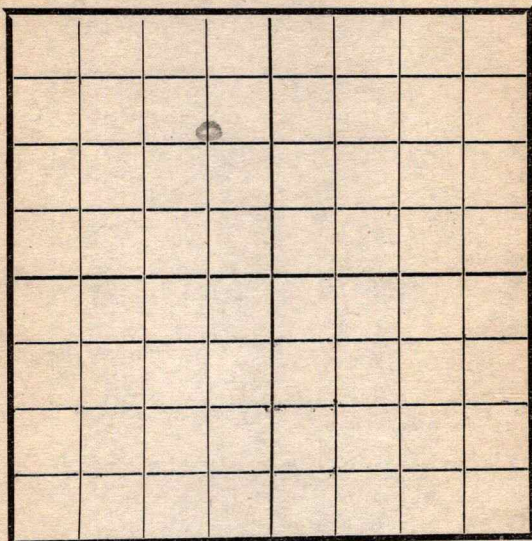

EAST

SOUTH

Location _____

Rig Up _____

Drilling and remarks

2396

RECORD

Cased _____ in. _____ Ft.

Sand _____

Gas _____

Oil _____

Total Depth _____

PRODUCTION

1st 24 hrs. Nat. _____

1st 24 hrs. after shot _____

Gas _____ Cu. Ft.

Dry Hole _____

Abandoned _____


Date

11/14, 1917 Condy Scout _____

Map No. H14 Sec. 11 Twp. 26 R. 4
 Well No. 18 Arban Farm
Center Company

NORTH

WEST

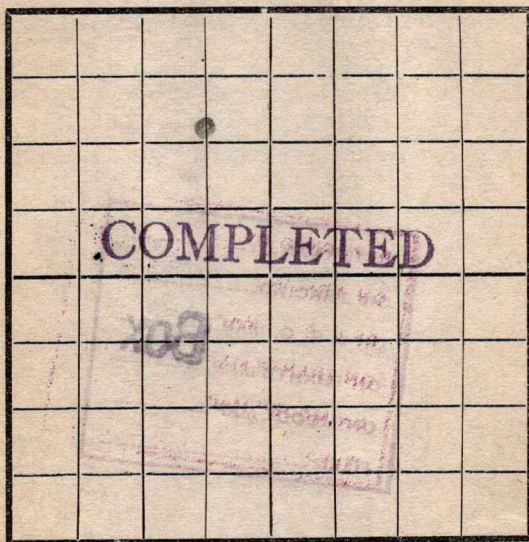

EAST

SOUTH

Location -----

Rig Up -----

Drilling and remarks

Est at
300 Bbl

RECORD

Cased ----- in ----- Ft.

Sand 2351-2416

Gas -----

Oil -----

Total Depth -----

PRODUCTION

1st 24 hrs. Nat. -----

1st 24 hrs. after shot -----

Gas ----- Cu. Ft.

Dry Hole -----

Abandoned -----

Date

4/21, 1912 Center Scout