

Map No. \_\_\_\_\_ Sec. 12 Twp. 26 R. 4

Well No. 48 Empire Farm \_\_\_\_\_  
Empire Oil Co Company \_\_\_\_\_

NORTH

|  |  |  |  |  |  |  |  |
|--|--|--|--|--|--|--|--|
|  |  |  |  |  |  |  |  |
|  |  |  |  |  |  |  |  |
SOUTH

WEST

EAST

COMPLETED

Location \_\_\_\_\_

Drilling Remarks:

\_\_\_\_\_

\_\_\_\_\_

\_\_\_\_\_

\_\_\_\_\_

\_\_\_\_\_

\_\_\_\_\_

\_\_\_\_\_

\_\_\_\_\_

\_\_\_\_\_

\_\_\_\_\_

Rig Up \_\_\_\_\_

Drilling Remarks:

\_\_\_\_\_

\_\_\_\_\_

\_\_\_\_\_

\_\_\_\_\_

\_\_\_\_\_

\_\_\_\_\_

\_\_\_\_\_

\_\_\_\_\_

\_\_\_\_\_

\_\_\_\_\_

**RECORD**

Cased \_\_\_\_\_ in. \_\_\_\_\_ ft.

Sand \_\_\_\_\_

Gas \_\_\_\_\_

Oil \_\_\_\_\_

Total Depth \_\_\_\_\_

**PRODUCTION**

1st 24 hrs. Nat. \_\_\_\_\_

1st 24 hrs. after shot \_\_\_\_\_

Gas \_\_\_\_\_ cu. ft


Dry Hole \_\_\_\_\_

Abandoned \_\_\_\_\_

Map No. K14 Sec. 12 Twp. 26 R. 4Well No. 48C report FarmEngine Company

NORTH

WEST

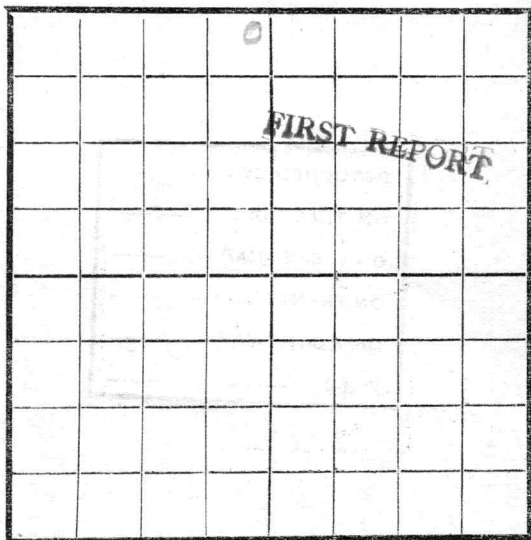

EAST

SOUTH

Location -----

Rig Up -----

Drilling and remarks -----

## RECORD

Cased ----- in ----- Ft.

Sand -----

Gas -----

Oil -----

Total Depth -----

## PRODUCTION

1st 24 hrs. Nat. -----

1st 24 hrs. after shot -----

Gas ----- Cu. Ft.

Dry Hole -----

Abandoned -----

Date

5/31, 1918 Candys Scout

Map No. \_\_\_\_\_ Sec. 12 Twp. 26 R. 4Well No. 48 E. migrant\_\_\_\_\_  
E. migrant Company\_\_\_\_\_  
Contractor

NORTH

WEST

EAST

SOUTH

Location \_\_\_\_\_

Rig up ☒ \_\_\_\_\_

Drilling and Remarks:

## RECORD

Cased \_\_\_\_\_ in., \_\_\_\_\_ ft.

Sand \_\_\_\_\_

Gas \_\_\_\_\_

Oil \_\_\_\_\_

Total Depth \_\_\_\_\_

## PRODUCTION

1st 24 hrs. Nat. \_\_\_\_\_

1st 24 hrs. after shot \_\_\_\_\_

Gas \_\_\_\_\_ Cu. Ft.

Dry Hole \_\_\_\_\_

Abandoned \_\_\_\_\_

Date

6/26 1918 Candys Scout

Map No. \_\_\_\_\_ Sec. 17 Twp. 26 R. 4Well No. 48 \_\_\_\_\_

Company \_\_\_\_\_

Contractor \_\_\_\_\_

NORTH

WEST

EAST

SOUTH

Location \_\_\_\_\_

Rig up \_\_\_\_\_

Drilling and Remarks:

## RECORD

Cased \_\_\_\_\_ in., \_\_\_\_\_ ft.

Sand \_\_\_\_\_

Gas \_\_\_\_\_

Oil \_\_\_\_\_

Total Depth \_\_\_\_\_

## PRODUCTION

1st 24 hrs. Nat. \_\_\_\_\_

1st 24 hrs. after shot \_\_\_\_\_

Gas \_\_\_\_\_ Cu. Ft.

Dry Hole \_\_\_\_\_

Abandoned \_\_\_\_\_

Date

191

Scout

Map No. \_\_\_\_\_ Sec. 12 Twp. 26 R. 4Well No. 488\_\_\_\_\_  
Empire Company\_\_\_\_\_  
Contractor

NORTH

WEST

EAST

SOUTH

Location \_\_\_\_\_

Rig up ☒

Drilling and Remarks:

## RECORD

Cased \_\_\_\_\_ in., \_\_\_\_\_ ft.

Sand \_\_\_\_\_

Gas \_\_\_\_\_

Oil \_\_\_\_\_

Total Depth \_\_\_\_\_

## PRODUCTION

1st 24 hrs. Nat. \_\_\_\_\_

1st 24 hrs. after shot \_\_\_\_\_

Gas \_\_\_\_\_ Cu. Ft.

Dry Hole \_\_\_\_\_

Abandoned \_\_\_\_\_

Date


5/10 191 8 C. Condit Scout

Map No. \_\_\_\_\_ Sec. 12 Twp. 26 R. 4Well No. 48 E. Canyon

\_\_\_\_\_ Company

\_\_\_\_\_ Contractor

NORTH

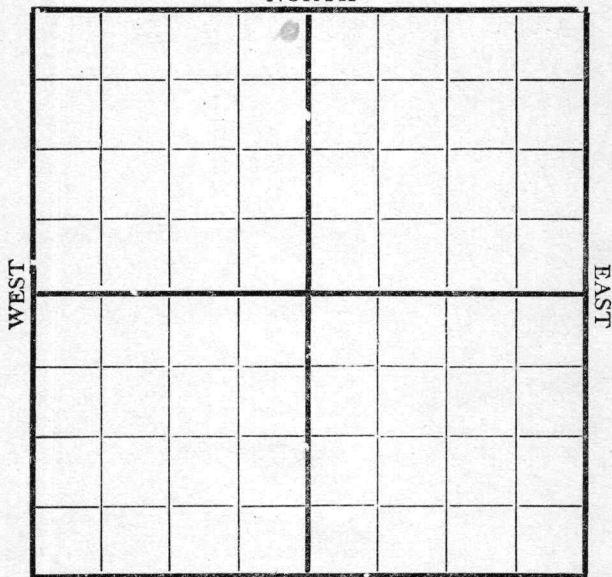

SOUTH

Location \_\_\_\_\_

Rig up ☒ \_\_\_\_\_

Drilling and Remarks:

**RECORD**

Cased \_\_\_\_\_ in., \_\_\_\_\_ ft.

Sand \_\_\_\_\_

Gas \_\_\_\_\_

Oil \_\_\_\_\_

Total Depth \_\_\_\_\_

**PRODUCTION**

1st 24 hrs. Nat. \_\_\_\_\_

1st 24 hrs. after shot \_\_\_\_\_

Gas \_\_\_\_\_ Cu. Ft.

Dry Hole \_\_\_\_\_

Abandoned \_\_\_\_\_

Date

2/17 191 8. Candy Scout


Map No. \_\_\_\_\_ Sec. 12 Twp. 26 R. 4

Well No. 48 E. Mayant

\_\_\_\_\_ Company

\_\_\_\_\_ Contractor

NORTH

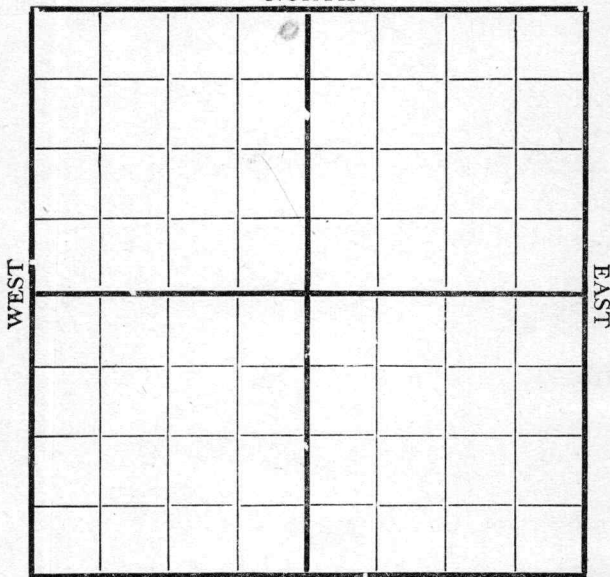

SOUTH

Location \_\_\_\_\_

Rig up \_\_\_\_\_

Drilling and Remarks:

**RECORD**

Cased \_\_\_\_\_ in., \_\_\_\_\_ ft.

Sand \_\_\_\_\_

Gas \_\_\_\_\_

Oil \_\_\_\_\_

Total Depth \_\_\_\_\_

**PRODUCTION**

1st 24 hrs. Nat. \_\_\_\_\_

1st 24 hrs. after shot \_\_\_\_\_

Gas \_\_\_\_\_ Cu. Ft.

Dry Hole \_\_\_\_\_

Abandoned \_\_\_\_\_

Date

7/24 191 8 Candiff Scout

Map No. \_\_\_\_\_ Sec. 12 Twp. 26 R. 4Well No. 48 Bryant

Company \_\_\_\_\_

Contractor \_\_\_\_\_

NORTH

WEST

EAST

SOUTH

Location \_\_\_\_\_

Rig up \_\_\_\_\_

Drilling and Remarks:

150

## RECORD

Cased \_\_\_\_\_ in., \_\_\_\_\_ ft.

Sand \_\_\_\_\_

Gas \_\_\_\_\_

Oil \_\_\_\_\_

Total Depth \_\_\_\_\_

## PRODUCTION

1st 24 hrs. Nat. \_\_\_\_\_

1st 24 hrs. after shot \_\_\_\_\_

Gas \_\_\_\_\_ Cu. Ft.

Dry Hole \_\_\_\_\_

Abandoned \_\_\_\_\_

Date

7/31

191


Scout

Map No. \_\_\_\_\_ Sec. 12 Twp. 26 R. 4Well No. 48 Emyart  
Empire \_\_\_\_\_ Company\_\_\_\_\_  
Contractor

NORTH

WEST

EAST

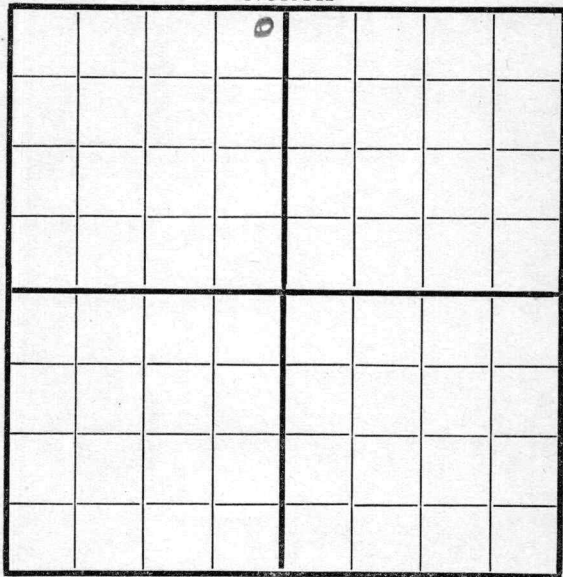

SOUTH

200 78 E

## RECORD

Cased \_\_\_\_\_ in., \_\_\_\_\_ ft.

Sand \_\_\_\_\_

Gas \_\_\_\_\_

Oil \_\_\_\_\_

Total Depth \_\_\_\_\_

## PRODUCTION

1st 24 hrs. Nat. \_\_\_\_\_

1st 24 hrs. after shot \_\_\_\_\_

Gas \_\_\_\_\_ Cu. Ft.

Dry Hole \_\_\_\_\_

Abandoned \_\_\_\_\_

Location \_\_\_\_\_

Rig up \_\_\_\_\_

Drilling and Remarks:

340

Date


8/7191Scout

Scout

Map No. \_\_\_\_\_ Sec. 13 Twp. 26 R. 4Well No. 48 Empire\_\_\_\_\_  
Empire Company\_\_\_\_\_  
Contractor

NORTH

WEST

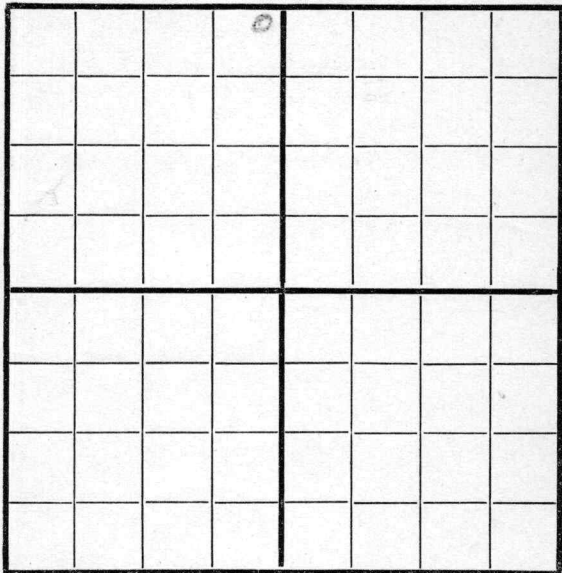

EAST

SOUTH

Location 2007  
2008

Rig up \_\_\_\_\_

Drilling and Remarks:

660'

## RECORD

Cased \_\_\_\_\_ in., \_\_\_\_\_ ft.

Sand \_\_\_\_\_

Gas \_\_\_\_\_

Oil \_\_\_\_\_

Total Depth \_\_\_\_\_

## PRODUCTION

1st 24 hrs. Nat. \_\_\_\_\_

1st 24 hrs. after shot \_\_\_\_\_

Gas \_\_\_\_\_ Cu. Ft.

Dry Hole \_\_\_\_\_

Abandoned \_\_\_\_\_

Date

8/5/1918 Cyle Scout


Map No. \_\_\_\_\_ Sec. 12 Twp. 26 R. 4Well No. 48 E. Canyon

Company \_\_\_\_\_

Contractor J. J. MichaelsNORTH Ko-

WEST

EAST

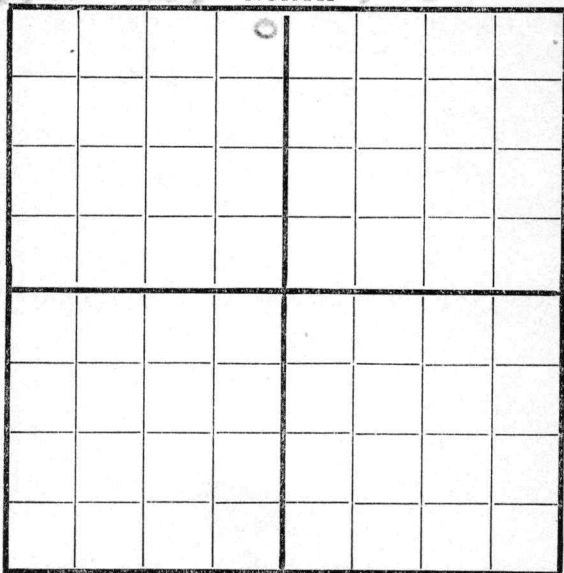

SOUTH

Location \_\_\_\_\_

Rig up \_\_\_\_\_

Drilling and Remarks:

## RECORD

Cased \_\_\_\_\_ in., \_\_\_\_\_ ft.

Sand \_\_\_\_\_

Gas \_\_\_\_\_

Oil \_\_\_\_\_

Total Depth \_\_\_\_\_

## PRODUCTION

1st 24 hrs. Nat. \_\_\_\_\_

1st 24 hrs. after shot \_\_\_\_\_

Gas \_\_\_\_\_ Cu. Ft.

Dry Hole \_\_\_\_\_

Abandoned \_\_\_\_\_

Date 8/22191 8

Pyle


Scout

Map No. 1514 Sec. 12 Twp. 26 R. 4

Well No. 48 E

Company \_\_\_\_\_

Contractor \_\_\_\_\_

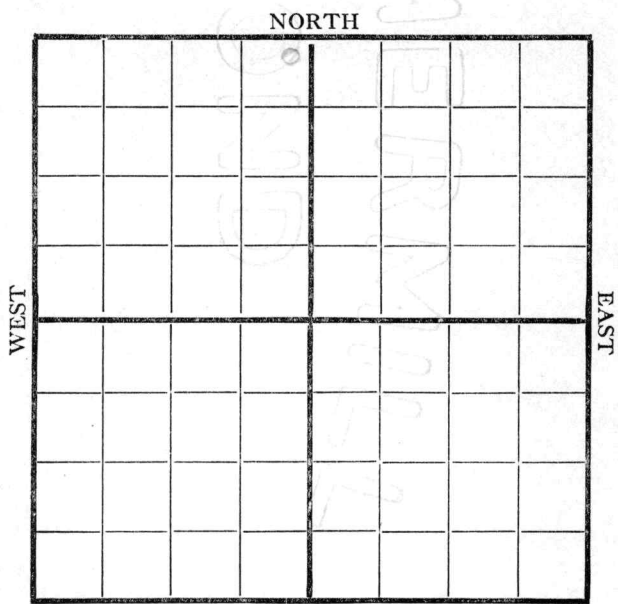

SOUTH

Location \_\_\_\_\_

Rig up \_\_\_\_\_

Drilling and Remarks:

1450

**RECORD**

Cased \_\_\_\_\_ in., \_\_\_\_\_ ft.

Sand \_\_\_\_\_

Gas \_\_\_\_\_

Oil \_\_\_\_\_

Total Depth \_\_\_\_\_

**PRODUCTION**

1st 24 hrs. Nat. \_\_\_\_\_

1st 24 hrs. after shot \_\_\_\_\_

Gas \_\_\_\_\_ Cu. Ft.


Dry Hole \_\_\_\_\_

Abandoned \_\_\_\_\_

Date

8/28 8 Cooley Scout

Map No. 1514 Sec. 12 Twp. 26 R. 4  
Well No. 482  
Englund Company  
Contractor

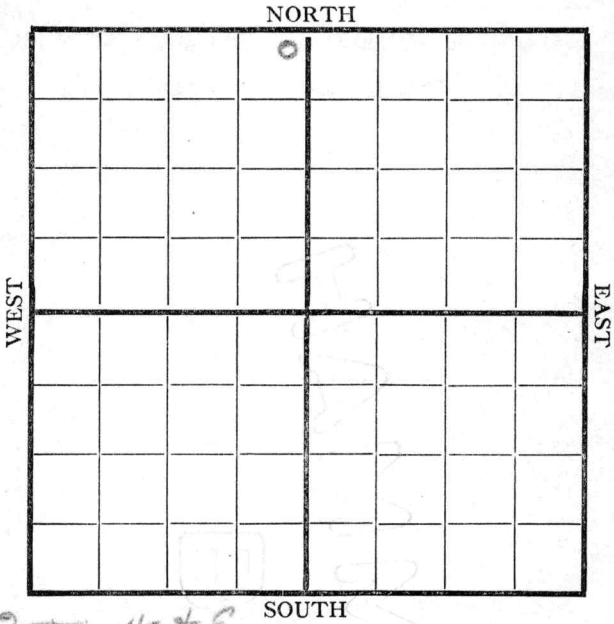

|                                                                            |   |
|----------------------------------------------------------------------------|---|
| Location _____<br>Rig up _____<br>Drilling and Remarks:<br><br><u>1665</u> | <b>RECORD</b><br>Cased _____ in., _____ ft.<br>Sand _____<br>Gas _____<br>Oil _____<br>Total Depth _____                              |
|                                                                            | <b>PRODUCTION</b><br>1st 24 hrs. Nat. _____<br>1st 24 hrs. after shot _____<br>Gas _____ Cu. Ft.<br>Dry Hole _____<br>Abandoned _____ |


Date 9/4 1918 Conley Scout

Map No. 1514 Sec. 12 Twp. 26 R. 4Well No. 48 Engine  
Engine Company  
 Contractor

NORTH

WEST

EAST

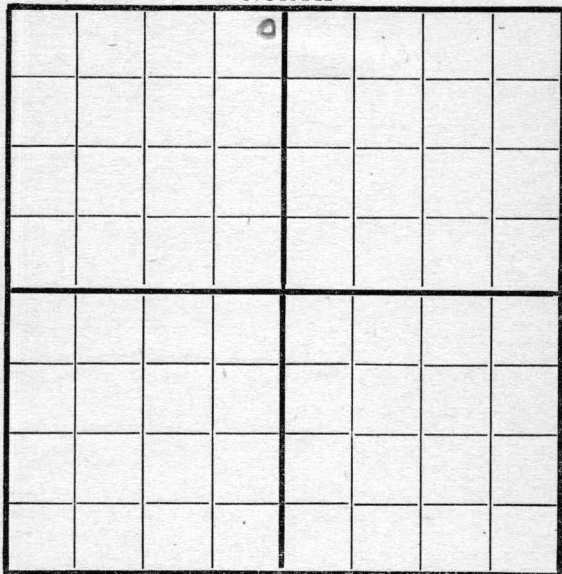

SOUTH

200 N-E

Location \_\_\_\_\_

Rig up \_\_\_\_\_

Drilling and Remarks:

1800

## RECORD

Cased \_\_\_\_\_ in., \_\_\_\_\_ ft.

Sand \_\_\_\_\_

Gas \_\_\_\_\_

Oil \_\_\_\_\_

Total Depth \_\_\_\_\_

## PRODUCTION

1st 24 hrs. Nat. \_\_\_\_\_

1st 24 hrs. after shot \_\_\_\_\_

Gas \_\_\_\_\_ Cu. Ft.

Dry Hole \_\_\_\_\_

Abandoned \_\_\_\_\_

Date

9/11 191 P. C. O. J. Scout

Map No. 1514 Sec. 12 Twp. 26 R. 4Well No. 48 Engine


Company

Contractor

NORTH

WEST

EAST

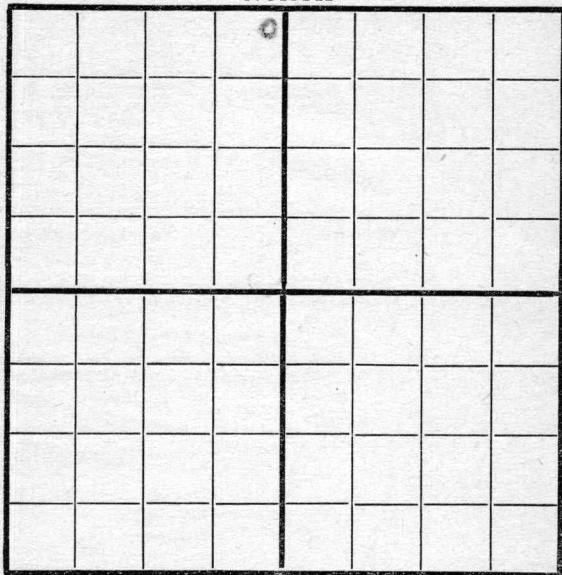

SOUTH

Location

Rig up

Drilling and Remarks:

2250

## RECORD

Cased \_\_\_\_\_ in., \_\_\_\_\_ ft.

Sand \_\_\_\_\_

Gas \_\_\_\_\_

Oil \_\_\_\_\_

Total Depth \_\_\_\_\_

## PRODUCTION

1st 24 hrs. Nat. \_\_\_\_\_

1st 24 hrs. after shot \_\_\_\_\_

Gas \_\_\_\_\_ Cu. Ft.

Dry Hole \_\_\_\_\_

Abandoned \_\_\_\_\_

Date

9/18

191

Scout

Map No. 1514 Sec. 12 Twp. 26 R. 4

Well No. 48 Engine \_\_\_\_\_ Company \_\_\_\_\_

J. E. Michaels Contractor  
El Dorado NORTH 70

|  |  |  |   |  |  |  |  |
|--|--|--|---|--|--|--|--|
|  |  |  | 0 |  |  |  |  |
|  |  |  |   |  |  |  |  |
|  |  |  |   |  |  |  |  |
WEST

EAST

COMPLETED

SOUTH

220 ft - E

RECORD

Location \_\_\_\_\_

Cased \_\_\_\_\_ in., \_\_\_\_\_ ft.

Rig up \_\_\_\_\_

Sand 2420-2472

Drilling and Remarks:

Gas \_\_\_\_\_

Oil \_\_\_\_\_

Total Depth \_\_\_\_\_

PRODUCTION

1st 24 hrs. Nat. \_\_\_\_\_

1st 24 hrs. after shot \_\_\_\_\_

Gas \_\_\_\_\_ Cu. Ft.

Dry Hole \_\_\_\_\_

Abandoned \_\_\_\_\_

Est at  
750  
1366

Date

9/27 1918 C. Conroy Scout