
Form 51—12-17—5M—Mid-West.

Map No. _____ Sec. 12 Twp. 26 R. 4

Well No. 51 Esmpark Farm

Esmpire Company

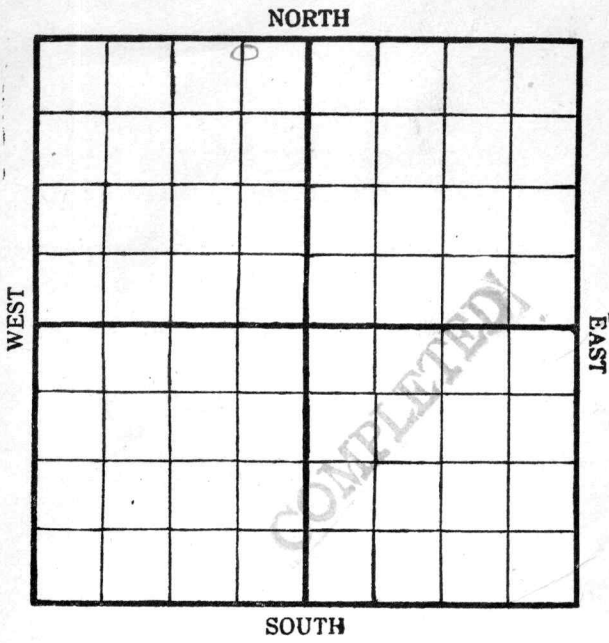

Location _____

Drilling Remarks:

Rig Up _____

Drilling Remarks:

RECORD

Cased _____ in. _____ ft.

Sand _____

Gas _____

Oil _____

Total Depth _____

PRODUCTION

1st 24 hrs. Nat. _____

1st 24 hrs. after shot _____

Gas _____ cu. ft.

Dry Hole _____

Abandoned _____


Form 26—1M Books of 100 Sheets Each—4-15-18

Map No. K14 Sec. 12 Twp. 26 R. 4

Well No. 5 / Empire August

Empire Company

Contractor

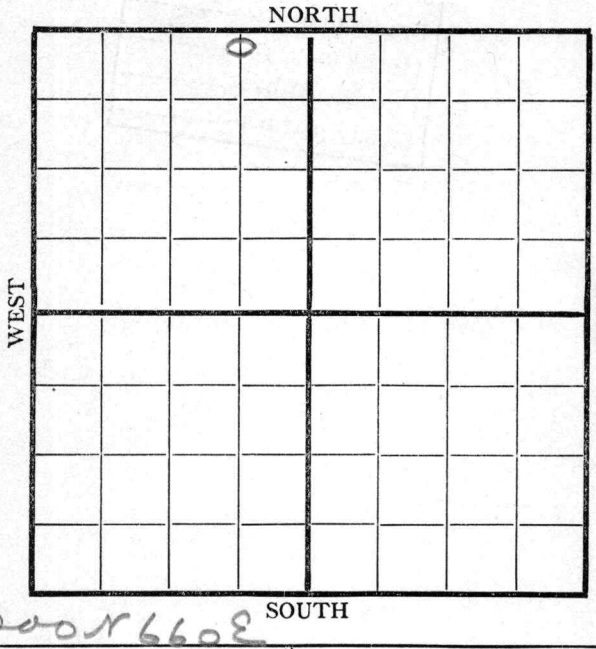

200 N 660 E

Location

Rig up

Drilling and Remarks:

FIRST REPORT

RECORD

Cased in., ft.

Sand

Gas

Oil

Total Depth

PRODUCTION

1st 24 hrs. Nat.

1st 24 hrs. after shot

Gas Cu. Ft.

Dry Hole

Abandoned

Date

9/27 191 8. Scout

Form 26—1M Books of 100 Sheets Each—4-15-18


Map No. K14 Sec. 12 Twp. 26 R. 4

Well No. 5 E August

Empire Company

L.T. Williams Contractor


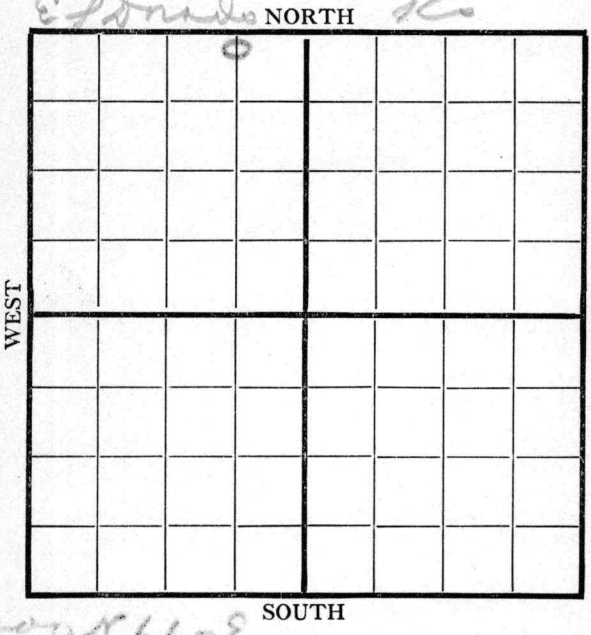

200 N 660 E

Location

Rig up ✓

Drilling and Remarks:

540

RECORD

Cased in., ft.

Sand

Gas

Oil

Total Depth

PRODUCTION

1st 24 hrs. Nat.

1st 24 hrs. after shot

Gas Cu. Ft.

Dry Hole

Abandoned

Date

10/3 191 8. Condy Scout


Form 26—1M Books of 100 Sheets Each—4-15-18

Map No. K14 Sec. 12 Twp. 26 R. 4E

Well No. 5 Engineer

Engineer Company

Contractor

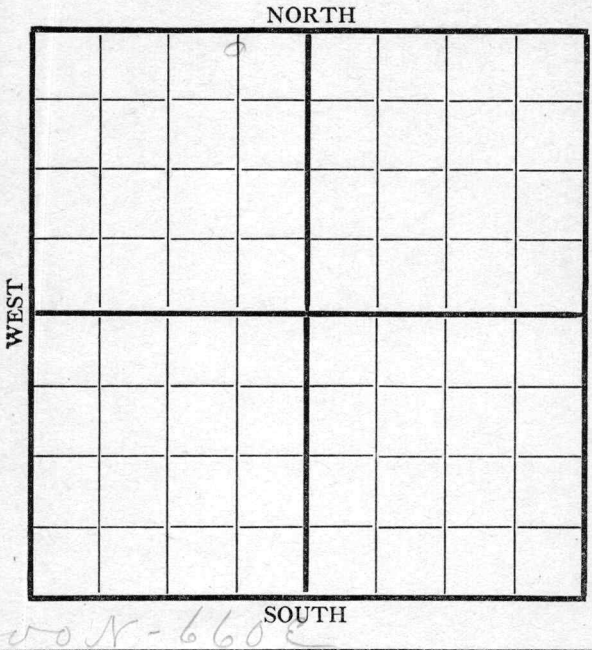

200 N - 660 E

Location

Rig up

Drilling and Remarks:

825

RECORD

Cased in., ft.

Sand

Gas

Oil

Total Depth

PRODUCTION

1st 24 hrs. Nat.

1st 24 hrs. after shot

Gas Cu. Ft.

Dry Hole

Abandoned

Date

10/9 191 8 Cundy Scout


Form 26—1M Books of 100 Sheets Each—4-15-18

Map No. K14 Sec. 12 Twp. 26 R. 4

Well No. 51 E. Wyatt

Empire Company

Contractor

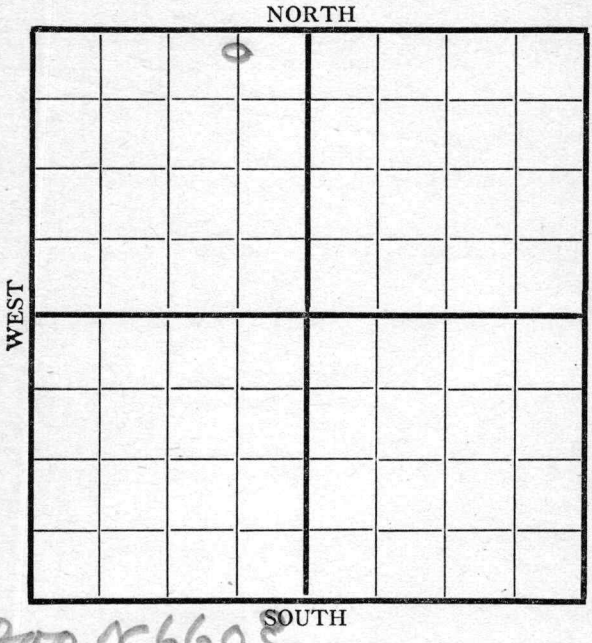

200 N 660 E

Location

Rig up

Drilling and Remarks:

1450

RECORD

Cased in., ft.

Sand

Gas

Oil

Total Depth

PRODUCTION

1st 24 hrs. Nat.

1st 24 hrs. after shot

Gas Cu. Ft.

Dry Hole

Abandoned

Date

10/16 191 S Conley Scout


Form 26—1M Books of 100 Sheets Each—4-15-18

Map No. K14 Sec. 12 Twp. 26 R. 4

Well No. SE August

Company

Contractor

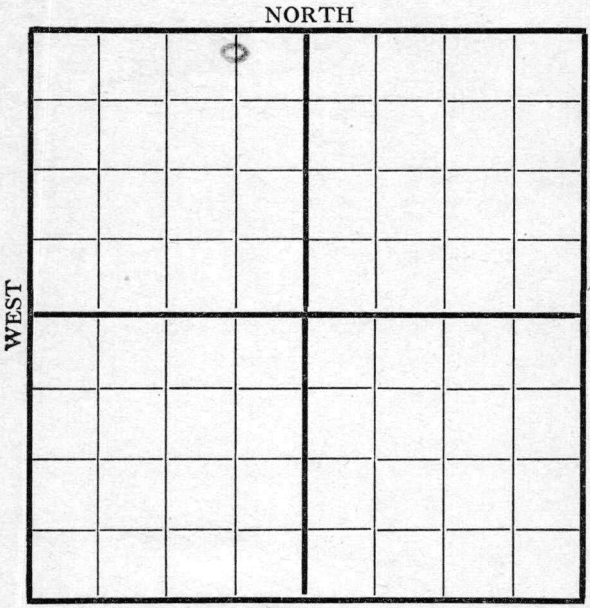


Location

Rig up

Drilling and Remarks:

1800

RECORD

Cased in., ft.

Sand

Gas

Oil

Total Depth

PRODUCTION

1st 24 hrs. Nat.

1st 24 hrs. after shot

Gas Cu. Ft.

Dry Hole

Abandoned

Date

10-23-19 8

Scout


Form 26—1M Books of 100 Sheets Each—4-15-18

Map No. K14 Sec. 12 Twp. 26 R. 4

Well No. 5 Enright

Empire Co. Company

Contractor

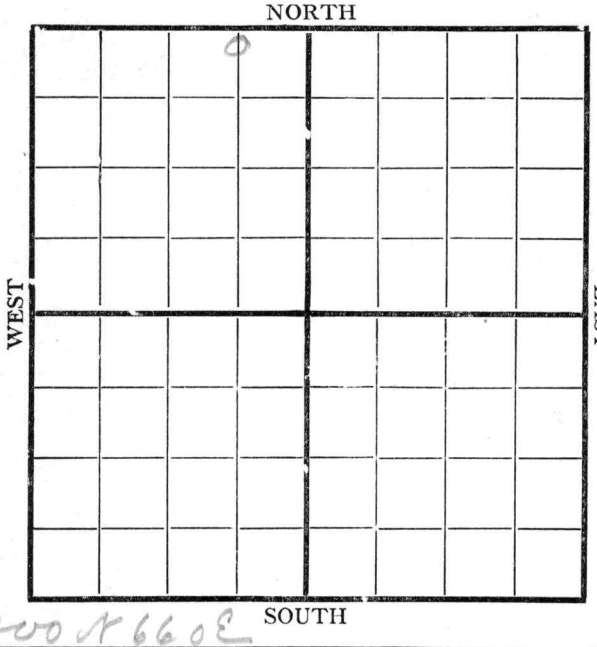

200 N 660 E

Location

Rig up

Drilling and Remarks:

3090

RECORD

Cased in., ft.

Sand

Gas

Oil

Total Depth

PRODUCTION

1st 24 hrs. Nat.

1st 24 hrs. after shot

Gas Cu. Ft.

Dry Hole

Abandoned

Date

10/30 191 8 Scout


Form 26—1M Books of 100 Sheets Each—4-15-18

Map No. K14 Sec. 12 Twp. 26 R. 4

Well No. 5 Enright

Company

Contractor

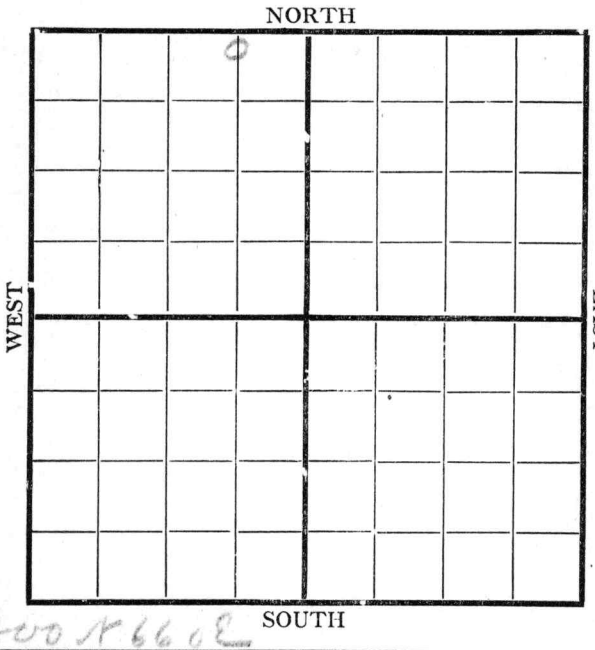

200 N 660 E

Location

Rig up

Drilling and Remarks:

2360

RECORD

Cased in., ft.

Sand

Gas

Oil

Total Depth

PRODUCTION

1st 24 hrs. Nat.

1st 24 hrs. after shot

Gas Cu. Ft.

Dry Hole

Abandoned

Date

11/6 191 8

Scout


Form 26—M Books of 100 Sheets Each—4-15-18

Map No. 514 Sec. 12 Twp. 26 R. 4

Well No. 5 E Bryant

Empire Company

Contractor

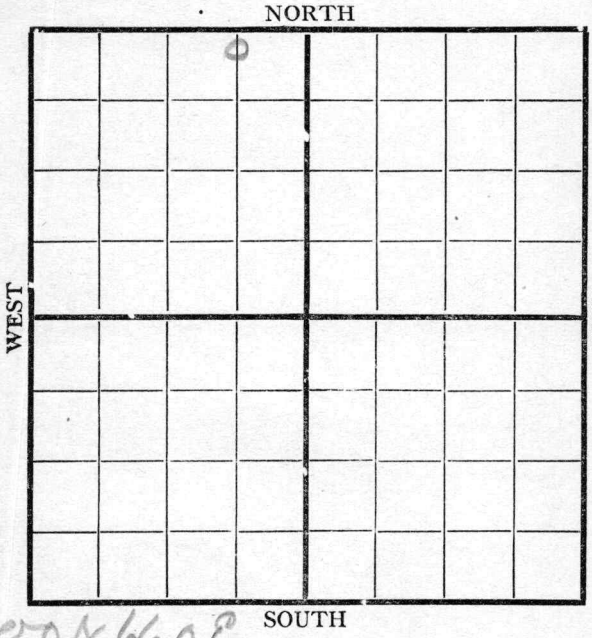

200 N 660 E

Location

Rig up

Drilling and Remarks:

WR 2343

RECORD

Cased in., ft.

Sand

Gas

Oil

Total Depth

PRODUCTION

1st 24 hrs. Nat.

1st 24 hrs. after shot

Gas Cu. Ft.

Dry Hole

Abandoned

Date

11/13 191 8 Condy Scout

Form 26—1M Books of 100 Sheets Each—4-15-18


Map No. K14 Sec. 12 Twp. 26 R. 4

Well No. 5 / E myart

Empire Company

L. T. Williamson Contractor

El Dorado Kans

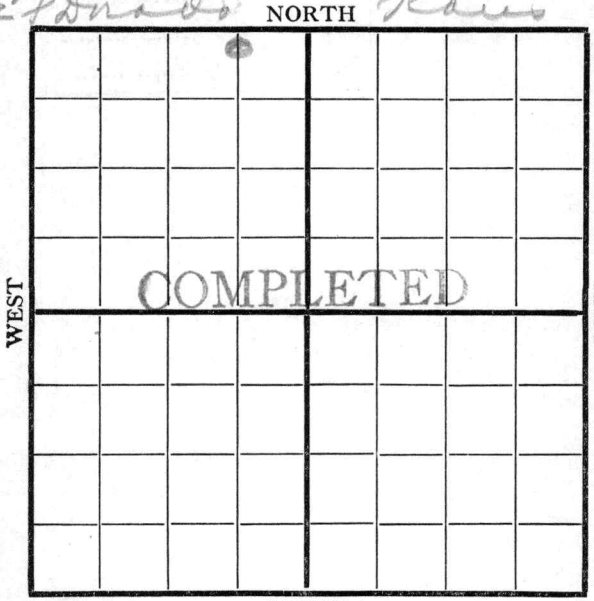

200 N 660 E

Location

Rig up

Drilling and Remarks:

Est at 75

Bbls

RECORD

Cased in., ft.

Sand 2343-2414

Gas

Oil

Total Depth

PRODUCTION

1st 24 hrs. Nat.

1st 24 hrs. after shot

Gas Cu. Ft.

Dry Hole

Abandoned

Date

11/20 191 8 Scout