


Greenwood
Form 51-5M-2-29-34703

Map No. **KANSAS** Sec. *14* Twp. *23* R. *11E*
Well No. *1 - ~~Libbards~~ CURRY* Farm
York State Oil Company

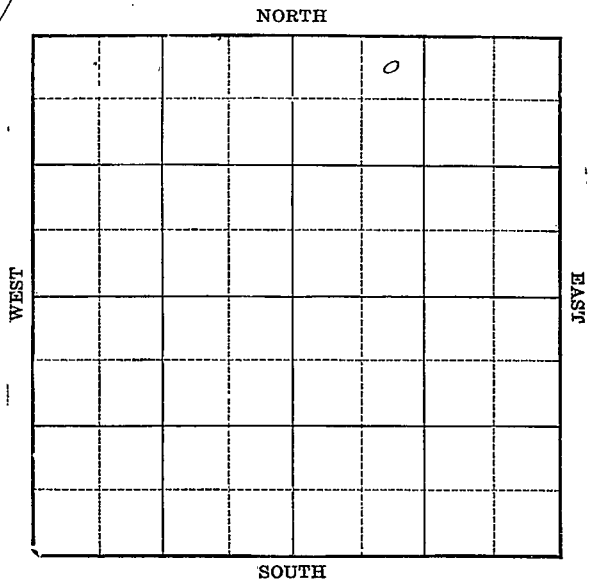

Location _____
Drilling Remarks _____

Rig Up _____
Drilling Remarks _____

RECORD

Cased _____ in. _____ ft.
Sand _____
Gas _____
Oil _____
Total Depth _____

PRODUCTION

1st 24 hrs. Nat. _____
1st 24 hrs. after shot _____
Gas _____ cu. ft. _____
Dry Hole _____
Abandoned _____

Map No. KANSAS Sec. 14 Twp. 23 R. 11^E

Well No. 1- Life bore Farm

York State Oil Company


330 Ft. from N. Line

_____ Ft. from S. Line

_____ Ft. from E. Line

990 Ft. from W. Line

1930

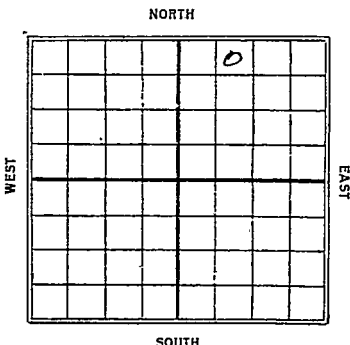

Date

REPORT

7/2

Loc

7/9

7/16

7/23


7/30

Abandon loc

Well No. 1 - 5147 Hite CORRY Farm

NORTH

990 Ft. from W. Line
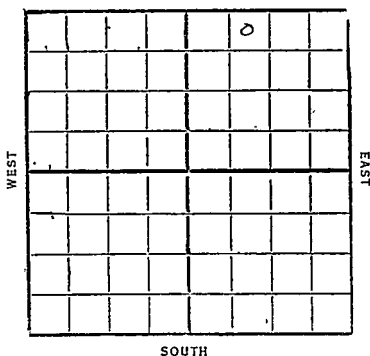
$$\begin{array}{r} 990 \\ 1932 \end{array}$$


REPORT

5/11

Loc

5/18

$$5/25$$

611

6/8

Abandon loc

Greenwood

KANSAS **E**
 Map No. 16 Sec. 14 Twp. 23 R. 11
 Well No. 1 *Life bar*
York State Oil Co Company
 Contractor

FIRST REPORTS

SECTION PLAT

		0	

330 Ft. from N. Line

_____ Ft. from S. Line

_____ Ft. from E. Line

990 Ft. from W. LineLocation ✓

Rig up _____

Drilling and Remarks:

RECORD

Cased _____ in., _____ ft.

Sand _____

Gas _____

Oil _____

Total Depth _____

PRODUCTION

1st 24 hrs. Nat. _____

1st 24 hrs. after shot _____

Gas _____ Cu. Ft.

Dry Hole _____

Abandoned _____

Date

JUL 2 1930

19

CHAS. L. SHERWOOD

Scout

Map No. KANSAS Sec. 14 Twp. 23 R. 11
 Well No. 1 Repebar
Your State Oil Company
 Contractor

COMPLETE

SECTION PLAT

330 Ft. from N. Line

_____ Ft. from S. Line

_____ Ft. from E. Line

990 Ft. from W. Line

ABANDONED

		0	

Location _____

Rig up _____

Drilling and Remarks:

RECORD

Cased _____ in., _____ ft.

Sand _____

Gas _____

Oil _____

Total Depth _____

PRODUCTION

1st 24 hrs. Nat. _____

1st 24 hrs. after shot _____

Gas _____ Cu. Ft.

Dry Hole _____

Abandoned location

Date

JUL 30 1930

19. CHAS. L. SHERWOOD

Scout

Sherwood

16 KANSAS

Map No. _____ Sec. 14 Twp. 23 R. 11 E

Well No. 1 Leeburne

York State Oil Co. Company

Contractor

FIRST REPORTS

330 Ft. from N. Line

Ft. from S. Line

Ft. from E. Line

990 Ft. from W. Line

SECTION PLAT

		0	

Location ✓

Rig up

Drilling and Remarks:

RECORD

Cased _____ in., _____ ft.

Sand _____

Gas _____

Oil _____

Total Depth _____

PRODUCTION

1st 24 hrs. Nat. _____

1st 24 hrs. after shot _____

Gas _____ Cu. Ft.

Dry Hole _____

Abandoned _____

Date

MAY 1 1 1932

CHAS. L. SHERWOOD

192

Scout

Greenwood

E

16 KANSAS

Map No. _____ Sec. 14 Twp. 23 R. 11

Well No. 1

York State Oil Co. Company

Contractor

CORRECTION

330 Ft. from N. Line

_____ Ft. from S. Line

_____ Ft. from E. Line

990 Ft. from W. Line

SECTION PLAT

		0	

Location _____

Rig up _____

Drilling and Remarks:

Chy farm home
to above

RECORD

Cased _____ in., _____ ft.

Sand _____

Gas _____

Oil _____

Total Depth _____

PRODUCTION

1st 24 hrs. Nat. _____

1st 24 hrs. after shot _____

Gas _____ Cu. Ft.

Dry Hole _____

Abandoned _____

Date

MAY 1 8 1932

CHAS. L. SHERWOOD

192

Scout

Greenwood

E

16 **KANSAS** Map No. _____ Sec. *14* Twp. *23* R. *11*

Well No. *1* *Curry*

York State Oil Co Company

Contractor


COMPLETED**SECTION PLAT**

330 Ft. from N. Line

_____ Ft. from S. Line

_____ Ft. from E. Line

990 Ft. from W. Line

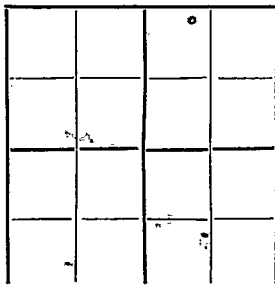ABANDONED

Location _____

Rig up _____

Drilling and Remarks: _____

RECORD

Cased _____ in., _____ ft.

Sand _____

Gas _____

Oil _____

Total Depth _____

PRODUCTION

1st 24 hrs. Nat. _____

1st 24 hrs. after shot _____

Gas _____ Cu. Ft.

Dry Hole _____

Abandoned *Location*

Date

JUN 8 1932 **CHAS. L. SHERWOOD** Scout