


Map No. 15 Sec. 16 Twp. 2 3 R. 11Well No. 3 Hogbe FarmTexas Co. Company

NORTH

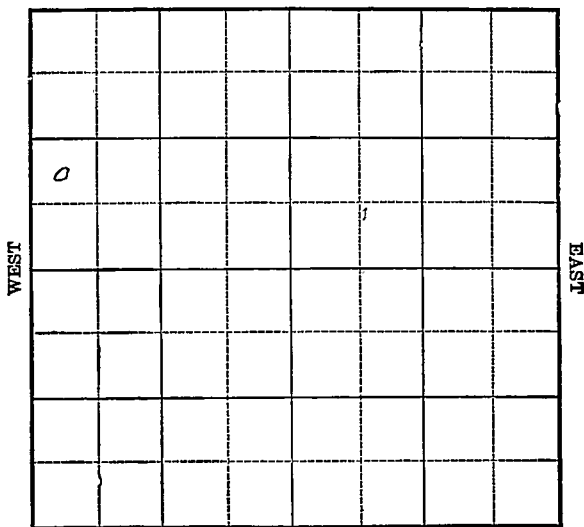

SOUTH

Location _____

Drilling Remarks

Rig Up _____

Drilling Remarks

RECORD

Cased _____ in. _____ ft.

Sand _____

Gas _____

Oil _____

Total Depth _____

PRODUCTION

1st 24 hrs. Nat. _____

1st 24 hrs. after shot _____

Gas _____ cu. ft.

Dry Hole _____

Abandoned _____

16 KANSAS Greenwood
 Map No. _____ Sec. 16 Twp. 23 R. 11

Well No. 3 Fogle
 Texas Co. _____ Company

 Contractor

FIRST REPORTS

SECTION PLAT

o			

_____ Ft. from N. Line

990 _____ Ft. from S. Line

_____ Ft. from E. Line

320 _____ Ft. from W. Line

Location ✓ _____

Rig up _____

Drilling and Remarks:

RECORD

Cased _____ in., _____ ft.

Sand _____

Gas _____

Oil _____

Total Depth _____

PRODUCTION

1st 24 hrs. Nat. _____

1st 24 hrs. after shot _____

Gas _____ Cu. Ft.

Dry Hole _____

Abandoned _____

Date

SEP 29 1926

CHAS. L. SHERWOOD

Scout

16 KANSAS

Map No. _____ Sec. 16 Twp. 23 R. 11

Well No. 3 Fogle

Texas Co _____ Company

_____ Contractor

COMPLETED

_____ Ft. from N. Line

990 _____ Ft. from S. Line

_____ Ft. from E. Line

330 _____ Ft. from W. Line

SECTION PLAT

o			

Location _____

Rig up _____

Drilling and Remarks:

156
150 lbs.

RECORD

Cased _____ in. _____ ft.

Sand 1921-1997

Gas _____

Oil _____

Total Depth 1997

PRODUCTION

1st 24 hrs. Nat. _____

1st 24 hrs. after shot _____

Gas _____ Cu. Ft.

Dry Hole _____

Abandoned _____

Date

DEC 15 1926

CHAS. L. SHERWOOD

192

Scout