

Greenwood

Map No. 15 Sec. 16 Twp. 23 R. 11

Well No. 6 - Fogle Farm

Tetds Co. Company

NORTH

WEST

EAST

SOUTH

Location .....

Drilling Remarks

Rig Up.....

Drilling Remarks

## RECORD

Cased..... in. .... ft.

Sand .....

Gas .....

Oil .....

Total Depth.....

## PRODUCTION

1st 24 hrs. Nat.....

1st 24 hrs. after shot.....

Gas..... cu. ft.

Dry Hole.....

Abandoned .....

Greenwood

Map No. KS Sec. 16 Twp. 23 R. 11Well No. 6 - Fogle Farm  
Texas Co. Company


Ft. from N. Line

580 Ft. from S. Line

Ft. from E. Line

990 Ft. from W. Line

NORTH

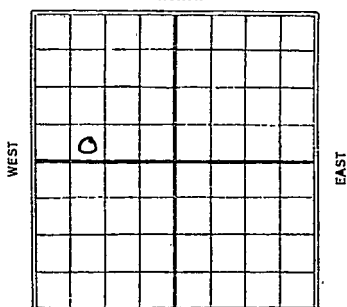

SOUTH

Date

REPORT

11/23 Loc.12/8 rigging up12/15 Drilg 400'12/22 " 103012/30 " 115019271/6 S.D. 11501/12 Sand 1928-1989 120 gte  
50 bbls

16 KANSAS

Greenwood

Map No. 16 Sec. 16 Twp. 23 R. 11

Well No. 6 Fogle

Texaco Co. Company

Contractor

## FIRST REPORTS

## SECTION PLAT

Ft. from N. Line

330 Ft. from S. Line

Ft. from E. Line

990 Ft. from W. Line

|   |  |  |  |
|---|--|--|--|
|   |  |  |  |
| 0 |  |  |  |
|   |  |  |  |
|   |  |  |  |

Location ✓

Rig up

Drilling and Remarks:

## RECORD

Cased \_\_\_\_\_ in., \_\_\_\_\_ ft.

Sand \_\_\_\_\_

Gas \_\_\_\_\_

Oil \_\_\_\_\_

Total Depth \_\_\_\_\_

## PRODUCTION

1st 24 hrs. Nat. \_\_\_\_\_

1st 24 hrs. after shot \_\_\_\_\_

Gas \_\_\_\_\_ Cu. Ft.

Dry Hole \_\_\_\_\_

Abandoned \_\_\_\_\_

Date

NOV 23 1926

192

CHAS. L. SHERWOOD

Scout

Greenwood

16 KANSAS


Map No. 16 Sec. 16 Twp. 23 R. 11

Well No. 6 Fogle Farm

Texas Co.

Company

NORTH

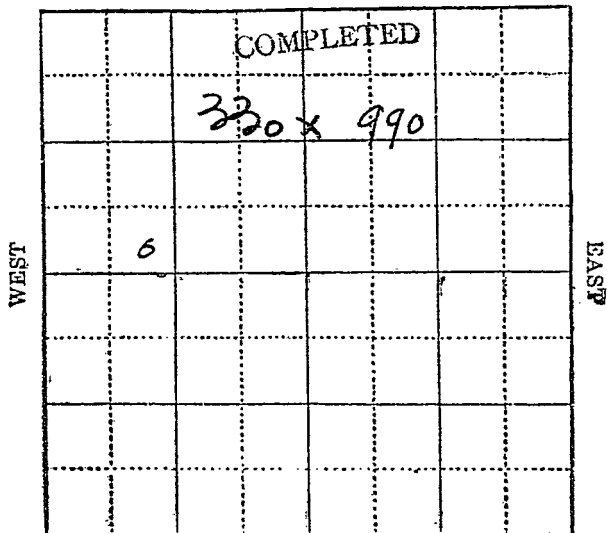

WEST

EAST

SOUTH

Location \_\_\_\_\_

Rig up \_\_\_\_\_

Drilling and Remarks:

120750 lbs.

## RECORD

Cased \_\_\_\_\_ in., \_\_\_\_\_ ft.

Sand 1928-1989

Gas. \_\_\_\_\_

Oil \_\_\_\_\_

Total Depth 1989

## PRODUCTION

1st 24 hrs. Nat. \_\_\_\_\_

1st 24 hrs. after shot. \_\_\_\_\_

Gas \_\_\_\_\_ Cu. Ft.

Dry Hole \_\_\_\_\_

Abandoned \_\_\_\_\_

Date  
JAN 12 1927

CHAS. L. SHERWOOD

192

Scout