


Map No. _____ Sec. 12 Twp. 26 R. 4

Well No. 62 Emery Farm

----- Empire ----- Company

NORTH

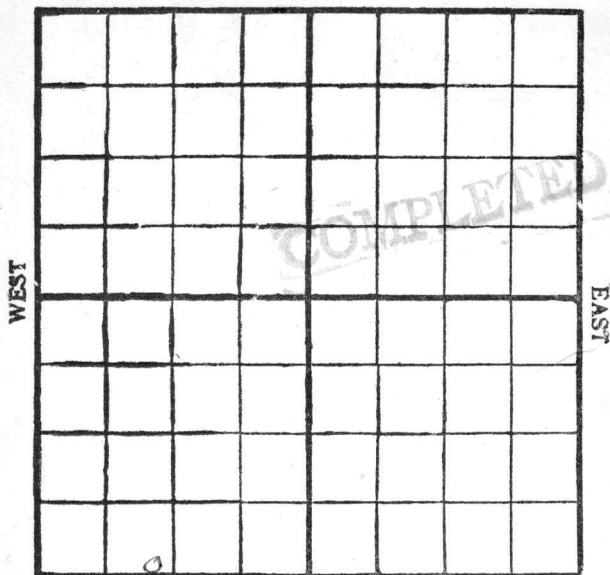

SOUTH

Location -----

Drilling Remarks:

Rig Up -----

Drilling Remarks:

RECORD

Cased_____ in. _____ ft.

Sand -----

Gas -----

Oil _____

Total Depth -----

PRODUCTION

1st 24 hrs. Nat.-----

1st 24 hrs. after shot-----

Gas _____ cu. ft.

Dry Hole -----

Abandoned -----

Map No. 114 Sec. 1 Twp. 26 R. 4

Well No. 6255

Company

Contractor

NORTH

WEST

EAST

SOUTH

RECORD

Location _____

Cased-----in., -----ft.

Rig up.....

Sand

Drilling and Remarks:

Gas _____

Oil _____

Total Depth.....

FIRST REPORT

PRODUCTION

1st 24 hrs. Nat. -----

1st 24 hrs. after shot-----

Gas.....Cu. Ft.

Dry Hole


Abandoned.....

Date _____

191

Scout

Map No. 1514 Sec. 12 Twp. 26 R. 4
 Well No. 628
Engine Company
 Contractor

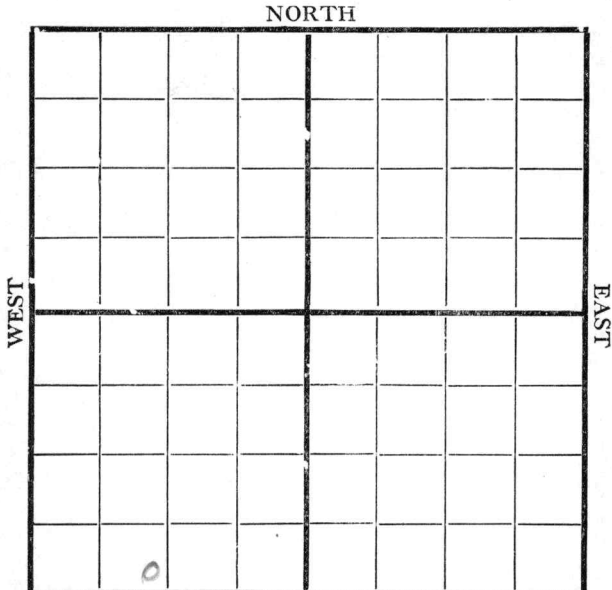

200S-1120 W

Location _____
 Rig up ☒
 Drilling and Remarks:

RECORD

Cased _____ in., _____ ft.
 Sand _____
 Gas _____
 Oil _____
 Total Depth _____

PRODUCTION

1st 24 hrs. Nat. _____
 1st 24 hrs. after shot _____
 Gas _____ Cu. Ft.
 Dry Hole _____
 Abandoned _____

Date 10/30 1918 C. Condy Scout


Map No. 1514 Sec. 12 Twp. 26 R. 4Well No. 62 E myantCompany Engel

Contractor _____

NORTH

WEST

EAST

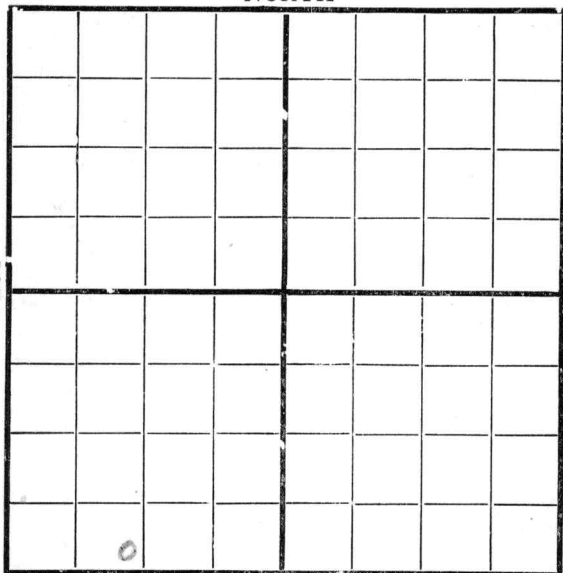

SOUTH

2005-1120 W

Location _____

Rig up ☒ _____

Drilling and Remarks:

RECORD

Cased _____ in., _____ ft.

Sand _____

Gas _____

Oil _____

Total Depth _____

PRODUCTION

1st 24 hrs. Nat. _____

1st 24 hrs. after shot _____


Gas _____ Cu. Ft.

Dry Hole _____

Abandoned _____

Date

11/6 191 J. Candy Scout

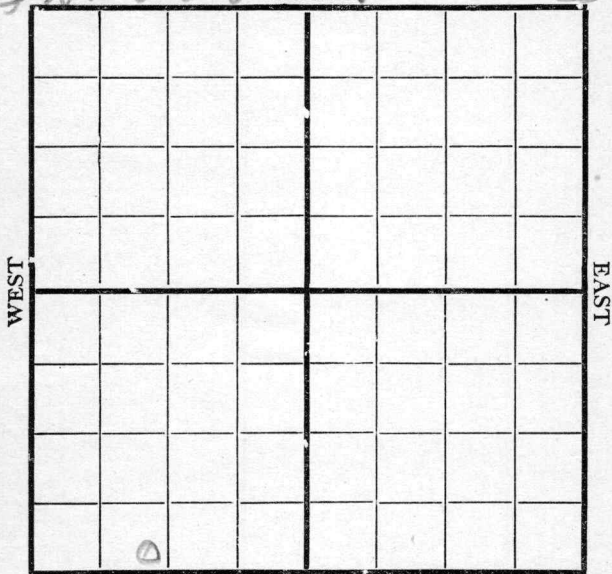Map No. 1514 Sec. 12 Twp. 26 R. 4Well No. 62 CanyonCompany EmpireContractor Shira Drilling CoEl Dorado NORTH Kan

SOUTH

Location _____

Rig up _____

Drilling and Remarks:

RECORD

Cased _____ in., _____ ft.

Sand _____

Gas _____

Oil _____

Total Depth _____

PRODUCTION

1st 24 hrs. Nat. _____

1st 24 hrs. after shot _____

Gas _____ Cu. Ft.

Dry Hole _____

Abandoned _____

Date

11/13 191 J. C. Cordery Scout



Company

Contractor

NORTH

WEST

EAST

SOUTH

Location _____

Rig up-----

Drilling and Remarks:

RECORD

Cased_____in., _____ft.

Sand _____

Gas _____

Oil

Total Depth.....

PRODUCTION

1st 24 hrs. Nat. -----

1st 24 hrs. after shot-----

Gas.....Cu. Ft.

Dry Hole

Abandoned.....

Date _____

191 Scout


Map No. 114 Sec. 12 Twp. 26 R. 4Well No. 62 Empire
Empire Company

Contractor

NORTH

WEST

EAST

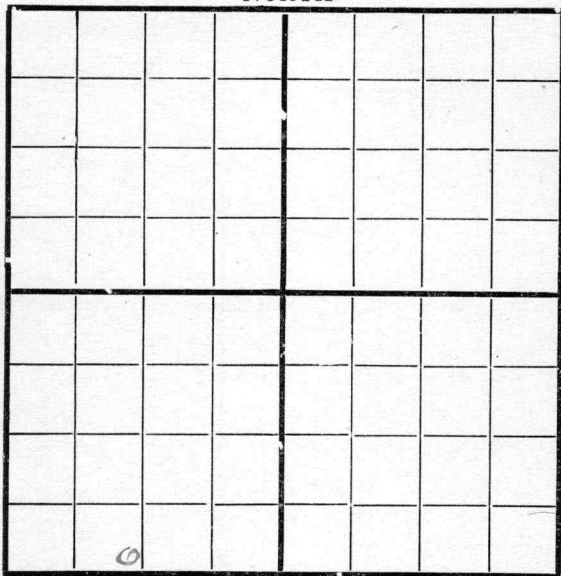

SOUTH

200 Q 1120 W

Location _____

Rig up _____

Drilling and Remarks:

1285

RECORD

Cased _____ in., _____ ft.

Sand _____

Gas _____

Oil _____

Total Depth _____

PRODUCTION

1st 24 hrs. Nat. _____

1st 24 hrs. after shot _____

Gas _____ Cu. Ft.

Dry Hole _____

Abandoned _____


Date

11/27 1918 J. Carley Scout

Map No. 514 Sec. 12 Twp. 26 R. 4Well No. 62 E reportCompany Carpenter

Contractor _____

NORTH

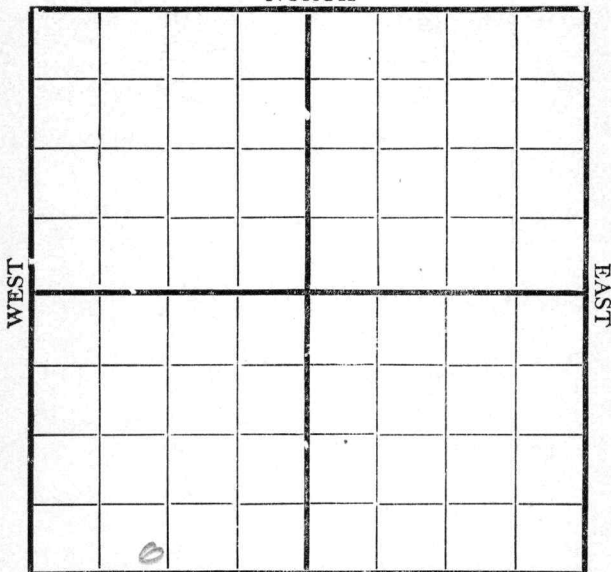

SOUTH

Location _____

Rig up _____

Drilling and Remarks:

1790

RECORD

Cased _____ in., _____ ft.

Sand _____

Gas _____

Oil _____

Total Depth _____

PRODUCTION

1st 24 hrs. Nat. _____

1st 24 hrs. after shot _____

Gas _____ Cu. Ft.


Dry Hole _____

Abandoned _____

Date

12/4 191 8 Conley Scout

Map No. K14 Sec. 12 Twp. 26 R. 4
Well No. 62 Empire
Empire Company
Contractor

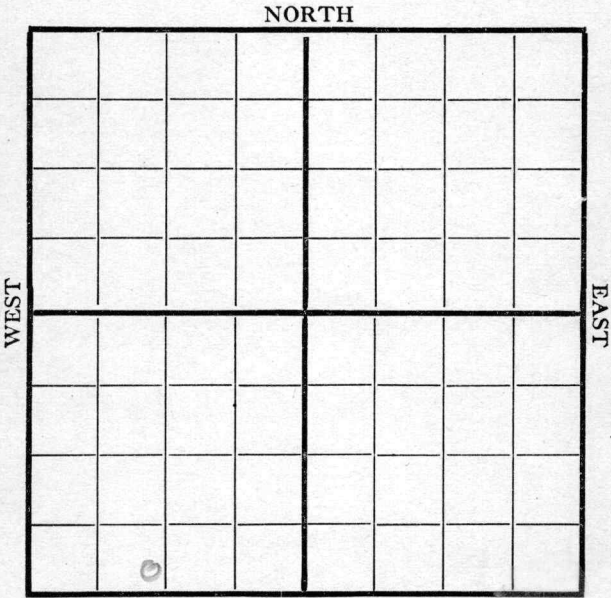


200' 1/20 E

Location _____ Rig up _____ Drilling and Remarks: <u>2075</u>	RECORD
	Cased _____ in., _____ ft. Sand _____ Gas _____ Oil _____ Total Depth _____ PRODUCTION 1st 24 hrs. Nat. _____ 1st 24 hrs. after shot _____ Gas _____ Cu. Ft. Dry Hole _____ Abandoned _____

Date 12/11 1918 S. C. C. C. Scout

Map No. K/4 Sec. 12 Twp. 26 R. 4Well No. 628 myartCompany EmpireContractor Shira Drilling CoEl Dorado NORTH Texas

WEST

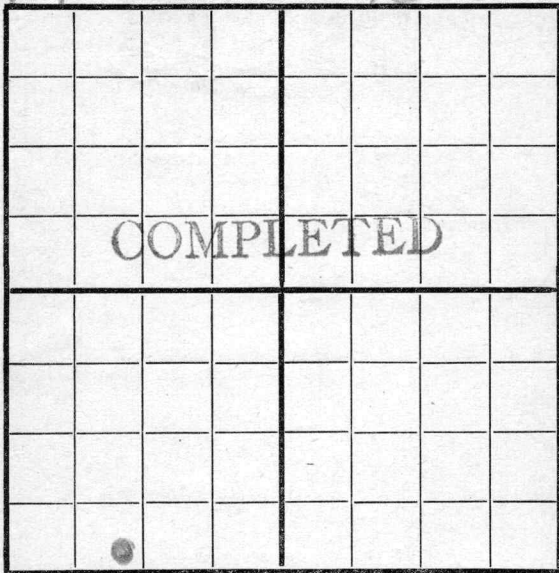

EAST

SOUTH

Location _____

Rig up _____

Drilling and Remarks:

Swabbing
300 Bbl

RECORD

Cased _____ in., _____ ft.

Sand 2343-2351

Gas _____

Oil _____

Total Depth _____

PRODUCTION

1st 24 hrs. Nat. _____

1st 24 hrs. after shot _____

Gas _____ Cu. Ft.

Dry Hole _____

Abandoned _____

Date

12/18 191 8 Carley Scout