
Greenwood KANSAS

SECTION 17 TOWNSHIP 23 RANGE 11 E

WELL NO. #1 McGilvray

COMPANY Hart & Cross Drlg.

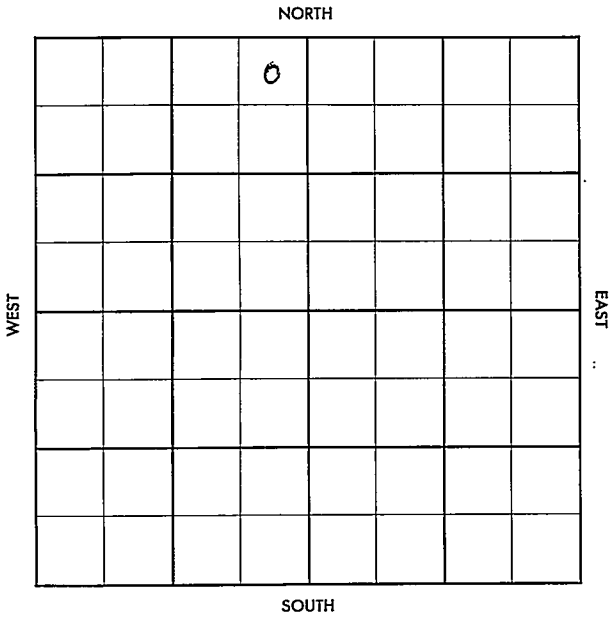

FORM 504-3 SUNRAY

Greenwood KANSAS

SEC.	TWP.	R.
17	23	11E

WELL NO.

#1 m McGilvray FARM

COMPANY

Hart & Cross Drlg.

CONTRACTOR


Seely-Wick

_____ Ft. from N. Line

_____ Ft. from S. Line

_____ Ft. from E. Line

_____ Ft. from W. Line

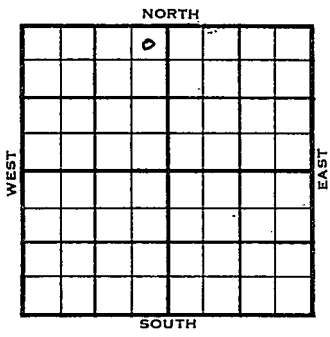

m Ne NE NW

1955	ELEVATION REPORT
11/16	Loc

DX-78

FORM 513 REV. SUNRAY

County Greenwood Elev.

Sec. 17 Twp. 23 Rge. 11E

Company Hart & Cross Drlg.

Farm Name McGilvray No. 1


TOPS	DEPTH	LOG	DATUM
Anh.			
Tp.			
H.			
Tr.			
Dg.			
B.L.			
L.			
K.C.			
B.K.C.			
Ce.			
C.			
M.			
M.			
K.			
Mz.			
Mo.			
V.			
S.			
S.			
A			
R.			
P€.			
G.			
T.D.			

Loc. in Sec. NE NE NW

Geol.

Contr.

Pool Seely-Wick

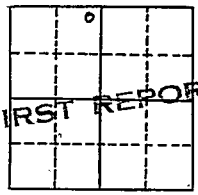

Date Comm. NOV 16 1955

Location

Co. Lse. No. Sec. T. R.