

Map No. _____ Sec. 11 Twp. 26 R. 4Well No. 11-Orban FarmSinclair-Markham Company

NORTH

WEST

EAST



SOUTH

Location _____

Rig Up _____

Drilling Remarks:

Drilling Remarks:

RECORD

Cased _____ in. _____ ft.

Sand _____

Gas _____

Oil _____

Total Depth _____

PRODUCTION

1st 24 hrs. Nat. _____

1st 24 hrs. after shot _____

Gas _____ cu. ft.


Dry Hole _____

Abandoned _____

Map No. _____ Sec. 11 Twp. 26 R. 4Well No. 11 Orban _____ Farm _____Shulain _____ Company _____

NORTH

WEST

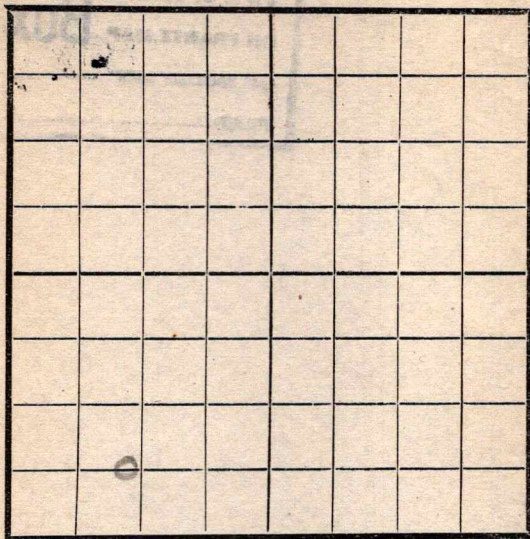

EAST

SOUTH

Location _____

Rig Up _____

Drilling and remarks

RECORD

Cased _____ in. _____ Ft.

Sand _____

Gas _____

Oil _____

Total Depth _____

PRODUCTION

1st 24 hrs. Nat. _____

1st 24 hrs. after shot _____

Gas _____ Cu. Ft.

Dry Hole _____

Abandoned _____


Date

8/9, 1917 Candy _____ Scout _____

Map No. _____ Sec. 11 Twp. 26 R. 4
 Well No. 11-Orbway _____ Far _____
Sinclair _____ Company _____

NORTH

WEST

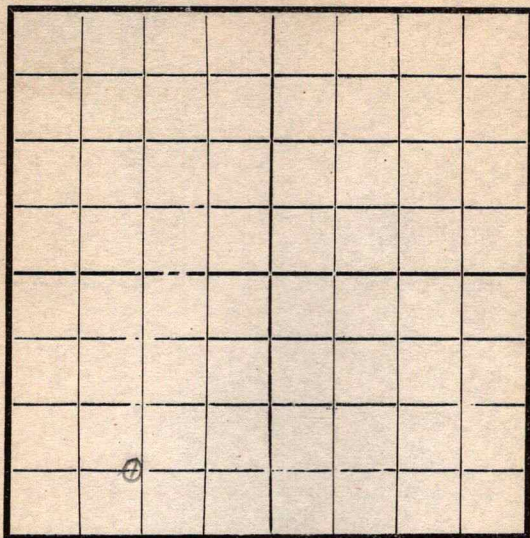

EAST

SOUTH

Location _____
 Rig Up _____
 Drilling and remarks

at 900.

RECORD

Cased _____ in. _____ Ft.
 Sand _____
 Gas _____
 Oil _____
 Total Depth _____

PRODUCTION

1st 24 hrs. Nat. _____
 1st 24 hrs. after shot _____
 Gas _____ Cu. Ft.
 Dry Hole _____
 Abandoned _____

Date

8-24-1917

Lantz


Scout

Map No. _____ Sec. 11 Twp. 26 R. 4
 Well No. 11 Osborn Farm _____
Mackham et al Company

NORTH

WEST

EAST

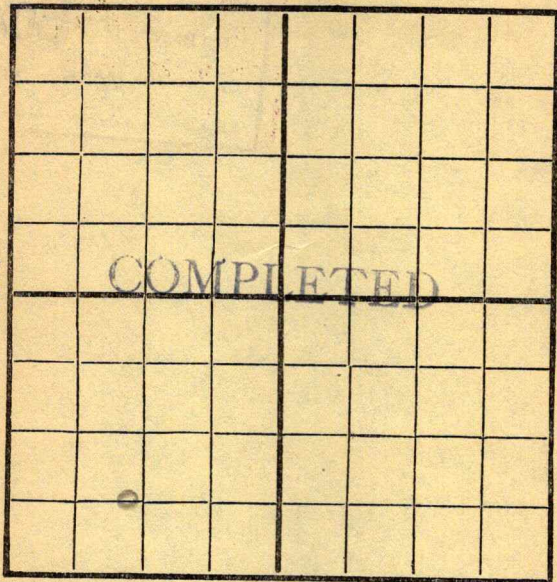

SOUTH

Location _____

Rig Up _____

Drilling and remarks

Est at
600
366

RECORD

Cased _____ in. _____ Ft.

Sand 2337-2388

Gas _____

Oil _____

Total Depth _____

PRODUCTION

1st 24 hrs. Nat. _____

1st 24 hrs. after shot _____

Gas _____ Cu. Ft.

Dry Hole _____

Abandoned _____

Date

9/19, 1917, Amberg Scout