

Greenwood


KANSAS

SECTION 17 TOWNSHIP 23 RANGE 11 E

WELL NO. #31 ~~Mc~~ McGilvray

COMPANY Phillips Pet.

NORTH

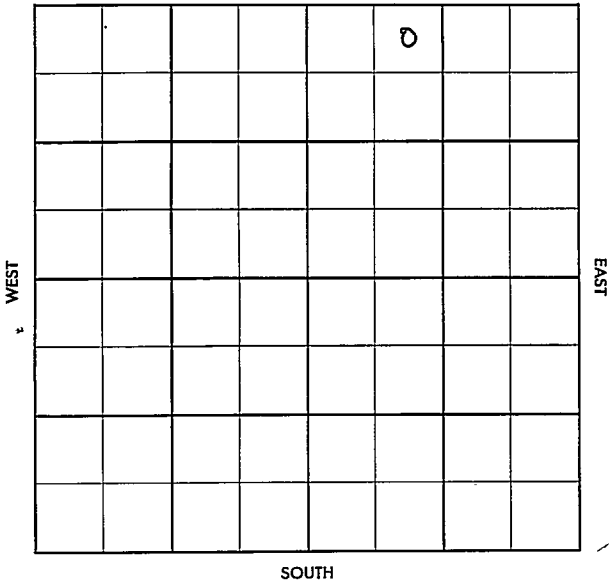

Greenwood

E

KANSAS

SEC.	TWP.	R.
17	23	11E

WELL NO.

#31 McGilvay

FARM

COMPANY

Phillips Pet

CONTRACTOR

McGinnis

Seely Wich


_____ Ft. from N. Line

_____ Ft. from S. Line

_____ Ft. from E. Line

_____ Ft. from W. Line

NE NW NE

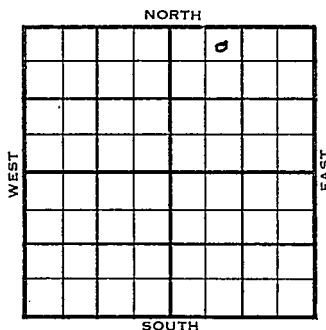

1955	ELEVATION 1226	REPORT
------	-------------------	--------

11/2 M I R

11-30 Comm. 11-3-55
 8 5/8" @ 95/60
 5 1/2" @ 1958/175
 CO to 2027
 S/ 2 1/2 BO, 1 1/2 BWPH, frac
 F/ 100 BO 24 hrs.,
 F/ 75 BO 18 hr.
 F/ 100 BO 16 hrs.
 F/ 100 BO 18 hrs.
 Comp. F/ 100 BOPD
 L. 1038
 K.C. 1302
 BKC 1464
 Marm 1592
 Ce 1755
 Ardmore 1836
 Bart 1958
 TD 2027'

COMPLETED

County

Greenwood

Elev.

1226

See:

17

Two

23

Res.

11E

Company

Phillips Pet.

Farm Name

McGilvray

No.

31

TOPS	DEPTH	LOG	DATUM	Loc. in Sec.
Anh.				NE NW NE
Tr.				
H.				
Tr.				
Dg.				
Bl.				
L.				Geol.
K.C.				
B.K.C.				Contr.
Ce.				McGinnis
C.				
M.				Pool
M.				Seely-Wich
K.				
Mz.				
Mq.				
V.				
S.				
S.				
A				
R.				
Pe.				FIRST REPORT
G.				NOV 2 '55
T.D.				

Date Comm.

M I R

Co.

Use

No.

566

1

天

