

Section 11 Township 26 Range 4E

Well No. #1 Urban Est.

Company White & Ellis

NORTH

WEST

EAST

		0					

SOUTH

Butler

KANSAS

Sec. 11 Twp. 26 R. 4E ✓

Well No. #1 Orban Est. Farm

White & Ellis Company

Contractor

Miscellaneous

 Ft. from N. Line

990'


 Ft. from S. Line

990'

 Ft. from E. Line

 Ft. from W. Line

NW SE NW

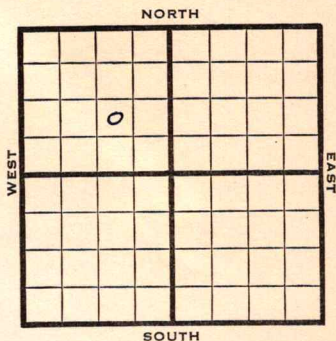

1950

Elev 1377

REPORT

4/26

8" @ 60'

Drlg. 188'

5/19

TD 2004

8" @ 60

K.C. 1962

5½" @ 1959

35 BOPD

Completed

COMPLETED

Map No. _____ Sec. 11 Twp. 26 R. 4EWell No. 1 Orban Est.White & Ellis Company

Contractor _____

NW SE NW

SECTION PLAT



_____ Ft. from N. Line

990 Ft. from S. Line990 Ft. from E. Line

_____ Ft. from W. Line

Butler County

Gulf farmout

Location _____

Rig up _____

Drilling and Remarks:

8" @ 60

drlg. 188

RECORD

Cased _____ in., _____ ft.

Sand _____

Gas _____

Oil _____

Total Depth _____

PRODUCTION

1st 24 hrs. Nat. _____

1st 24 hrs. after shot _____

Gas _____ Cu. Ft.

Dry Hole _____

Abandoned _____

Date

APR 26 1950 19J. E. TYRA Scout

Kansas

Map No. _____ Sec. 11 Twp. 26 R. 4EWell No. 1 Urban Est.

White & Ellis

Company

Contractor


NW SE NW

E. 1377
SECTION PLAT

_____ Ft. from N. Line

990 Ft. from S. Line990 Ft. from E. Line

_____ Ft. from W. Line

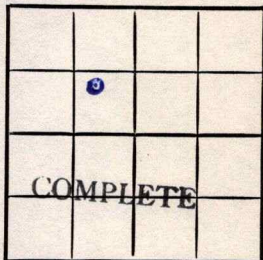

Butler

Location _____

Rig up _____

Drilling and Remarks:

8" @ 60
K.C. 1962
5 1/2" @ 1959
35 BOPD

RECORD

Cased _____ in., _____ ft.

Sand _____

Gas _____

Oil _____

Total Depth 2004

PRODUCTION

1st 24 hrs. Nat. _____

1st 24 hrs. after shot _____

Gas _____ Cu. Ft.

Dry Hole _____

Abandoned _____

Date

MAY 10 1950

19

J. E. TYRA Scout