

Map No. _____ Sec. 11 Twp. 26 R. 4
 Well No. 19-M. Orban Farm _____
Carter Company _____

NORTH

SOUTH

WEST

EAST

COMPLETED

Location _____

Rig Up _____

Drilling Remarks:

Drilling Remarks:

RECORD

PRODUCTION

Cased _____ in. _____ ft.

Sand _____

Gas _____

Oil _____

Total Depth _____

1st 24 hrs. Nat. _____

1st 24 hrs. after shot _____

Gas _____ cu. ft.


Dry Hole _____

Abandoned _____

Map No. _____ Sec. 11 Twp. 76 R. 4Well No. 19. M. Urban Farm _____Carter Company _____

NORTH

WEST

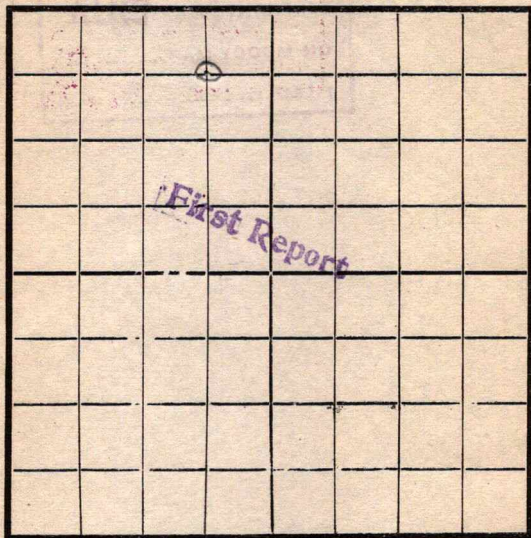

EAST

SOUTH

Location _____

Rig Up _____

Drilling and remarks

Timbers

RECORD

Cased _____ in. _____ Ft.

Sand _____

Gas _____

Oil _____

Total Depth _____

PRODUCTION

1st 24 hrs. Nat. _____

1st 24 hrs. after shot _____

Gas _____ Cu. Ft.

Dry Hole _____

Abandoned _____


Date

8-21, 1917 Lantz Scout

Map No. _____ Sec. 11 Twp. 26 R. 4

Well No. 19 Orban Farm _____
Center Company _____

NORTH

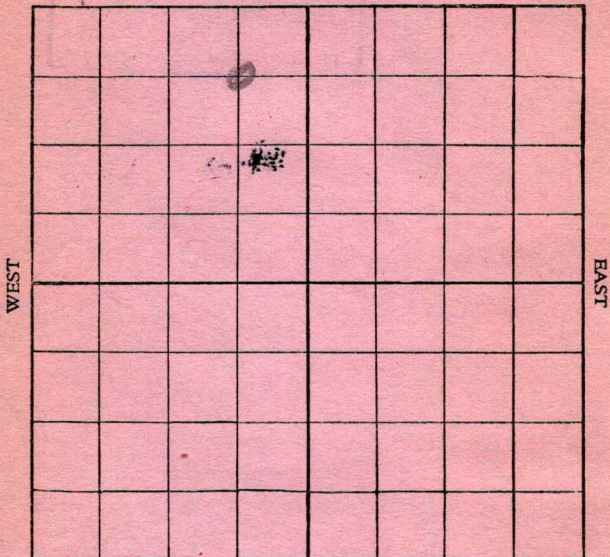

SOUTH

Location _____

Rig up _____

Drilling and remarks:

1305'

FIRST REPORT

RECORD

Cased _____ in. _____ Ft.

Sand _____

Gas _____

Oil _____

Total Depth _____

PRODUCTION

1st 24 hrs. Nat. _____

1st 24 hrs. after shot. _____

Gas _____ Cu. Ft.

Dry Hole _____

Abandoned _____


Date

10/9, 1917, Carney Scout

Map No. _____ Sec. 11 Twp. 26 R. 4
 Well No. 19. Orlean Farm _____
Center Company _____

NORTH

WEST

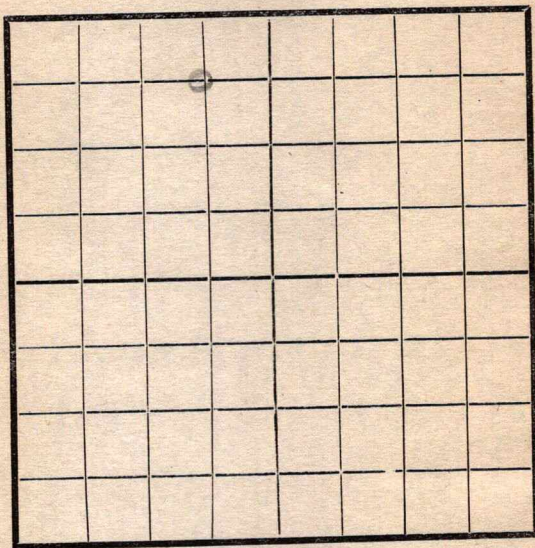

EAST

SOUTH

Location _____
 Rig Up _____
 Drilling and remarks

1640

RECORD

Cased _____ in. _____ Ft.
 Sand _____
 Gas _____
 Oil _____
 Total Depth _____

PRODUCTION

1st 24 hrs. Nat. _____
 1st 24 hrs. after shot _____
 Gas _____ Cu. Ft.
 Dry Hole _____
 Abandoned _____


Date

10/17, 1917 Center Scout _____

Map No. _____ Sec. 11 Twp. 26 R. 4
 Well No. 190 Farm _____
Carter Company _____

NORTH

WEST

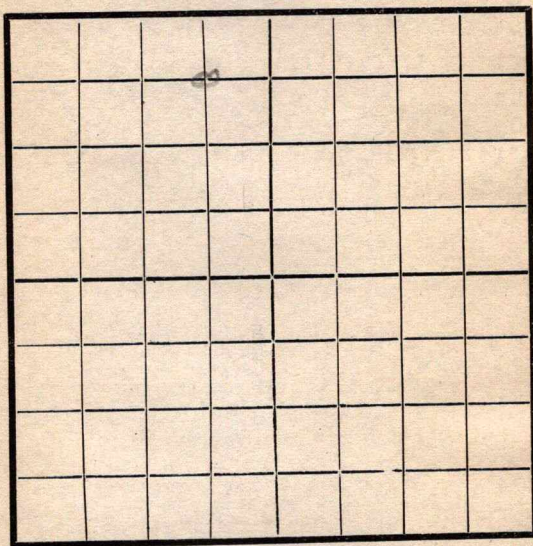

EAST

SOUTH

Location _____
 Rig Up _____
 Drilling and remarks

2015

RECORD

Cased _____ in. _____ Ft.
 Sand _____
 Gas _____
 Oil _____
 Total Depth _____

PRODUCTION

1st 24 hrs. Nat. _____
 1st 24 hrs. after shot _____
 Gas _____ Cu. Ft.
 Dry Hole _____
 Abandoned _____


Date

10/24, 1917 Candiff Scout

Map No. _____ Sec. 11 Twp. 26 R. 4Well No. 19 Orlean Farm __________Center Company _____

NORTH

WEST

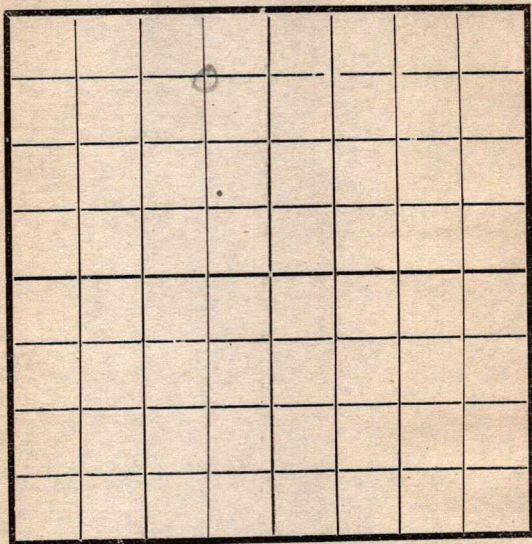

EAST

SOUTH

Location _____

Rig Up _____

Drilling and remarks

2165

RECORD

Cased _____ in. _____ Ft.

Sand _____

Gas _____

Oil _____

Total Depth _____

PRODUCTION

1st 24 hrs. Nat. _____

1st 24 hrs. after shot _____

Gas _____ Cu. Ft.

Dry Hole _____

Abandoned _____

Date


10/31, 191 7 Canby Scout _____

Map No. _____ Sec. 11 Twp. 26 R. 4Well No. 1908100 _____ Farm _____

_____ Company _____

NORTH

WEST

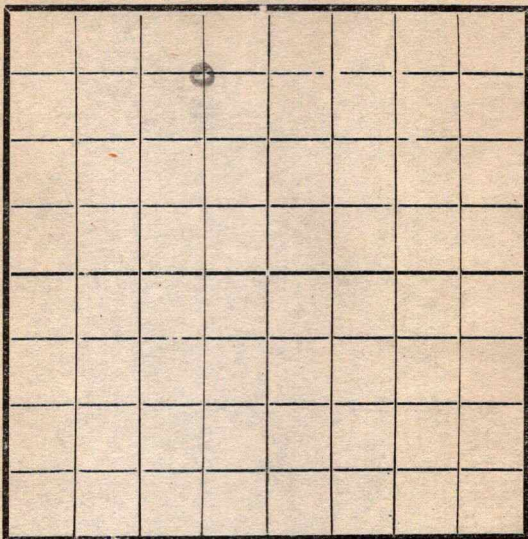

EAST

SOUTH

Location _____

Rig Up _____

Drilling and remarks

2275

RECORD

Cased _____ in. _____ Ft.

Sand _____

Gas _____

Oil _____

Total Depth _____

PRODUCTION

1st 24 hrs. Nat. _____

1st 24 hrs. after shot _____

Gas _____ Cu. Ft.

Dry Hole _____

Abandoned _____


Date

11-7, 1917 Carly _____ Scout _____

Map No. _____ Sec. 11 Twp. 26 R. 4
 Well No. 19 Osborn Farm _____
Carter Company _____

NORTH

WEST

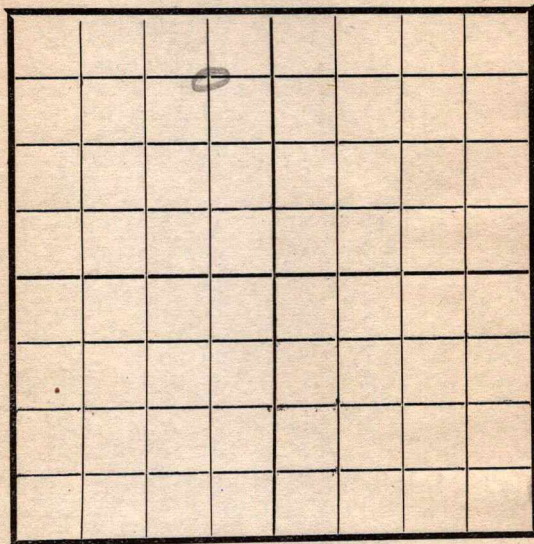

EAST

SOUTH

Location _____
 Rig Up _____
 Drilling and remarks

2414

RECORD

Cased _____ in. _____ Ft.
 Sand _____
 Gas _____
 Oil _____
 Total Depth _____

PRODUCTION

1st 24 hrs. Nat. _____
 1st 24 hrs. after shot _____
 Gas _____ Cu. Ft.
 Dry Hole _____
 Abandoned _____


Date

11/14, 1917 Carter Scout _____

Map No. K14 Sec. 11 Twp. 26 R. 4Well No. 19 Urban Farm
Center Company

NORTH

WEST

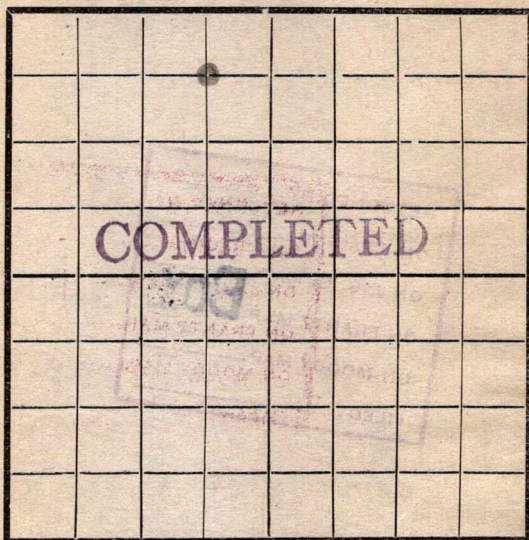

EAST

SOUTH

Location -----

Rig Up -----

Drilling and remarks

Est at300 Bbl

RECORD

Cased ----- in. ----- Ft

Sand 2354-2414

Gas -----

Oil -----

Total Depth -----

PRODUCTION

1st 24 hrs. Nat. -----

1st 24 hrs. after shot -----

Gas ----- Cu. Ft

Dry Hole -----

Abandoned -----

Date

11/21, 1917 Conley Scout