County	Russell
Farm	Jellison No. 5
Company	W. C. McBride, Inc.
Sec.	19
Twp.	13 S
Range	14 W

6	5	4	3	2	1
7	8	9	10	11	12
18	17	16	15	14	13
19	20	21	22	23	24
30	29	28	27	26	25
31	32	33	34	35	36

NW c SW

Elev. _____ T.D. 3270

Date Drilled 1-14-40

Correlation by _____
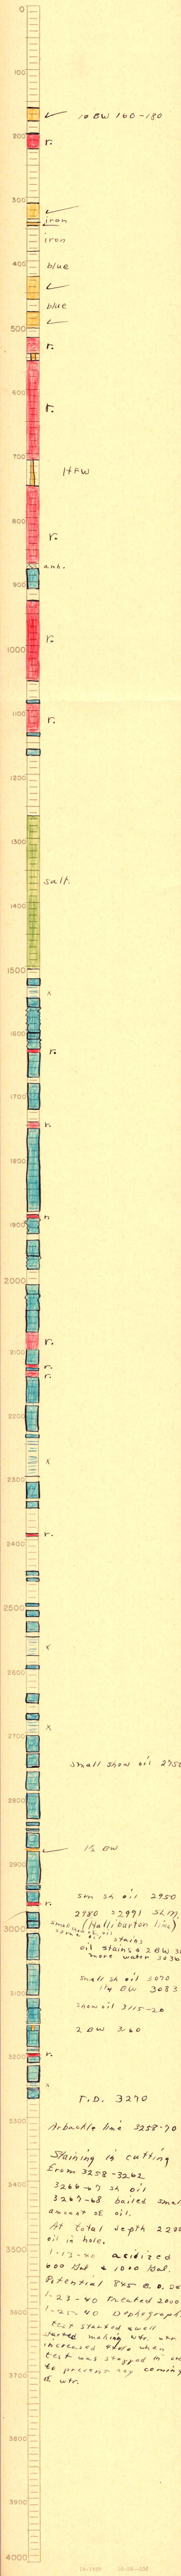
Pot. 845 B.