


Texas Co.

STATE <u>Kansas</u>		COMPANY <u>Westgate Greenland</u>	
COUNTY <u>Reno</u>		FARM <u>Johns</u>	WELL NO. <u>#1-B</u>
T. <u>22s</u>	R. <u>5w</u>	DIVISION	DISTRICT
SURVEY		KIND OF RIG	
		COMMENCED <u>2-13-39</u>	
		COMPLETED <u>3-21-39</u>	
		REMARKS <u>SESE SW</u>	
		ELEV. <u>1544</u>	
PRODUCTION NORMAL <u>621B.</u> SETTLED			

CASING AND SCREEN RECORD

12 1/2" — 160'
7" — 3905'

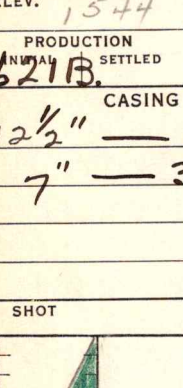