


Map No. K14 Sec. 25 Twp. 26 R. 4Well No. 4 Kasper Farm
Magnolia Petroleum Company

NORTH

WEST

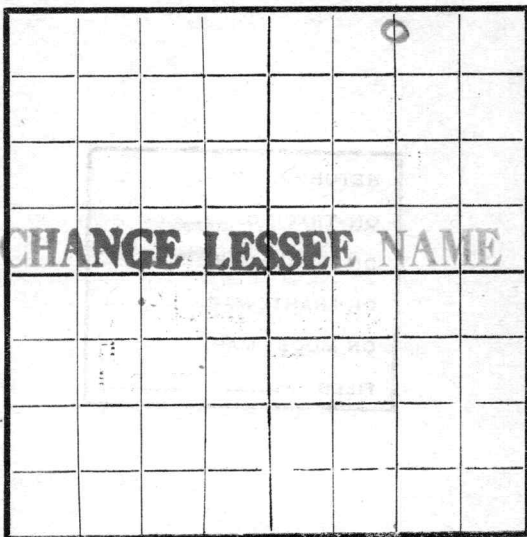

EAST

SOUTH

Location ✓Rig Up ✓

Drilling and remarks

RECORD

Cased _____ in _____ Ft.

Sand _____

Gas _____

Oil _____

Total Depth _____

PRODUCTION

1st 24 hrs. Nat. _____

1st 24 hrs. after shot _____

Gas _____ Cu. Ft.

Dry Hole _____

Abandoned _____


FIRST REPORT

Date

5/22, 1918 Candley Scout

Map No. _____ Sec. 25 Twp. 36 R. 4Well No. 47 Karpisunquama CompanyKeeler & Mc Gibb ContractorE. D. Howard NORTH KS

WEST

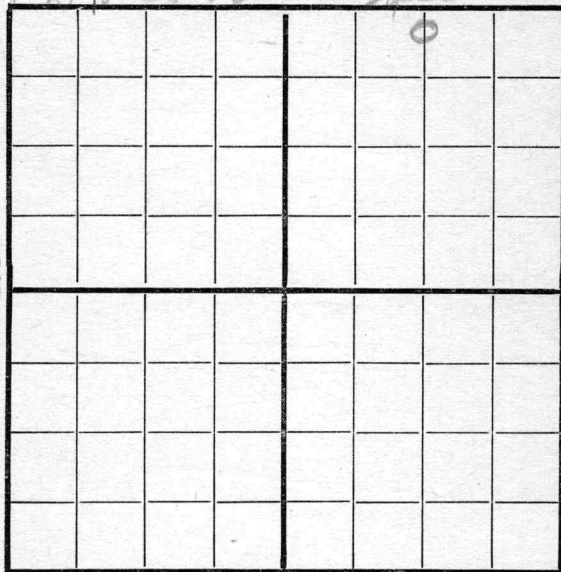

EAST

SOUTH

Location _____

Rig up _____

Drilling and Remarks:

250**RECORD**

Cased _____ in., _____ ft.

Sand _____

Gas _____

Oil _____

Total Depth _____

PRODUCTION

1st 24 hrs. Nat. _____

1st 24 hrs. after shot _____

Gas _____ Cu. Ft.


Dry Hole _____

Abandoned _____

Date

6/28 1918 C. Condy Scout

Map No. _____ Sec. 25 Twp. 26 R. 4
 Well No. 425
 _____ Company
 _____ Contractor

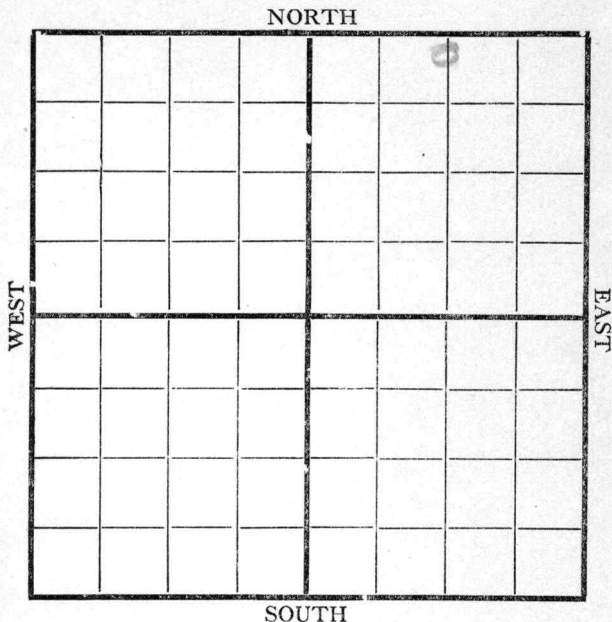

	RECORD
Location _____	Cased _____ in., _____ ft.
Rig up _____	Sand _____
Drilling and Remarks:	Gas _____
<u>625</u>	Oil _____
	Total Depth _____
	=====
	PRODUCTION
	1st 24 hrs. Nat. _____
	1st 24 hrs. after shot _____
	Gas _____ Cu. Ft.
	Dry Hole _____
	Abandoned _____

Date 6/19 1918 Carly Scout

Map No. _____ Sec. 25 Twp. 26 R. 4


Well No. 4

Magnum Petroleum Company

Contractor _____

NORTH

WEST

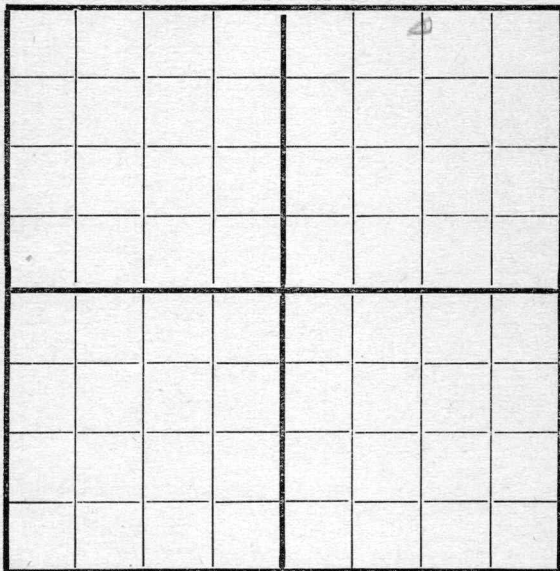

EAST

SOUTH

Location _____

Rig up _____

Drilling and Remarks:

1350

RECORD

Cased _____ in., _____ ft.

Sand _____

Gas _____

Oil _____

Total Depth _____

PRODUCTION

1st 24 hrs. Nat. _____

1st 24 hrs. after shot _____

Gas _____ Cu. Ft.

Dry Hole _____

Abandoned _____

Date

6/26 1918 C. C. Conley Scout

Map No. _____ Sec. 25 Twp. 26 R. 4Well No. 4 Kessler_____
Company_____
Contractor

NORTH

WEST

EAST

SOUTH

Location _____

Rig up _____

Drilling and Remarks:

1860

RECORD

Cased _____ in., _____ ft.

Sand _____

Gas _____

Oil _____

Total Depth _____

PRODUCTION

1st 24 hrs. Nat. _____

1st 24 hrs. after shot _____

Gas _____ Cu. Ft.

Dry Hole _____

Abandoned _____

Date

7/3

191

J. C. Cady

Scout

Map No. _____ Sec. 25 Twp. 26 R. 4Well No. 4 KonglenMay P. O. Co. Company_____
Contractor

NORTH

WEST

EAST

SOUTH

Location _____

Rig up _____

Drilling and Remarks:

RECORD

Cased _____ in., _____ ft.

Sand _____

Gas _____

Oil _____

Total Depth _____

PRODUCTION

1st 24 hrs. Nat. _____

1st 24 hrs. after shot _____

Gas _____ Cu. Ft.

Dry Hole _____

Abandoned _____

Date

7/10 191 S. C. Condit Scout


Map No. _____ Sec. 25 Twp. 26 R. 4

Well No. 47

Wagoner Company

Contractor

NORTH

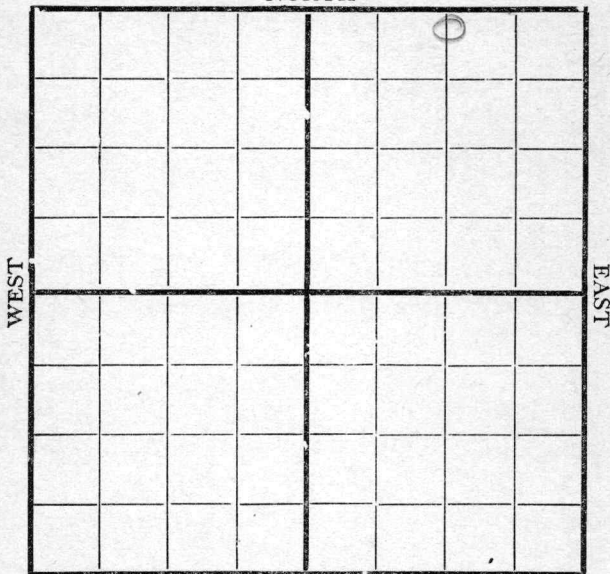

SOUTH

Location _____

Rig up _____

Drilling and Remarks:

2480

RECORD

Cased _____ in., _____ ft.

Sand _____

Gas _____

Oil _____

Total Depth _____

PRODUCTION

1st 24 hrs. Nat. _____

1st 24 hrs. after shot _____

Gas _____ Cu. Ft.

Dry Hole _____


Abandoned _____

Date

7/17 191 Scout

Map No. K14 Sec. 25 Twp. 26 R. 4Well No. 4 TraylorMagnolia Petro CompanyKeeley & McMill ContractorEl Dorado NORTH K.

WEST

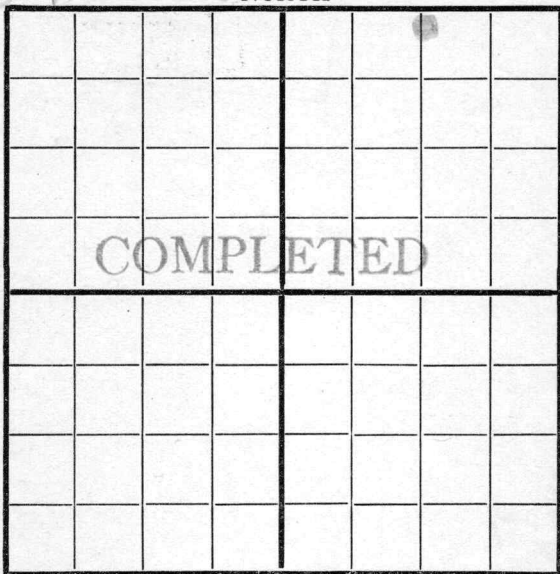

EAST

SOUTH

Location _____

Rig up _____

Drilling and Remarks:

Est at
75 Bbls

RECORD

Cased _____ in., _____ ft.

Sand 2678-2695

Gas _____

Oil _____

Total Depth _____

PRODUCTION

1st 24 hrs. Nat. _____

1st 24 hrs. after shot _____

Gas _____ Cu. Ft.

Dry Hole _____

Abandoned _____

Date

7/24 191 J. C. C. C. Scout