
FORM 51 25M 8-50 WESTERN Butler KANSAS

Section 34 Township 26 Range 6 E

Well No. # 1 Beedles (Beadles)

Company Bill Kimball et al

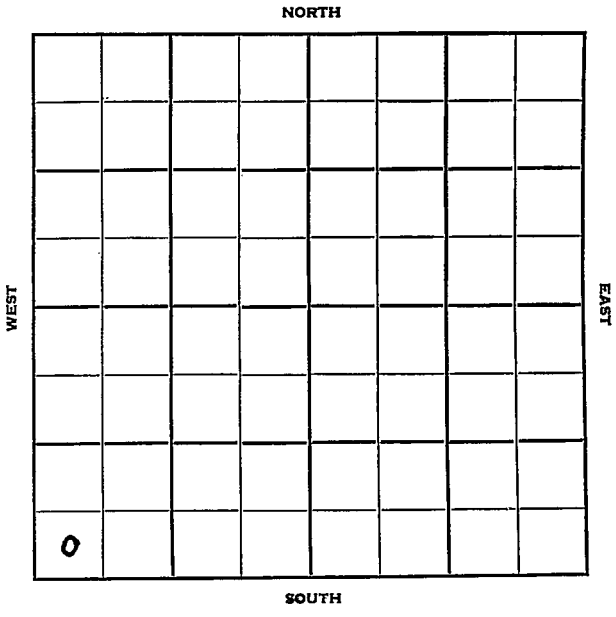

FORM 252-B
10M 8-51 TPCO.

Butler KANSAS

Sec. 34 Twp. 26 R. 6E

Well No. #1 Beedles Farm

Bill Kimball et al Company

Murfin Drlg. - Contr. Contractor


Ft. from N. Line

330' Ft. from S. Line

Ft. from E. Line

330' Ft. from W. Line

SW SW SW

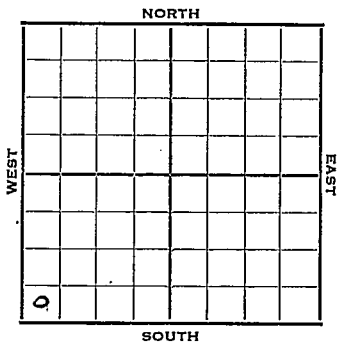

1952	Elev. 1423' REPORT
4/23	Spud 4-19-52 Drlg. 430'
5/21	Spud 4-19-52 Oil well TD 2802' 13" @ 740 10" @ 1125 8" @ 1877 Miss 2784' 5" @ 2784' TD 2802' FU 1000' oil 16 hr. S/100 BO 16 hr. Comp. 35 BOPD **COMPLETED**

FORM 275 FOR SALE BY KANSAS BLUE PRINT CO.


County Butler State Kansas

Sec. 34 (Blk. Twp.) 26 (Sur. Rge.) 6E Map No.

Operator Bill Kimball etal.

Well No. 1 Farm Beedles

Elev. Location SW SW SW

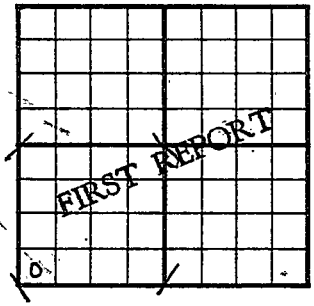

330 Ft. From S Line SW

330 Ft. From W Line Quarter

1st. Report APR 23 1952

Completion

Remarks Murfin Drlg. - Contr.

Spudding Date 4-19-52

Drlg. Data

drlg. 430

J. G. McGEHEE

FORM 275 FOR SALE BY KANSAS BLUE PRINT CO.


County Butler State Kansas

Sec. 34 (Blk. Twp.) 26 (Sur. Rge.) 6E Map No.

Operator Bill Kimball etal.

Well No. 1 Farm Beedles

Elev. 1423 Location SW SW SW

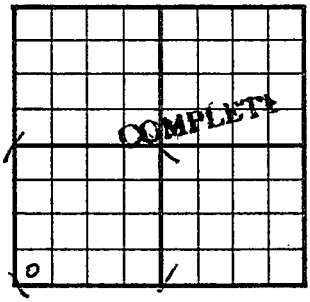

330 Ft. From S Line SW

330 Ft. From W Line Quarter

1st. Report

Completion MAY 21 1952

Remarks

Murfin Drlg. - Contr.

Spudding Date 4-19-52

Drlg. Data Oil well TD 2802

13"@ 740 10" @ 1125 8" @ 1877

Miss. 2784 5" @ 2784 TD 2802 FU 1000'

oil 16 hr. S/ 100 bo 16 hr.

Comp. 35 bopd

J. G. McGEHEE