
FORM 51 Butler

KANSAS

Section 34 Township 26 Range 6E

Well No. ~~#2~~ #3 Beadles

Company ~~Murfin et al.~~

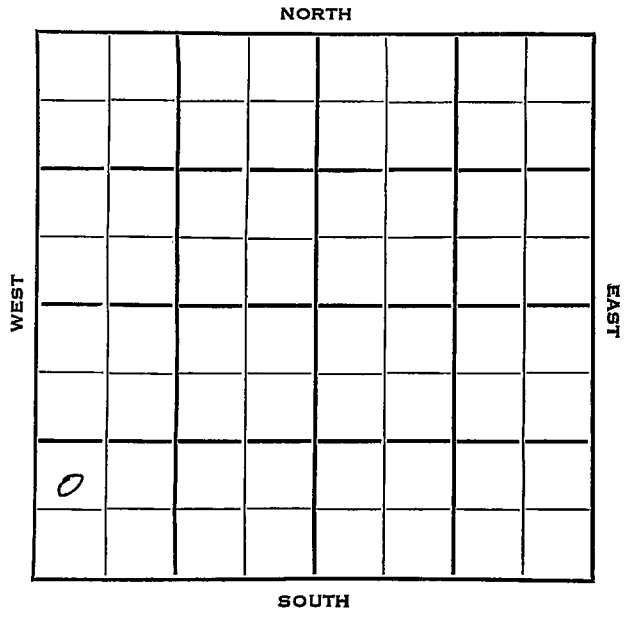

FORM 252-B Butler

KANSAS ✓

Sec. 34 Twp. 26 R. 6E

Well No. #3 #2 Beadles Farm

Murfin et al Company

Murfin - Contr. Contractor


____ Ft. from N. Line

990 Ft. from S. Line

____ Ft. from E. Line

330 Ft. from W. Line

NW SW SW

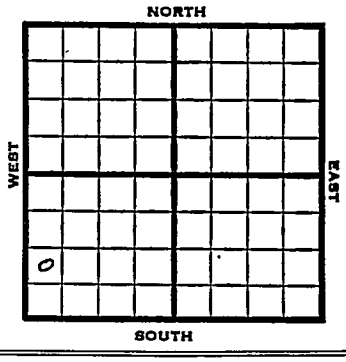

1953	Elev. 1430' REPORT
3/4	Location
5/13	Spud 4-11-53 D & A TD 2876 13" @ 360 10" @ 1075 8" @ 1882 Lans 1846 KC 2165 Miss 2810 TD 2876 D & A

ABANDONED

FORM 275 FOR SALE BY KANSAS BLUE PRINT CO.


County Butler State Kansas

Sec. 34 (Blk. Twp.) 26 (Sur. Rge.) 6E Map No.

Operator Murfin etal.

Well No. 2 Farm Beadles

Elev. Location NW SW SW

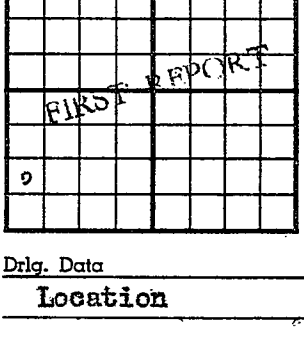

990 Ft. From S Line SW

330 Ft. From W Line Quarter

1st. Report MAR 4 1953

Completion

Remarks Murfin - Contr.

Spudding Date

Drlg. Data

Location

J. G. McGEHEE

FORM 26 200 BKS. 4-52 PETROL

Kansas

Map No. _____ Sec. 34 Twp. 26 R. 6E


Well No. 3 Beadles

Murfin etal.
Company

CORRECTION
Contractor

NW SW SW

SECTION PLAT

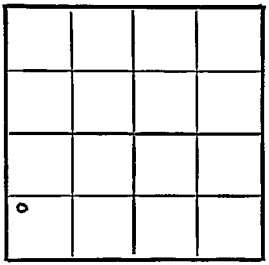

_____ Ft. from N. Line

990 Ft. from S. Line

_____ Ft. from E. Line

330 Ft. from W. Line

Butler County

Location _____

Rig up _____

Drilling and Remarks:

Reported
#2 Beadles

RECORD

Cased _____ in., _____ ft.

Sand _____

Gas _____

Oil _____

Total Depth _____

PRODUCTION

1st 24 hrs. Nat. _____

1st 24 hrs. after shot _____

Gas _____ Cu. Ft.

Dry Hole _____

Abandoned _____

Date

MAR 25 1953

J. G. McGEHEE
Scout

FORM 275 FOR SALE BY KANSAS BLUE PRINT CO.


County Butler State Kansas

Sec. 34 (Blk. Twp.) 26 (Sur. Rge.) 6E Map No.

Operator Murfin etal.

Well No. 3 Farm Beadles

Elev. 1430 Location NW SW SW

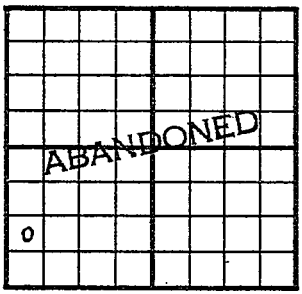

990 Ft. From S Line SW

330 Ft. From W Line Quarter

1st. Report

Completion MAY 1 3 1953

Remarks

Murfin Drlg. - Contr.

Spudding Date 4-11-53

Drlg. Data D & A TD 2876

13" @ 360 10" @ 1075 8" @ 1882

Lans. 1846 KC 2165 Miss. 2810 TD 2876

D & A

J. G. McGEHEE