Butler


FORM 5I 5M PETROL

KANSAS

Section 34 Township 26 Range 6E

Well No. 1 Criner

Company S & L Drlg.

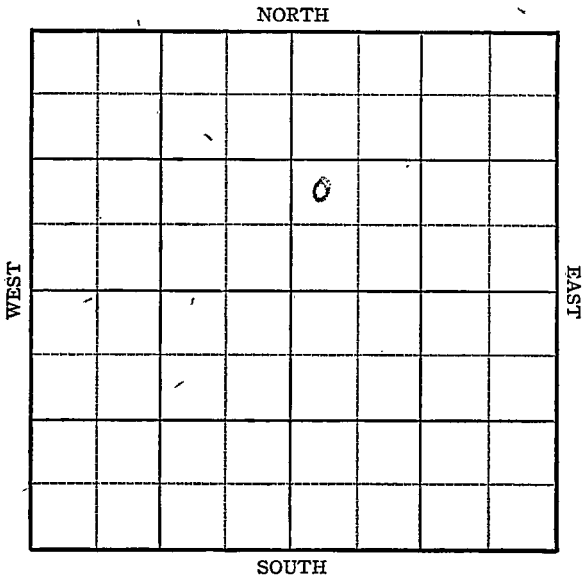

FORM 252-A
5M 3-45 PETROL

KANSAS Butler

Sec. 34 Twp. 26 R. 6E

Well No. 1 Criner Farm

S & L Drlg. Company

Miscellaneous


_____ Ft. from N. Line

990 Ft. from S. Line

_____ Ft. from E. Line

330 Ft. from W. Line

NW SW NE Elev. 1430

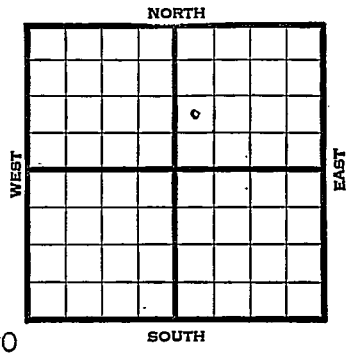

1945	REPORT
6/20	Machine
6/28	Surface hole
7/3	15" @ 68
	Drlg. 445
7/11	12" @ 800
	Drlg. 825
7/19	Drlg. 1325
7/26	10" @ 1600
	Drlg. 1876'
8/1	Drlg. 2175
8/8	Drlg. 2420
	8" @ 2277
8/15	Drlg. 2660
	6" @ 2630
8/22	Miss. 2830
	Drlg. 2950
8/29	5" @ 2985 CO
9/5	Drlg. 3045
9/12	Kind 3152
	Drlg. 3190'
9/19	Viola 3220
	TD 3222' HFW

ABANDONED

FORM 56 200 BKS. 1-44 PETROL

Kansas Pool Name Miscellaneous

Map No. 14 Sec. 34 Twp. 26 R. 6E


Well No. 1 Criner

S & L Drlg. Company

FIRST REPORT Contractor

NW SW NE

SECTION PLAT

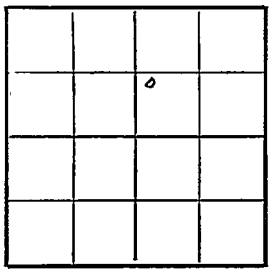

____ Ft. from N. Line

990 Ft. from S. Line

____ Ft. from E. Line

330 Ft. from W. Line

Butler County.

Location

Rig up

Drilling and Remarks:

machine

RECORD

Cased ____ in., ____ ft.

Sand

Gas

Oil

Total Depth

PRODUCTION

1st 24 hrs. Nat.

1st 24 hrs. after shot

Gas ____ Cu. Ft.

Dry Hole

Abandoned

Date

JUN 20 1945 19 S. J. LEWIS Scout

FORM 26 200 BKS. 1 44 PETROL

Kansas Pool Name Miscellaneous

KANSAS

Map No. 14 Sec. 34 Twp. 26 R. 6E

Well No. 1 Criner


S. & L. Drlg. Company

ABANDONED Contractor

NW SW NE

E.L. 1430

SECTION PLAT

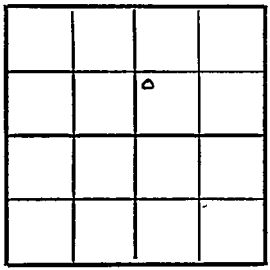

Ft. from N. Line

990 Ft. from S. Line

Ft. from E. Line

330 Ft. from W. Line

Butler County

Location

Rig up

Drilling and Remarks:

Viola 3220

HFW

RECORD

Cased in., ft.

Sand

Gas

Oil

Total Depth 3222

PRODUCTION

1st 24 hrs. Nat.

1st 24 hrs. after shot

Gas Cu. Ft.

Dry Hole

Abandoned

Date

SEP 1 9 1945 19 S. J. LEWIS Scout