

Map No. _____ Sec. 25 Twp. 26 R. 4


Well No. 5 Bozler Farm

Magnolia Petroleum Co. Company

NORTH

WEST

EAST

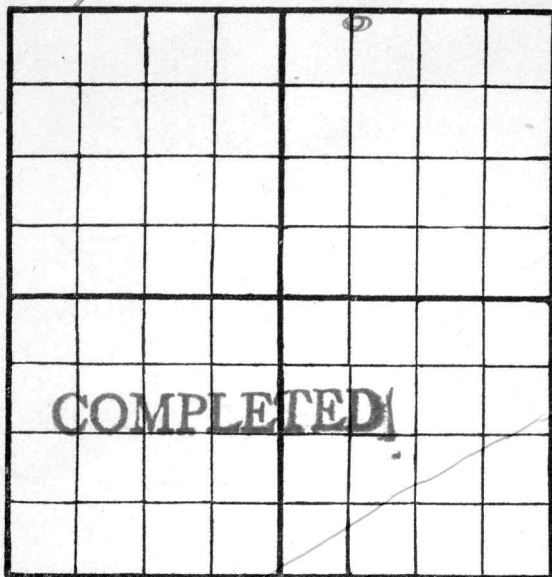

SOUTH

Location _____

Rig Up _____

Drilling Remarks:

Drilling Remarks:

RECORD

PRODUCTION

Cased _____ in. _____ ft.

1st 24 hrs. Nat. _____

Sand _____

1st 24 hrs. after shot _____

Gas _____

Gas _____ cu. ft.

Oil _____

Dry Hole _____

Total Depth _____

Abandoned _____


Map No. K14 Sec. 25 Twp. 26 R. 4

Well No. 5700000 Farm Magnolia Petroleum Company

NORTH

WEST

EAST

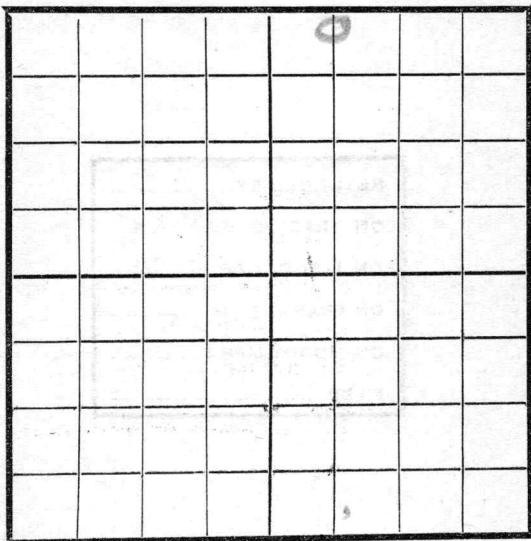

SOUTH

Location

Rig Up

Drilling and remarks

RECORD

Cased in Ft.

Sand

Gas

Oil

Total Depth

PRODUCTION

1st 24 hrs. Nat.

1st 24 hrs. after shot

Gas Cu. Ft.

Dry Hole

Abandoned

FIRST REPORT

Date


5/22, 1918 Candoy Scout

Map No. _____ Sec. 25 Twp. 26 R. 4Well No. 5 Karglen

_____ Company

B. B. Salvatella ContractorE. P. Dando NORTH 760

WEST

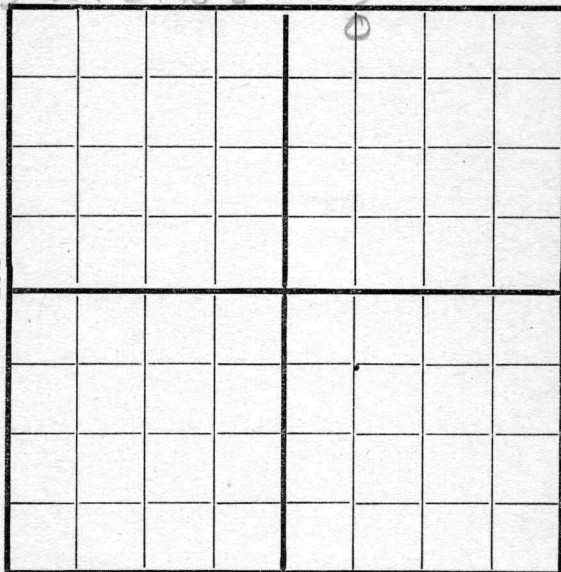

EAST

SOUTH

Location _____

Rig up _____

Drilling and Remarks:

Rigging up**RECORD**

Cased _____ in., _____ ft.

Sand _____

Gas _____

Oil _____

Total Depth _____

PRODUCTION

1st 24 hrs. Nat. _____

1st 24 hrs. after shot _____

Gas _____ Cu. Ft.

Dry Hole _____

Abandoned _____

Date


6/10 191 S. Condry Scout

Map No. _____ Sec. 25 Twp. 26 R. 4Well No. 5 Kogler

_____ Company

_____ Contractor

NORTH

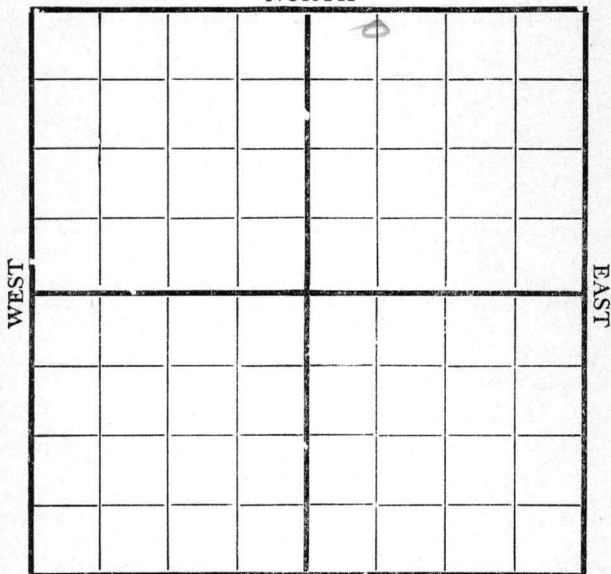

SOUTH

Location _____

Rig up _____

Drilling and Remarks:

Rigged up

RECORD

Cased _____ in., _____ ft.

Sand _____

Gas _____

Oil _____

Total Depth _____

PRODUCTION

1st 24 hrs. Nat. _____

1st 24 hrs. after shot _____

Gas _____ Cu. Ft.

Dry Hole _____

Abandoned _____

Date


6/19 191 8 Cardiff Scout

Map No. _____ Sec. 25 Twp. 36 R. 4Well No. 5 KroylerMagnolia Petro Company_____
Contractor

NORTH

WEST

EAST

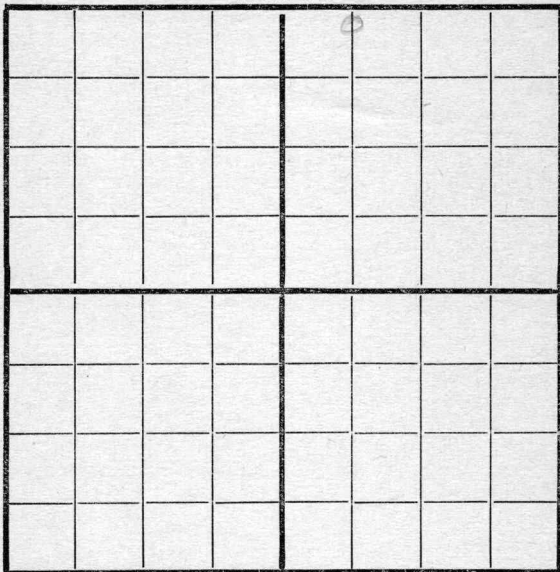

SOUTH

Location _____

Rig up _____

Drilling and Remarks:

525

RECORD

Cased _____ in., _____ ft.

Sand _____

Gas _____

Oil _____

Total Depth _____

PRODUCTION

1st 24 hrs. Nat. _____

1st 24 hrs. after shot _____

Gas _____ Cu. Ft.

Dry Hole _____

Abandoned _____

Date

6/26/1918 Candiff Scout


Map No. _____ Sec. 25 Twp. 26 R. 4Well No. 5 KoglerMagnolia Company

Contractor _____

NORTH

WEST

EAST

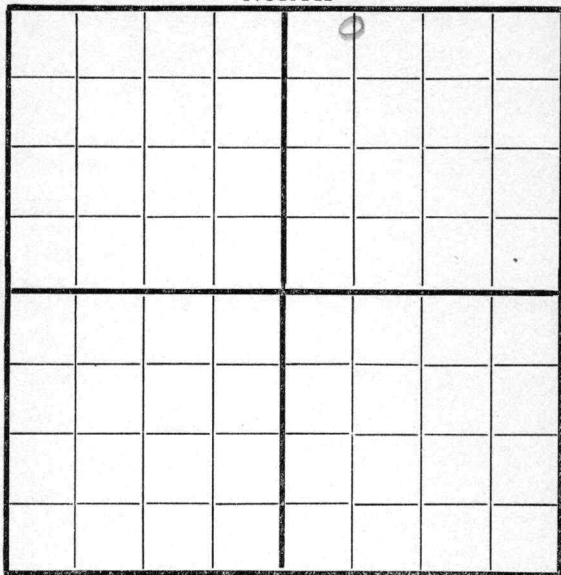

SOUTH

Location _____

Rig up _____

Drilling and Remarks:

1315

RECORD

Cased _____ in., _____ ft.

Sand _____

Gas _____

Oil _____

Total Depth _____

PRODUCTION

1st 24 hrs. Nat. _____

1st 24 hrs. after shot _____

Gas _____ Cu. Ft.

Dry Hole _____

Abandoned _____

Date

7/3 191 E. Caudry Scout

Map No. _____ Sec. 25 Twp. 26 R. 4Well No. 5 KangleenMay Petco Company_____
Contractor

NORTH

WEST

EAST

SOUTH

Location _____

Rig up _____

Drilling and Remarks:

1700

RECORD

Cased _____ in., _____ ft.

Sand _____

Gas _____

Oil _____

Total Depth _____

PRODUCTION

1st 24 hrs. Nat. _____

1st 24 hrs. after shot _____

Gas _____ Cu. Ft.

Dry Hole _____


Abandoned _____

Date

1/10 191 8 Sunday Scout

Map No. _____ Sec. 25 Twp. 26 R. 4Well No. 5 KangerMagnum Company_____
Contractor

NORTH

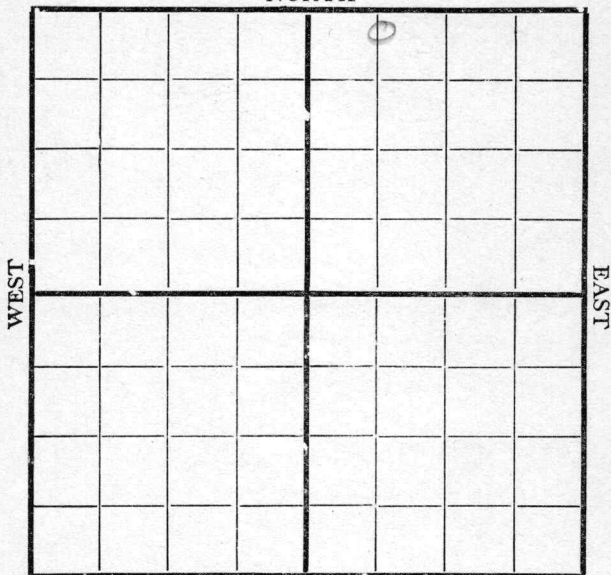

SOUTH

Location _____

Rig up _____

Drilling and Remarks:

2000**RECORD**

Cased _____ in., _____ ft.

Sand _____

Gas _____

Oil _____

Total Depth _____

PRODUCTION

1st 24 hrs. Nat. _____

1st 24 hrs. after shot _____

Gas _____ Cu. Ft.


Dry Hole _____

Abandoned _____

Date

7/12 f. Conding 191 Scout

Map No. _____ Sec. 25 Twp. 26 R. 4
Well No. 5 _____ Company _____
Contractor _____

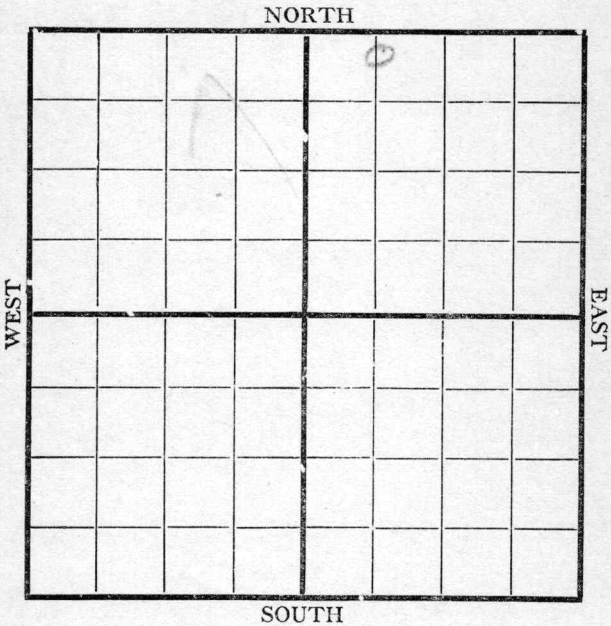

Location _____ Rig up _____ Drilling and Remarks: <u>3100</u>	RECORD
	Cased _____ in., _____ ft. Sand _____ Gas _____ Oil _____ Total Depth _____
	PRODUCTION
	1st 24 hrs. Nat. _____ 1st 24 hrs. after shot _____ Gas _____ Cu. Ft. Dry Hole _____ Abandoned _____

Date 7/24 1918 Scout


Map No. _____ Sec. 25 Twp. 26 R. 4Well No. 5 KoglerMagnolia Petroleum Company

Contractor _____

NORTH

WEST

EAST

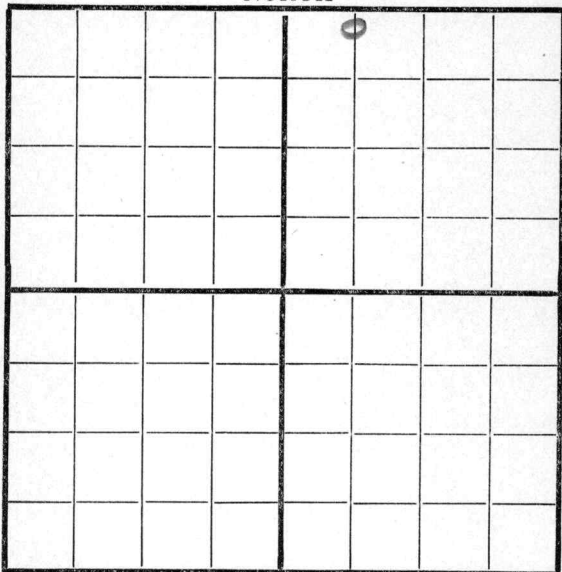

SOUTH

200' ~~54~~ x 660' ~~54~~ 1/2 Line

Location _____

Rig up _____

Drilling and Remarks:

2100

RECORD

Cased _____ in., _____ ft.

Sand _____

Gas _____

Oil _____

Total Depth _____

PRODUCTION

1st 24 hrs. Nat. _____

1st 24 hrs. after shot _____

Gas _____ Cu. Ft.

Dry Hole _____

Abandoned _____

Date

7/31

191

S. Carney

Scout


Map No. _____ Sec. 25 Twp. 26 R. 4Well No. 5 KoglerMagnolia Petroleum Company

Contractor _____

NORTH

WEST

EAST

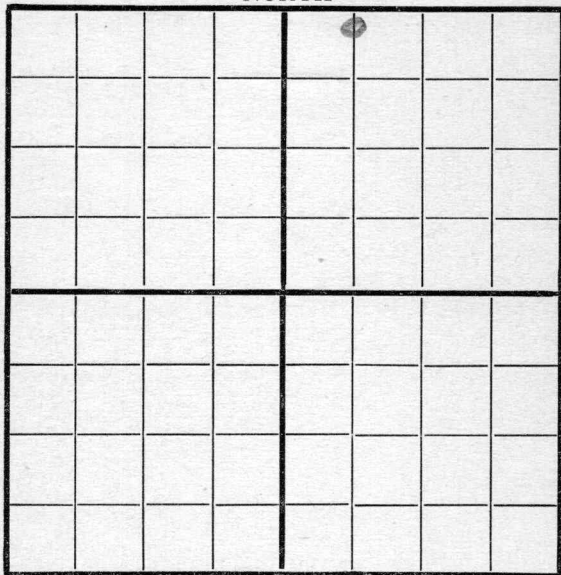

SOUTH

Location 200 N
660 W

Rig up _____

Drilling and Remarks:

2 2 20

RECORD

Cased _____ in., _____ ft.

Sand _____

Gas _____

Oil _____

Total Depth _____

PRODUCTION

1st 24 hrs. Nat. _____

1st 24 hrs. after shot _____

Gas _____ Cu. Ft.

Dry Hole _____


Abandoned _____

Date

8/7191Plenty

Scout

Map No. _____ Sec. 25 Twp. 26 R. 4
Well No. 5 Karples
Mingus Bros. Pet. Company
Contractor _____

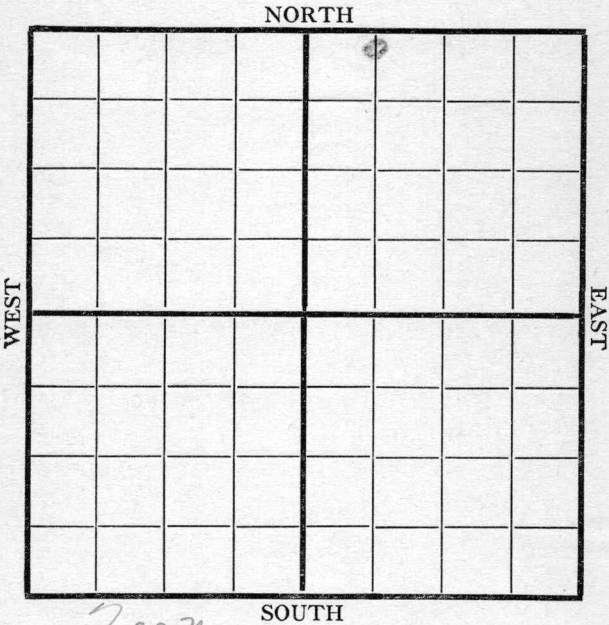

200N
660W
Location _____
Rig up _____
Drilling and Remarks:

2280'

RECORD

Cased _____ in., _____ ft.
Sand _____
Gas _____
Oil _____
Total Depth _____


PRODUCTION

1st 24 hrs. Nat. _____
1st 24 hrs. after shot _____
Gas _____ Cu. Ft.
Dry Hole _____
Abandoned _____

Date 8-15 1918 Cyle Scout

Map No. _____ Sec. 25 Twp. 26 R. 4
Well No. 5 Thompson
Magnolia Petroleum Company

Contractor _____

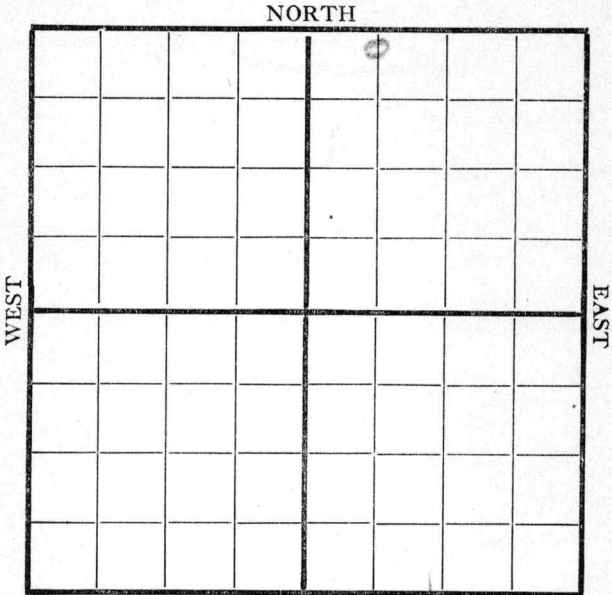

200 N - 660 W

Location _____
Rig up _____
Drilling and Remarks:

D. O. @
2280'

RECORD

Cased _____ in., _____ ft.
Sand _____
Gas _____
Oil _____
Total Depth _____

PRODUCTION

1st 24 hrs. Nat. _____
1st 24 hrs. after shot _____
Gas _____ Cu. Ft.
Dry Hole _____
Abandoned _____

Date 8/23 1918 **Pyle** Scout

Map No. 1514 Sec. 25 Twp. 26 R. 4

Well No. 5500


Company McFarland

Contractor W. J. McFarland

NORTH

WEST

EAST

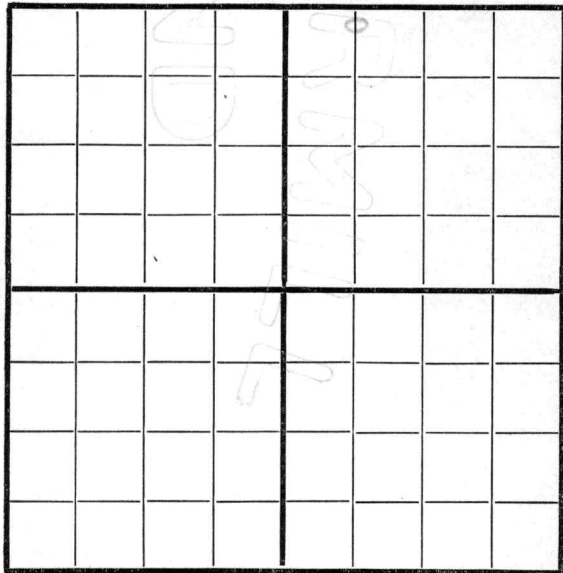

SOUTH

200 x 660 W

Location _____

Rig up _____

Drilling and Remarks:

2540

RECORD

Cased _____ in., _____ ft.

Sand _____

Gas _____

Oil _____

Total Depth _____

PRODUCTION

1st 24 hrs. Nat. _____

1st 24 hrs. after shot _____

Gas _____ Cu. Ft.

Dry Hole _____


Abandoned _____

Date

7/28/8 Candy

Map No. 1514 Sec. 25 Twp. 26 R. 4Well No. 5150Company WingfieldContractor B. S. SawtelleE. I. Dorado NORTH

WEST

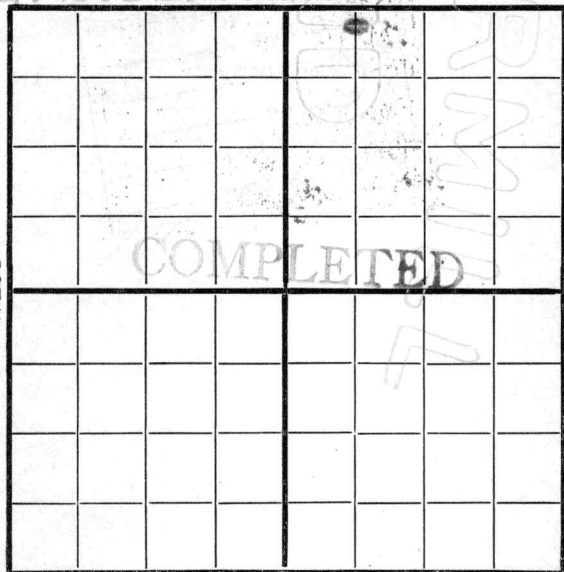

EAST

SOUTH

Location _____

Rig up _____

Drilling and Remarks:

Est at
100 Bbe

RECORD

Cased _____ in., _____ ft.

Sand 2670-2681

Gas _____

Oil _____

Total Depth _____

PRODUCTION

1st 24 hrs. Nat. _____

1st 24 hrs. after shot _____

Gas _____ Cu. Ft.

Dry Hole _____

Abandoned _____

Date

9/5 191 8 Cordiff Scout