
FORM 51 Butler KANSAS

Section 35 Township 26 Range 6E

Well No. 1 Roger

Company Murfin Drlg.

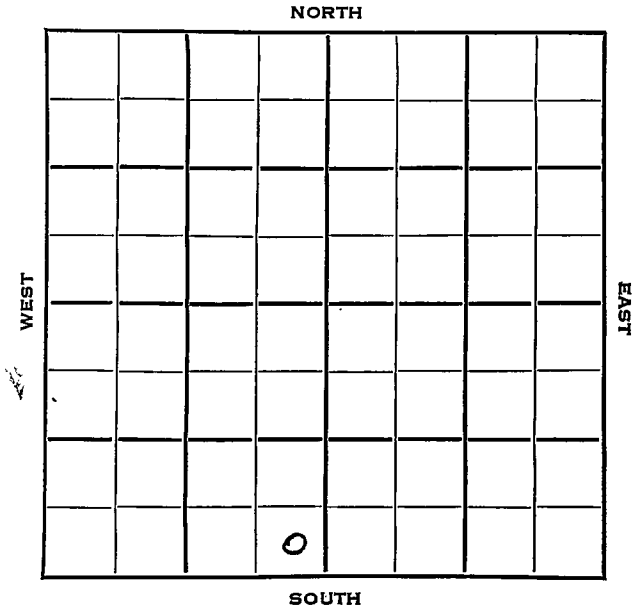

Butler KANSAS

SEC.	TWP.	R.
35	26	6 E

WELL NO.

1 Roger FARM

COMPANY

Murfin Drlg.

CONTRACTOR

Leon Pool


_____ Ft. from N. Line

330 Ft. from S. Line

330 Ft. from E. Line

_____ Ft. from W. Line

SE SE SW

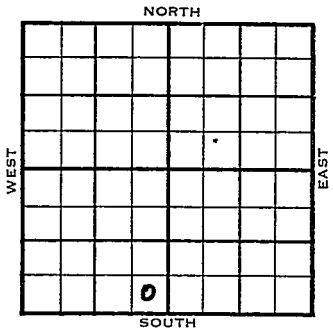

1953	ELEVATION 1415'	REPORT
9/16	Spud 9-10-53 Drlg. 660'	
10/21	Spud 9-10-53 D & A TD 3266' 13" @ 690' 10" @ 1598' KC 2116', 8"@ 2365' Miss 2757 7" @ 2795' Viola 3192' Simp 3200' TD 3266' D & A	

ABANDONED

DX-78

FORM 275 FOR SALE BY KANSAS BLUE PRINT CO.


County Butler State Kansas

Sec. 35 (Blk. Twp.) 26 (Sur. Rge.) 6E Map No.

Operator Murfin Drlg.

Well No. 1 Farm Roger

Elev. 1415 Location SE SE SW

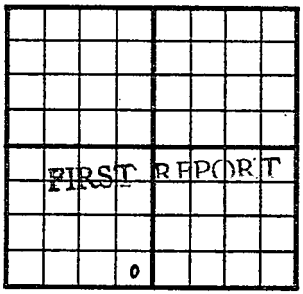

330 Ft. From S Line SW

330 Ft. From E Line Quarter

1st. Report SEP 16 1953

Completion

Remarks

Spudding Date 9-10-53

Drlg. Data Leon Pool

drlg. 660

J. G. McGEHEE

FORM 275 FOR SALE BY KANSAS BLUE PRINT CO.


County Butler State Kansas

Sec. 35 (Blk. Twp.) 26 (Sur. Rge.) 6E Map No.

Operator Murfin Drlg.

Well No. 1 Farm Roger

Elev. 1415 Location SE SE SW

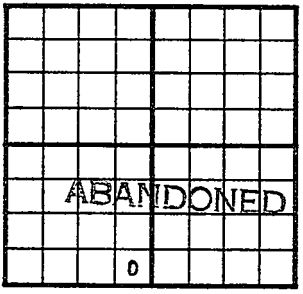

330 Ft. From S Line SW

330 Ft. From E Line Quarter

1st. Report

Completion OCT 21 1953

Remarks Leon Pool

Spudding Date 9-10-53

Drlg. Data D & A TD 3266

13" @ 690 10" @ 1598 KC 2116

8" @ 2365 Miss. 2757 7" @ 2795

Viola 3192 Simp. 3200 TD 3266

D & A

J. G. McGEHEE