


Map No. \_\_\_\_\_ Sec. 25, Twp. 26, R. 4Well No. 2 Phillips Farm \_\_\_\_\_Carter Company \_\_\_\_\_

NORTH

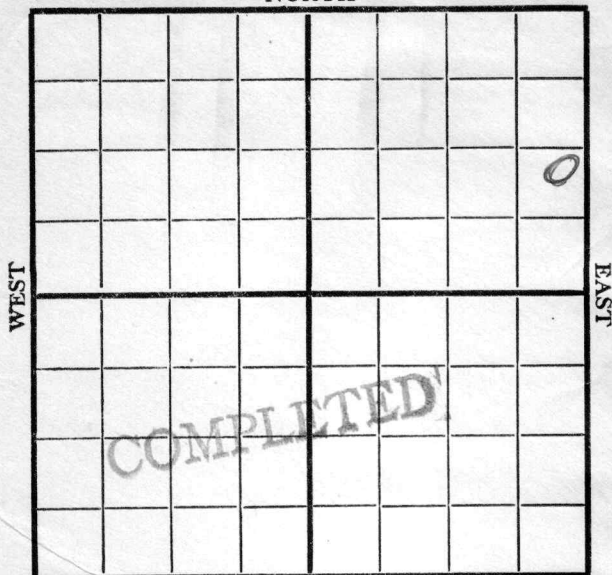

SOUTH

Location \_\_\_\_\_

Rig up \_\_\_\_\_

Drilling Remarks:

Drilling Remarks:

## RECORD

Cased \_\_\_\_\_ in. \_\_\_\_\_ ft.

Sand \_\_\_\_\_

Gas \_\_\_\_\_

Oil \_\_\_\_\_

Total Depth \_\_\_\_\_

## PRODUCTION

1st 24 hrs. Nat. \_\_\_\_\_

1st 24 hrs. after shot \_\_\_\_\_

Gas \_\_\_\_\_ Cu. Ft.

Dry Hole \_\_\_\_\_


Abandoned \_\_\_\_\_

Map No. \_\_\_\_\_ Sec. 25 Twp. 26 R. 4

Well No. 2 P Phillips Farm \_\_\_\_\_

\_\_\_\_\_ Company

NORTH

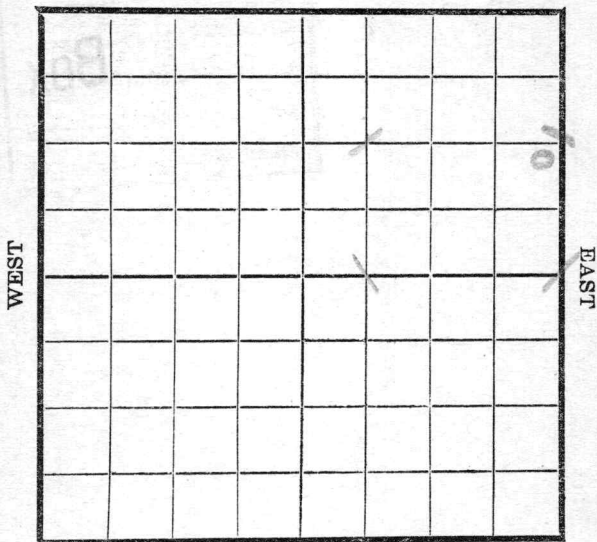

SOUTH

Location \_\_\_\_\_

Rig Up \_\_\_\_\_

Drilling and remarks

**RECORD**

Cased \_\_\_\_\_ in \_\_\_\_\_ Ft.

Sand \_\_\_\_\_

Gas \_\_\_\_\_

Oil \_\_\_\_\_

Total Depth \_\_\_\_\_

**PRODUCTION**

1st 24 hrs. Nat. \_\_\_\_\_

1st 24 hrs. after shot \_\_\_\_\_

Gas \_\_\_\_\_ Cu. Ft.

Dry Hole \_\_\_\_\_

Abandoned \_\_\_\_\_

*First Report*

Date

1/23, 1918 S. Cardiff Scout


Map No. \_\_\_\_\_ Sec. 25 Twp. 26 R. 4

Well No. 2 Phillips Farm \_\_\_\_\_

Carroll Company \_\_\_\_\_

NORTH

WEST

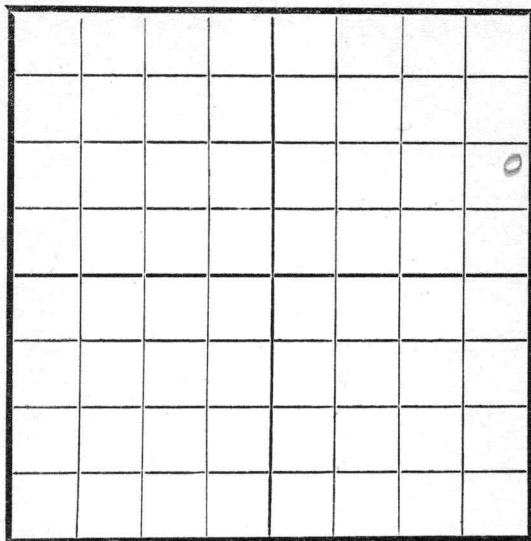

EAST

SOUTH

Location \_\_\_\_\_

Rig Up \_\_\_\_\_

Drilling and remarks \_\_\_\_\_

### RECORD

Cased \_\_\_\_\_ in. \_\_\_\_\_ Ft.

Sand \_\_\_\_\_

Gas \_\_\_\_\_

Oil \_\_\_\_\_

Total Depth \_\_\_\_\_

### PRODUCTION

1st 24 hrs. Nat. \_\_\_\_\_

1st 24 hrs. after shot \_\_\_\_\_

Gas \_\_\_\_\_ Cu. Ft.

Dry Hole \_\_\_\_\_

Abandoned \_\_\_\_\_


Date

2/20, 1911 Scout

Map No. \_\_\_\_\_ Sec. 25 Twp. 26 R. 4Well No. 2 Phillips FarmPorter Company

NORTH

WEST

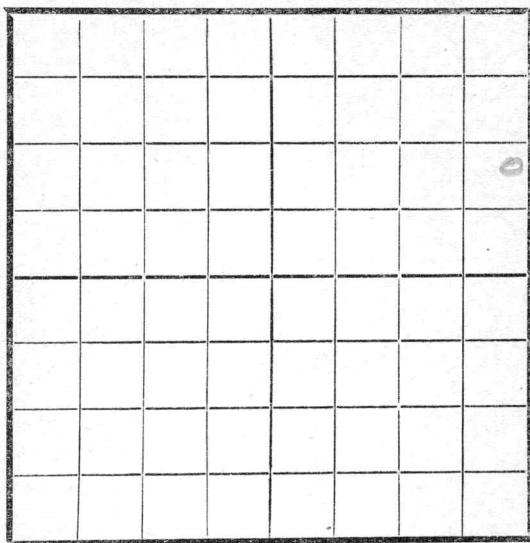

EAST

SOUTH

Location \_\_\_\_\_

Rig Up \_\_\_\_\_

Drilling and remarks

## RECORD

Cased \_\_\_\_\_ in. \_\_\_\_\_ Ft.

Sand \_\_\_\_\_

Gas \_\_\_\_\_

Oil \_\_\_\_\_

Total Depth \_\_\_\_\_

## PRODUCTION

1st 24 hrs. Nat. \_\_\_\_\_

1st 24 hrs. after shot \_\_\_\_\_

Gas \_\_\_\_\_ Cu. Ft.

Dry Hole \_\_\_\_\_

Abandoned \_\_\_\_\_

Date


5/13, 1918 I. C. Cady Scout

Map No. \_\_\_\_\_ Sec. 95 Twp. 26 R. 4Well No. 3 Phillips Farm \_\_\_\_\_

\_\_\_\_\_ Company

NORTH

WEST

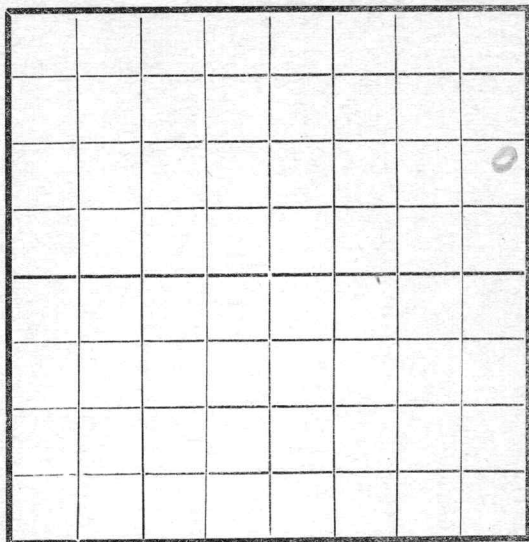

EAST

SOUTH

Location \_\_\_\_\_

Rig Up \_\_\_\_\_

Drilling and remarks

1000

## RECORD

Cased \_\_\_\_\_ in. \_\_\_\_\_ Ft.

Sand \_\_\_\_\_

Gas \_\_\_\_\_

Oil \_\_\_\_\_

Total Depth \_\_\_\_\_

## PRODUCTION

1st 24 hrs. Nat. \_\_\_\_\_

1st 24 hrs. after shot \_\_\_\_\_

Gas \_\_\_\_\_ Cu. Ft.

Dry Hole \_\_\_\_\_

Abandoned \_\_\_\_\_


Date

3/20, 1918 S. C. Cady Scout

Map No. \_\_\_\_\_ Sec. 25 Twp. 26 R. 4  
 Well No. 2 Phillips Farm \_\_\_\_\_  
Carter Company

NORTH

WEST

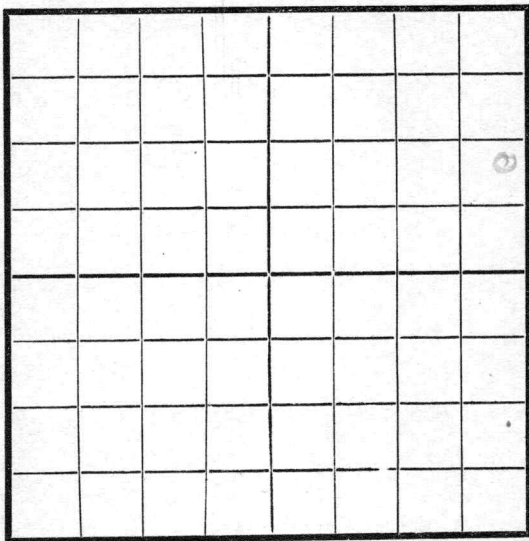

EAST

SOUTH

Location \_\_\_\_\_

Rig Up \_\_\_\_\_

Drilling and remarks

### RECORD

Cased \_\_\_\_\_ in. \_\_\_\_\_ Ft.

Sand \_\_\_\_\_

Gas \_\_\_\_\_

Oil \_\_\_\_\_

Total Depth \_\_\_\_\_

### PRODUCTION

1st 24 hrs. Nat. \_\_\_\_\_

1st 24 hrs. after shot \_\_\_\_\_

Gas \_\_\_\_\_ Cu. Ft.

Dry Hole \_\_\_\_\_

Abandoned \_\_\_\_\_


Date

3/27, 1911 S. C. Carter Scout

Map No. \_\_\_\_\_ Sec. 25 Twp. 26 R. 4  
Well No. 3 Phillips Farm \_\_\_\_\_  
Carter Company \_\_\_\_\_

NORTH

WEST

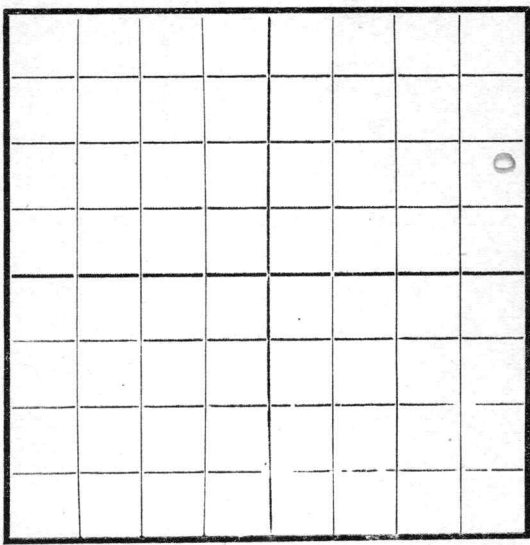

EAST

SOUTH

Location \_\_\_\_\_  
Rig Up \_\_\_\_\_  
Drilling and remarks  
1370

**RECORD**  
Cased \_\_\_\_\_ in. \_\_\_\_\_ Ft.  
Sand \_\_\_\_\_  
Gas \_\_\_\_\_  
Oil \_\_\_\_\_  
Total Depth \_\_\_\_\_


**PRODUCTION**  
1st 24 hrs. Nat. \_\_\_\_\_  
1st 24 hrs. after shot \_\_\_\_\_  
Gas \_\_\_\_\_ Cu. Ft.  
Dry Hole \_\_\_\_\_  
Abandoned \_\_\_\_\_

Date  
APR 3 1918  
\_\_\_\_\_, 191\_\_\_\_ Scout Carter

Map No. \_\_\_\_\_ Sec. 25 Twp. 36 R. 4Well No. 2 Phillips Farm \_\_\_\_\_  
Carter Company

NORTH

WEST

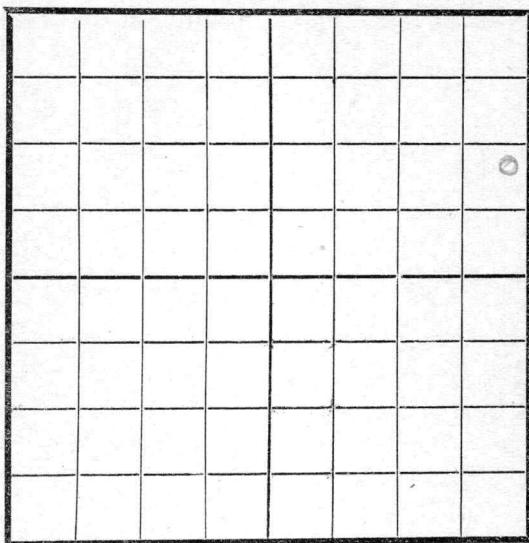

EAST

SOUTH

Location \_\_\_\_\_

Rig Up \_\_\_\_\_

Drilling and remarks

2220

## RECORD

Cased \_\_\_\_\_ in. \_\_\_\_\_ Ft.

Sand \_\_\_\_\_

Gas \_\_\_\_\_

Oil \_\_\_\_\_

Total Depth \_\_\_\_\_

## PRODUCTION

1st 24 hrs. Nat. \_\_\_\_\_

1st 24 hrs. after shot \_\_\_\_\_

Gas \_\_\_\_\_ Cu. Ft.

Dry Hole \_\_\_\_\_

Abandoned \_\_\_\_\_

Date


4/10, 1911 S. C. Carter Scout



Map No. \_\_\_\_\_ Sec. 25 Twp. 26 R. 4Well No. 2 Phillips Farm \_\_\_\_\_\_\_\_\_\_Center\_\_\_\_\_  
Company

NORTH

WEST

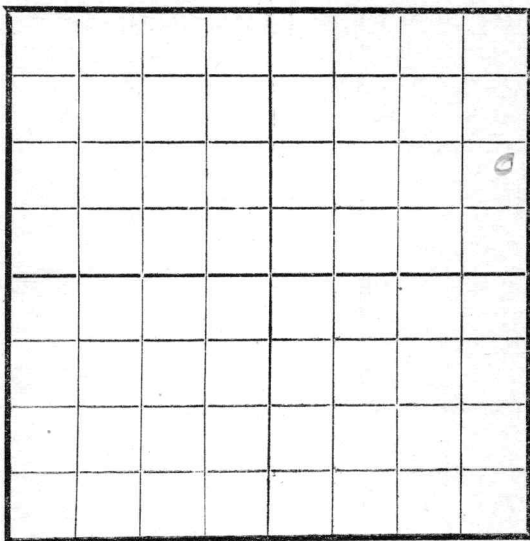

EAST

SOUTH

Location \_\_\_\_\_

Rig Up \_\_\_\_\_

Drilling and remarks

223300

## RECORD

Cased \_\_\_\_\_ in \_\_\_\_\_ Ft

Sand \_\_\_\_\_

Gas \_\_\_\_\_

Oil \_\_\_\_\_

Total Depth \_\_\_\_\_

## PRODUCTION

1st 24 hrs. Nat. \_\_\_\_\_

1st 24 hrs. after shot \_\_\_\_\_

Gas \_\_\_\_\_ Cu. Ft.

Dry Hole \_\_\_\_\_

Abandoned \_\_\_\_\_


Date

4/17, 1918 \_\_\_\_\_ Scout

Map No. \_\_\_\_\_ Sec. 25 Twp. 26 R. ✓Well No. 2 Phillips FarmCarter Company

NORTH

WEST

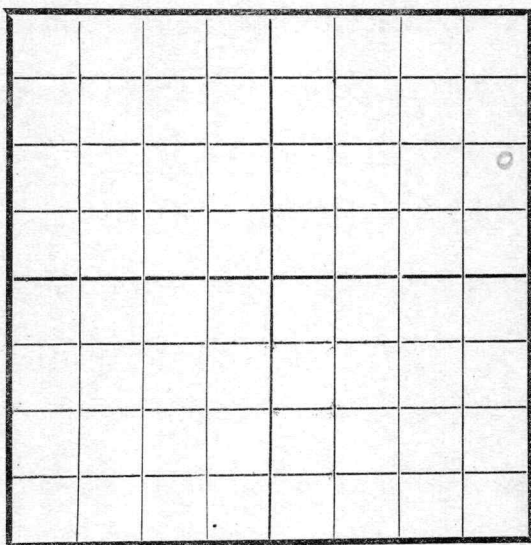

EAST

SOUTH

Location \_\_\_\_\_

Rig Up \_\_\_\_\_

Drilling and remarks

22 22 20

## RECORD

Cased \_\_\_\_\_ in. \_\_\_\_\_ Ft.

Sand \_\_\_\_\_

Gas \_\_\_\_\_

Oil \_\_\_\_\_

Total Depth \_\_\_\_\_

## PRODUCTION

1st 24 hrs. Nat. \_\_\_\_\_

1st 24 hrs. after shot \_\_\_\_\_

Gas \_\_\_\_\_ Cu. Ft.

Dry Hole \_\_\_\_\_

Abandoned \_\_\_\_\_


Date

4/24, 1918 S. Conroy Scout

Map No. \_\_\_\_\_ Sec. 25 Twp. 56 R. 4  
 Well No. 2 Phillips Farm \_\_\_\_\_  
 \_\_\_\_\_ Company

NORTH

WEST

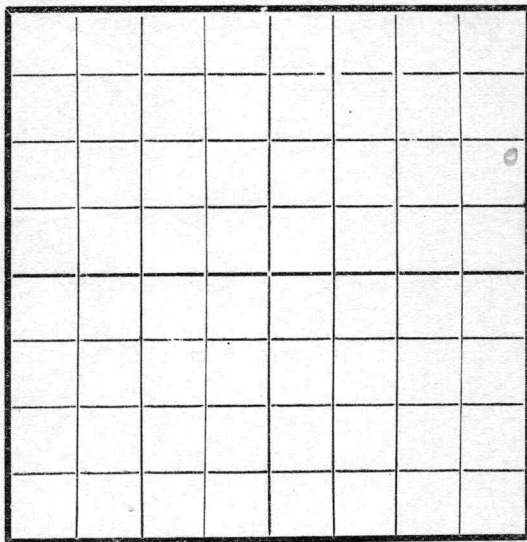

EAST

SOUTH

Location \_\_\_\_\_  
 Rig Up \_\_\_\_\_  
 Drilling and remarks

**RECORD**

Cased \_\_\_\_\_ in. \_\_\_\_\_ Ft.  
 Sand \_\_\_\_\_  
 Gas \_\_\_\_\_  
 Oil \_\_\_\_\_  
 Total Depth \_\_\_\_\_

**PRODUCTION**

1st 24 hrs. Nat. \_\_\_\_\_  
 1st 24 hrs. after shot \_\_\_\_\_  
 Gas \_\_\_\_\_ Cu. Ft.  
 Dry Hole \_\_\_\_\_  
 Abandoned \_\_\_\_\_


Date

57, 191 8 Scout

Map No. \_\_\_\_\_ Sec. 25 Twp. 36 R. 4  
Well No. 3 Phillips Farm \_\_\_\_\_  
Carter Company \_\_\_\_\_

NORTH

WEST

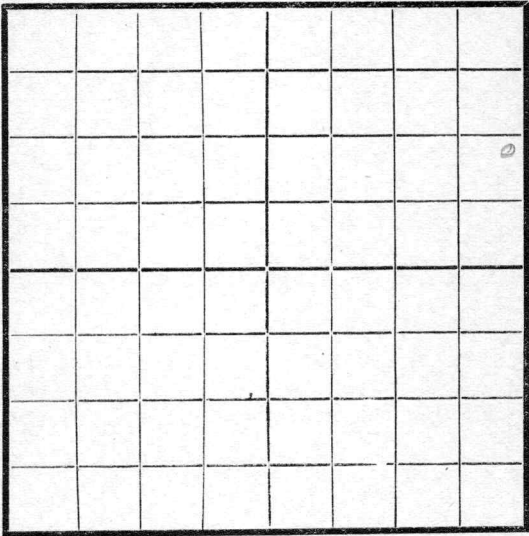

EAST

SOUTH

Location \_\_\_\_\_  
Rig Up \_\_\_\_\_  
Drilling and remarks

22222

RECORD

Cased \_\_\_\_\_ in. \_\_\_\_\_ Ft.  
Sand \_\_\_\_\_  
Gas \_\_\_\_\_  
Oil \_\_\_\_\_  
Total Depth \_\_\_\_\_

PRODUCTION

1st 24 hrs. Nat. \_\_\_\_\_  
1st 24 hrs. after shot \_\_\_\_\_  
Gas \_\_\_\_\_ Cu. Ft.  
Dry Hole \_\_\_\_\_  
Abandoned \_\_\_\_\_


Date

578, 1918 C. Carter Scout

Map No. \_\_\_\_\_ Sec. 25 Twp. 26 R. 4Well No. 2 Phillips Farm \_\_\_\_\_\_\_\_\_\_Carter Company

NORTH

WEST

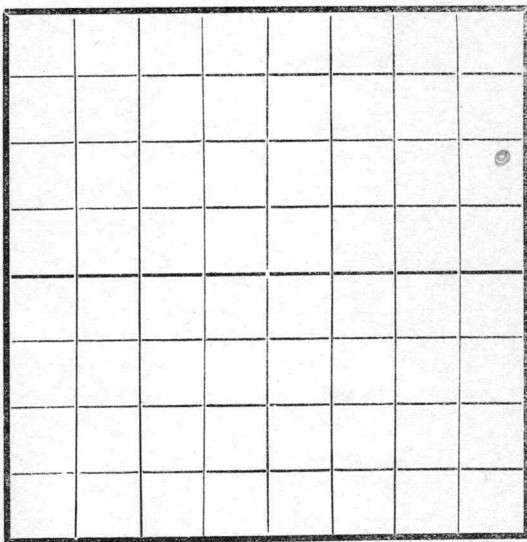

EAST

SOUTH

Location \_\_\_\_\_

Rig Up \_\_\_\_\_

Drilling and remarks

22 2220

## RECORD

Cased \_\_\_\_\_ in. \_\_\_\_\_ Ft.

Sand \_\_\_\_\_

Gas \_\_\_\_\_

Oil \_\_\_\_\_

Total Depth \_\_\_\_\_

## PRODUCTION

1st 24 hrs. Nat. \_\_\_\_\_

1st 24 hrs. after shot \_\_\_\_\_

Gas \_\_\_\_\_ Cu. Ft.

Dry Hole \_\_\_\_\_


Abandoned \_\_\_\_\_

Date

5/15, 1918 Carter Scout

Map No. \_\_\_\_\_ Sec. 25 Twp. 26 R. 4  
 Well No. 2 Phillips Farm \_\_\_\_\_  
Carter Company \_\_\_\_\_

NORTH

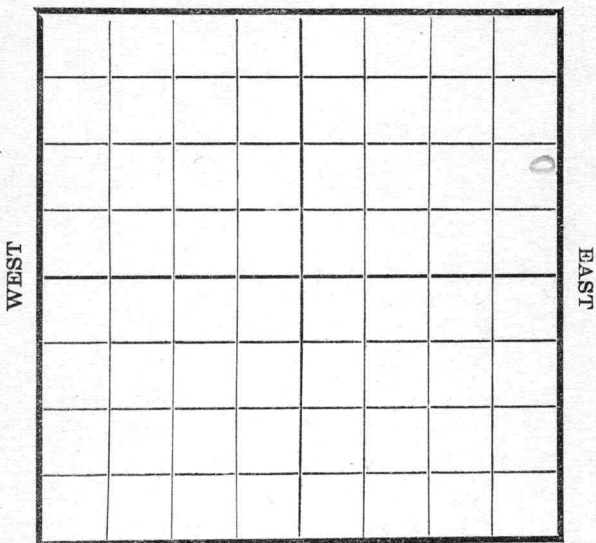

SOUTH

Location \_\_\_\_\_

Rig Up \_\_\_\_\_

Drilling and remarks

22  
2220

**RECORD**

Cased \_\_\_\_\_ in. \_\_\_\_\_ Ft.

Sand \_\_\_\_\_

Gas \_\_\_\_\_

Oil \_\_\_\_\_

Total Depth \_\_\_\_\_

**PRODUCTION**

1st 24 hrs. Nat. \_\_\_\_\_

1st 24 hrs. after shot \_\_\_\_\_

Gas \_\_\_\_\_ Cu. Ft.

Dry Hole \_\_\_\_\_

Abandoned \_\_\_\_\_

Date

5/22, 1918 C. Carter Scout

Map No. \_\_\_\_\_ Sec. 25 Twp. 26 R. 4

Well No. 2 Phillips Farm

Company

NORTH

WEST

## EAST

SOUTH

[illegible]

## Rig Up

Drilling and remarks

Fishing  
Q. Quising  
2220

## RECORD

Cased \_\_\_\_\_ in. \_\_\_\_\_ Ft

# Sand

# Gas

# Oil

Total Depth -----

## PRODUCTION

1st 24 hrs. Nat. \_\_\_\_\_

1st 24 hrs. after shot-----

Gas ----- Cu. Ft.

Dry Hole \_\_\_\_\_

Abandoned -----

Date \_\_\_\_\_

5739, 1918. C. C. C. Scout

Map No. \_\_\_\_\_ Sec. 25 Twp. 26 R. 4

Well No. 2 Phillips  
Carter Company

Company

Contractor

NORTH

WEST

# EAST

SOUTH

Location \_\_\_\_\_

Rig up.....

Drilling and Remarks:

## RECORD

Cased\_\_\_\_\_in., \_\_\_\_\_ft.

Sand.....

Gas \_\_\_\_\_

Oj1\_\_\_\_\_

Total Depth\_\_\_\_\_

## PRODUCTION

1st 24 hrs. Nat. \_\_\_\_\_

1st 24 hrs. after shot\_\_\_\_\_

Gas.....Cu. Ft.

Dry Hole.....

Abandoned\_\_\_\_\_

Date \_\_\_\_\_

191

Scout



Map No. \_\_\_\_\_ Sec. 25 Twp. 36 R. 4

Well No. 2 Phillips


Carter Company

Contractor

NORTH

WEST

EAST

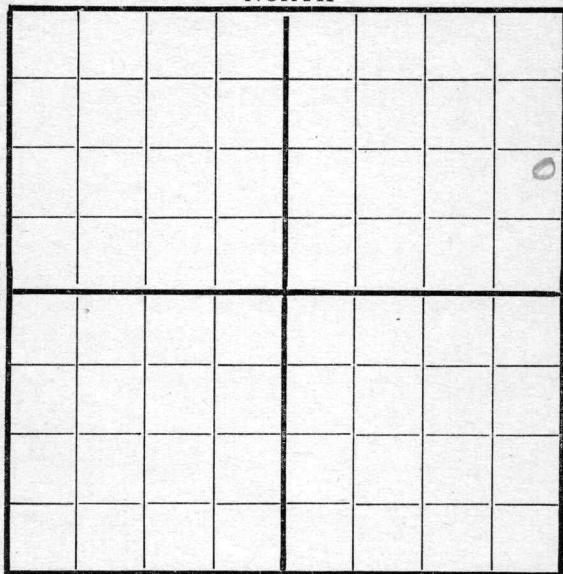

SOUTH

Location \_\_\_\_\_

Rig up \_\_\_\_\_

Drilling and Remarks:

**RECORD**

Cased \_\_\_\_\_ in., \_\_\_\_\_ ft.

Sand \_\_\_\_\_

Gas \_\_\_\_\_

Oil \_\_\_\_\_

Total Depth \_\_\_\_\_

**PRODUCTION**

1st 24 hrs. Nat. \_\_\_\_\_

1st 24 hrs. after shot \_\_\_\_\_

Gas \_\_\_\_\_ Cu. Ft.

Dry Hole \_\_\_\_\_

Abandoned \_\_\_\_\_


Date

6/12 1918 C. Carter Scout

Map No. \_\_\_\_\_ Sec. 25 Twp. 26 R. 4Well No. 2 PhillipsCarter Company

Contractor \_\_\_\_\_

NORTH

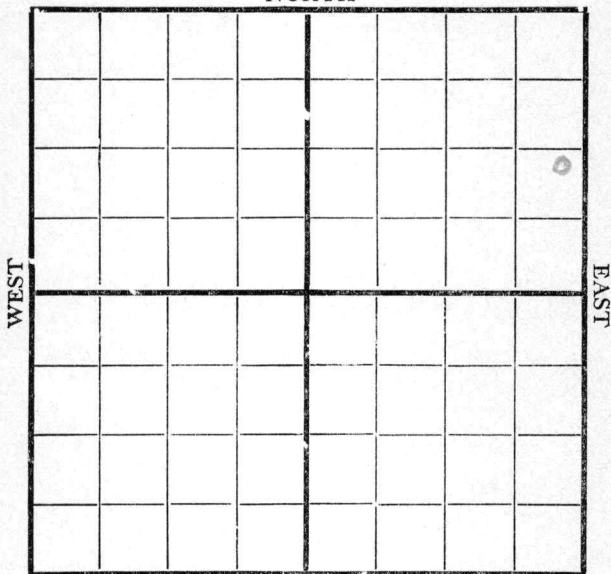

SOUTH

Location \_\_\_\_\_

Rig up \_\_\_\_\_

Drilling and Remarks:

*Top sand*  
*2685*

## RECORD

Cased \_\_\_\_\_ in., \_\_\_\_\_ ft.

Sand \_\_\_\_\_

Gas \_\_\_\_\_

Oil \_\_\_\_\_

Total Depth \_\_\_\_\_

## PRODUCTION

1st 24 hrs. Nat. \_\_\_\_\_

1st 24 hrs. after shot \_\_\_\_\_

Gas \_\_\_\_\_ Cu. Ft.

Dry Hole \_\_\_\_\_

Abandoned \_\_\_\_\_


Date

*6/19* 191*8* *Carter* Scout

Map No. K14 Sec. 25 Twp. 26 R. 4Well No. 2 PhillipsCenter CompanyCompany Tools Contractor

NORTH

WEST

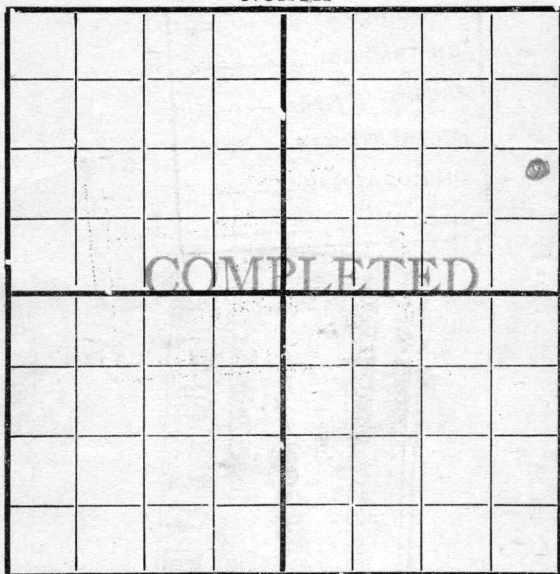

EAST

SOUTH

Location \_\_\_\_\_

Rig up \_\_\_\_\_

Drilling and Remarks:

Est at  
25 Bbls

## RECORD

Cased \_\_\_\_\_ in., \_\_\_\_\_ ft.

Sand 2670-2690

Gas \_\_\_\_\_

Oil \_\_\_\_\_

Total Depth \_\_\_\_\_

## PRODUCTION

1st 24 hrs. Nat. \_\_\_\_\_

1st 24 hrs. after shot \_\_\_\_\_

Gas \_\_\_\_\_ Cu. Ft.

Dry Hole \_\_\_\_\_

Abandoned \_\_\_\_\_

Date

6/26 1918 Cordell Scout