


STATE KANSAS		COMPANY MAGNOLIA PET.	
COUNTY HARVEY CO		FARM SCHMIDT	WELL NO 4
T. 22	R. 3W	DIVISION	DISTRICT
SURVEY 30		KIND OF RIG	
		COMMENCED 11-19-33	
		COMPLETED 12-31-33	
		REMARKS SW NW NE	
		990' NL, 330' WL of W/2 NE/4	
ELEV. 1451			
PRODUCTION INITIAL 955 SETTLED 1015			
955 lbs Pot.			

CASING AND SCREEN RECORD	
15 - 452	
8 - 3347	
5 1/2" — 3592 Corr.	

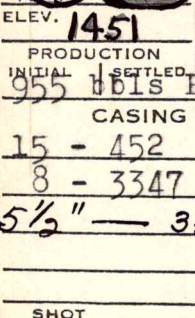