
FORM 51

Butler KANSAS

Section 2 Township 26 Range 7E

Well No. 1 Easater

Company White & Ellis

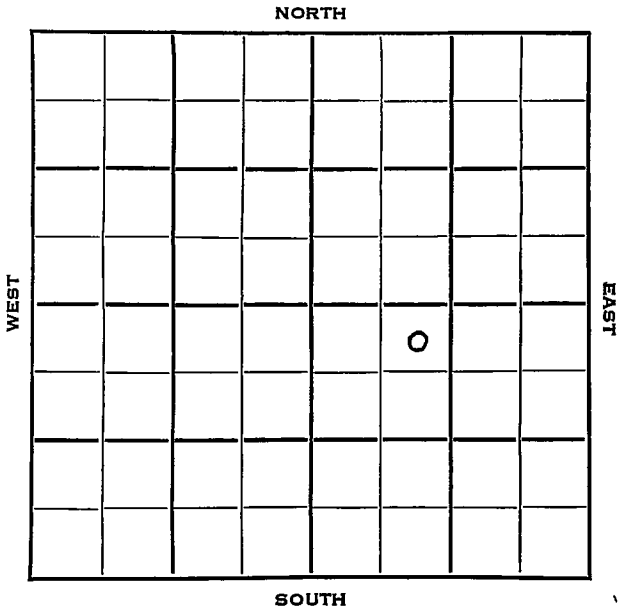

Butler . KANSAS

SEC.	TWP.	R.
2	26	7 E

WELL NO.

1 Lasater FARM
COMPANY

White & Ellis
CONTRACTOR

Wildcat


330 Ft. from N. Line

Ft. from S. Line

Ft. from E. Line

990 Ft. from W. Line

NE NW SE

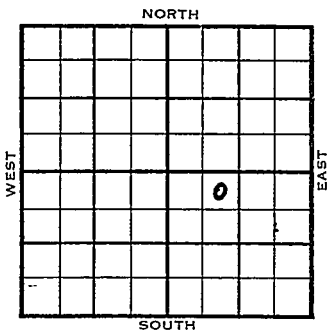

1953	ELEVATION 1494' IS REPORT
9/16	KC 2069' B KC 2258' Miss 2731' 5" @ 2731 TD 2737' WOCT
9/30	D & A TD 2779' KC 2069', B KC 2258, Miss 2731 5½ @ 2731' TD 2737' DD 2741' 2000 A 6 go 20 gwph DD 2779 36 go 13½ bw 6 hr. D & A

ABANDONED

DX-78

FORM 275 FOR SALE BY KANSAS BLUE PRINT CO.


County Butler State Kansas

Sec. 2 (Blk. Twp.) 26 (Sur. Rge.) 7E Map No.

Operator White & Ellis

Well No. 1 Farm Iasater

Elev. 1494 Location NE NW SE

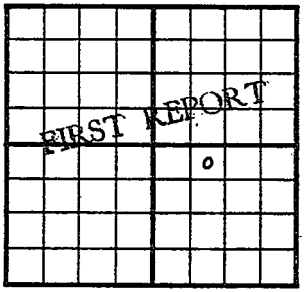

330 Ft. From N Line SE

990 Ft. From W Line Quarter

SEP 16 1953

1st. Report

Completion

Remarks

Spudding Date

Drlg. Data Wildcat

KC 2069 B KC 2258 Miss. 2731

5" @ 2731 TD 2737 WOCT

J. G. McGEHEE

FORM 275 FOR SALE BY KANSAS BLUE PRINT CO.


County Butler State Kansas

Sec. 2 (Blk. Twp.) 2 6 (Sur. Rge.) 7E Map No.

Operator White & Ellis

Well No. 1 Farm Lasater

Elev. 1492 LS Location NE NW SE

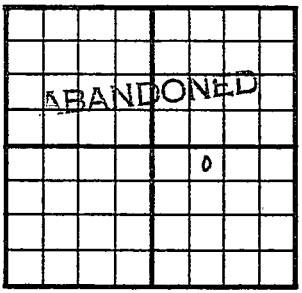

330 Ft. From N Line SE

990 Ft. From W Line Quarter

1st. Report

Completion SEP 30 1953

Remarks Wildcat

Spudding Date

Drlg. Data D & A TD 2779

KC 2069 B KC 2258 Miss. 2731

5" @ 2731 TD 2737 DD 2741 2000 A

6 go 20 gwph DD 2779 36 go 18½ bw 6 h

D & A

J. G. McGEHEE