


Map No. N-14 Sec. 24 Twp. 26 R. 4Well No. 13 Richards Farm
Patton et al Company

NORTH

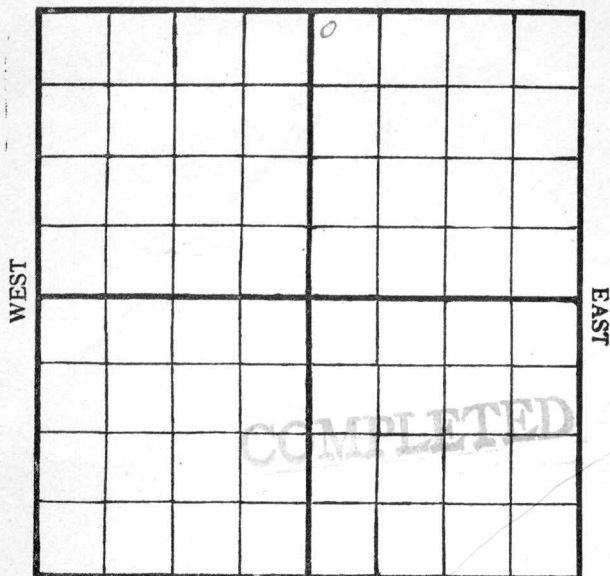

SOUTH

Location -----

Rig Up -----

Drilling Remarks:

Drilling Remarks:

RECORD

Cased ----- in. ----- ft.

Sand -----

Gas -----

Oil -----

Total Depth -----

PRODUCTION

1st 24 hrs. Nat. -----

1st 24 hrs. after shot -----

Gas ----- cu. ft.

Dry Hole -----

Abandoned -----

Map No. 1514 Sec. 24 Twp. 26 R. ✓Well No. 13 RiskPatton et al Company

Contractor

NORTH

WEST

EAST

SOUTH

Location _____

Rig up ✓

Drilling and Remarks:

RECORD

Cased _____ in., _____ ft.

Sand _____

Gas _____

Oil _____

Total Depth _____

PRODUCTION

1st 24 hrs. Nat. _____

1st 24 hrs. after shot _____

Gas _____ Cu. Ft.

Dry Hole _____

Abandoned _____

FIRST REPORT

Date

7/24 191 8 Conley Scout

Map No. _____ Sec. 24 Twp. 26 R. 4Well No. 13 RichardsPatton et al


Company _____

Contractor _____

NORTH

WEST

EAST

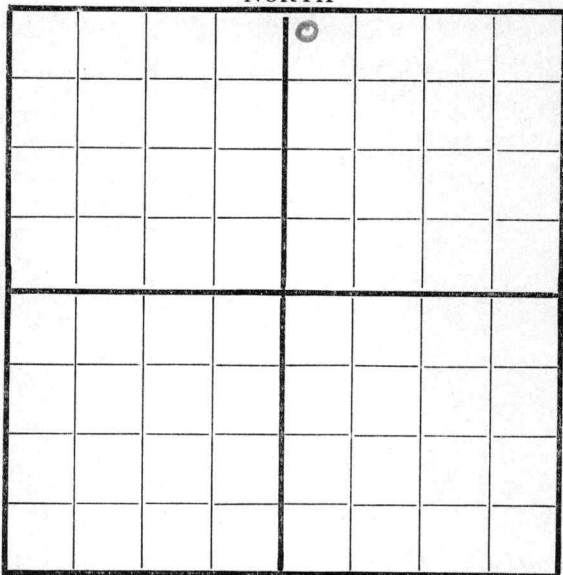

SOUTH

200' ~~87.5~~ 152 x 200' ~~87.5~~ 152

Location _____

Rig up ☒

Drilling and Remarks:

RECORD

Cased _____ in., _____ ft.

Sand _____

Gas _____

Oil _____

Total Depth _____

PRODUCTION

1st 24 hrs. Nat. _____

1st 24 hrs. after shot _____

Gas _____ Cu. Ft.


Dry Hole _____

Abandoned _____

Date

7/31 191 8 Cuddy Scout

Map No. _____ Sec. 24 Twp. 26 R. 4
Well No. 13 Richmond
Patterson et al Company
Contractor _____

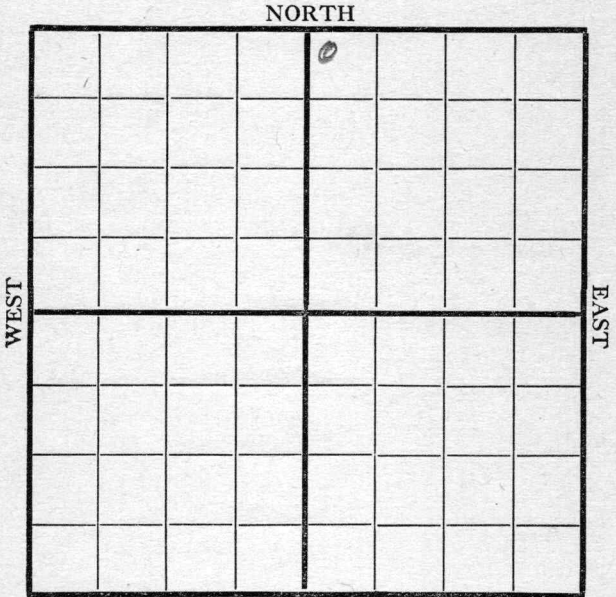

200 N & W

Location _____ Rig up ☒ Drilling and Remarks: _____	RECORD
	Cased _____ in., _____ ft. Sand _____ Gas _____ Oil _____ Total Depth _____
	PRODUCTION
	1st 24 hrs. Nat. _____ 1st 24 hrs. after shot _____ Gas _____ Cu. Ft. Dry Hole _____ Abandoned _____

Date 8/2 191 8 Conley Scout

Map No. _____ Sec. 24 Twp. 26 R. 4Well No. 13 _____

_____ Company

_____ Contractor

NORTH

WEST

				0			

EAST

SOUTH

Location 200 N
200 WRig up ☒

Drilling and Remarks:

RECORD

Cased _____ in., _____ ft.

Sand _____

Gas _____

Oil _____

Total Depth _____

PRODUCTION

1st 24 hrs. Nat. _____

1st 24 hrs. after shot _____

Gas _____ Cu. Ft.

Dry Hole _____

Abandoned _____

Date

7/5 1918 8 Cyle Scout


Map No. _____ Sec. 24 Twp. 26 R. 4Well No. 13 Richard
Patton et al Company _____

Contractor _____

NORTH

WEST

EAST

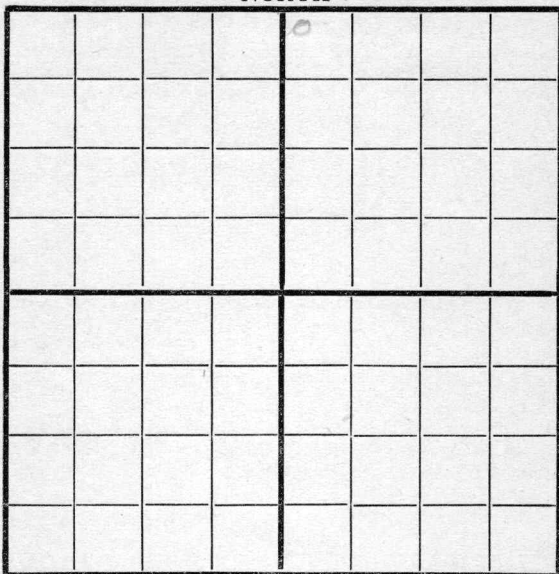

SOUTH

200 ft x 100 ft

Location _____

Rig up ☒

Drilling and Remarks:

RECORD

Cased _____ in., _____ ft.

Sand _____

Gas _____

Oil _____

Total Depth _____

PRODUCTION

1st 24 hrs. Nat. _____

1st 24 hrs. after shot _____

Gas _____ Cu. Ft.

Dry Hole _____

Abandoned _____

Date

8/28/8 Candy

Map No. _____ Sec. 24 Twp. 26 R. 4Well No. 13 RichmondCompany Patton et alContractor Phinchett & SonsEl Dorado NORTH Ks

WEST

EAST

SOUTH

Location _____

Rig up ☒

Drilling and Remarks:

300

RECORD

Cased _____ in., _____ ft.

Sand _____

Gas _____

Oil _____

Total Depth _____

PRODUCTION

1st 24 hrs. Nat. _____

1st 24 hrs. after shot _____

Gas _____ Cu. Ft.

Dry Hole _____

Abandoned _____

Date

9/4

191

El Dorado

Scout

Map No. K14 Sec. 24 Twp. 26 R. 4Well No. 13 Richard
Patton et al Company

Contractor

NORTH

WEST

EAST

SOUTH

200 Y-W-

Location _____

Rig up _____

Drilling and Remarks:

1050

RECORD

Cased _____ in., _____ ft.

Sand _____

Gas _____

Oil _____

Total Depth _____

PRODUCTION

1st 24 hrs. Nat. _____

1st 24 hrs. after shot _____

Gas _____ Cu. Ft.

Dry Hole _____

Abandoned _____

Date

9/4

191

8Conley

Scout

Map No. K14 Sec. 24 Twp. 26 R. 4Well No. 13 RichardsonPatton et al Company

Contractor

NORTH

WEST

EAST

SOUTH

RECORD

Location _____

Cased _____ in., _____ ft.

Rig up _____

Sand _____

Drilling and Remarks:

Gas _____

Oil _____

Total Depth _____

PRODUCTION

1st 24 hrs. Nat. _____

1st 24 hrs. after shot _____

Gas _____ Cu. Ft.

Dry Hole _____

Abandoned _____

Date

9/18 1918 Co. 1 Scout


Map No. K14 Sec. 24 Twp. 26 R. 4Well No. 13 RichmondCompany Patton et al

Contractor _____

NORTH

WEST

EAST

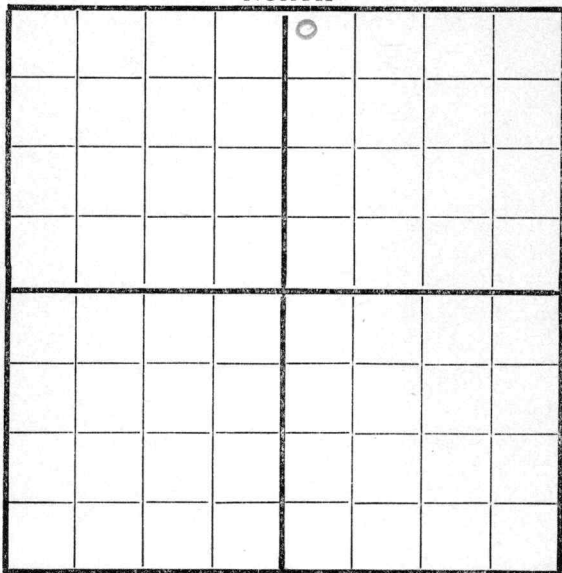

SOUTH

Location _____

Rig up _____

Drilling and Remarks:

2000

RECORD

Cased _____ in., _____ ft.

Sand _____

Gas _____

Oil _____

Total Depth _____

PRODUCTION

1st 24 hrs. Nat. _____

1st 24 hrs. after shot _____

Gas _____ Cu. Ft.

Dry Hole _____

Abandoned _____

Date


9/25 191 8 Candy Scout

Map No. K14 Sec. 24 Twp. 26 R. 4Well No. 13 Richmond
Patterson et al Company
Contractor

NORTH

WEST

EAST

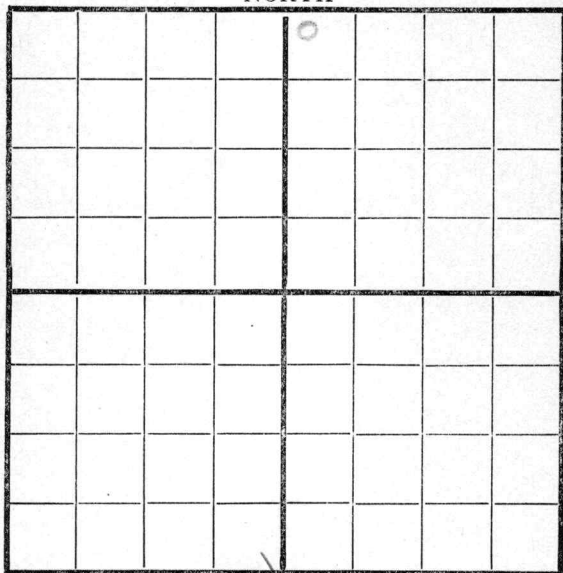

SOUTH

Location _____

Rig up _____

Drilling and Remarks:

2600

RECORD

Cased _____ in., _____ ft.

Sand _____

Gas _____

Oil _____

Total Depth _____

PRODUCTION

1st 24 hrs. Nat. _____

1st 24 hrs. after shot _____

Gas _____ Cu. Ft.

Dry Hole _____

Abandoned _____

Date

10/2 1918 Candley Scout

MAP No. K19 KANSAS SEC. 24 TWP. 76S R. 4E

WELL No. 13 Redbird

Patton et al COMPANY

CONTRACTOR

SECTION PLAT

ABANDONED

_____ FT. FROM N. LINE

_____ FT. FROM S. LINE

_____ FT. FROM E. LINE

_____ FT. FROM W. LINE

		0	

LOCATION _____

RIG UP _____

DRILLING AND REMARKS:

SK

RECORD

CASED _____ IN. _____ FT.

SAND _____

GAS _____

OIL _____

TOTAL DEPTH 7650

PRODUCTION

1ST 24 HRS. NAT. _____

1ST 24 HRS. AFTER SHOT _____

GAS _____ Cu. Ft.

DRY HOLE ☒

ABANDONED ☒

DATE

10/9 1918 SCOUT

Map No. 1514 Sec. 24 Twp. 26 R. 4

Well No. 13 Richards


Elmer K. Kline Contractor

NORTH

WEST

EAST

COMPLETED

SOUTH

200' N-W

Location _____

Rig up _____

Drilling and Remarks:

Dry & abandoned

2642

RECORD

Cased _____ in., _____ ft.

Sand 2628-2642 water

Gas _____

Oil _____

Total Depth _____

PRODUCTION

1st 24 hrs. Nat. _____

1st 24 hrs. after shot _____

Gas _____ Cu. Ft.

Dry Hole _____

Abandoned _____

Date

10/10

191

P. Condy

Scout