


Butler

Form 51—5M—11-31—Palace

Map No. _____ Sec. *11* Twp. *26* R. *4^E*

Well No. *19 - Ladd* Farm _____
Gypsum Oil Company _____

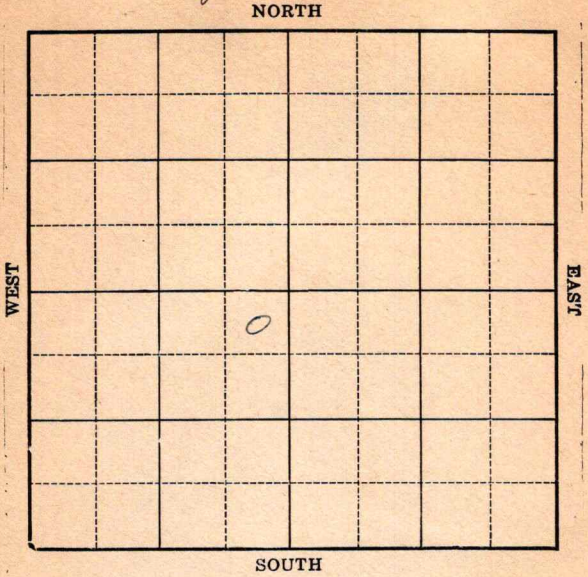

Location _____
Drilling Remarks _____

RECORD

Cased _____ in. _____ ft.
Sand _____
Gas _____
Oil _____
Total Depth _____

Rig Up _____
Drilling Remarks _____

PRODUCTION

1st 24 hrs. Nat. _____
1st 24 hrs. after shot _____
Gas _____ cu. ft.
Dry Hole _____
Abandoned _____

Butler

Map No. KANSAS Sec. 11 Twp. 26 R. 4⁸

Well No. 19 Ladd Farm


Geyser Oil Company

330' Ft. from N. Line

 Ft. from S. Line

330' Ft. from E. Line

 Ft. from W. Line

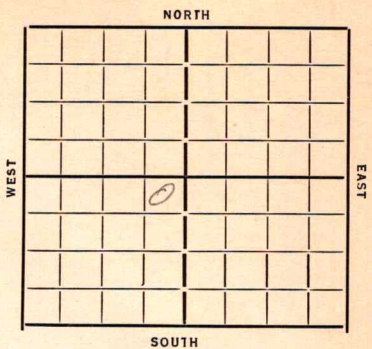

Date 1933

REPORT

12/6 Wlg 265

12/13 " 1150'

12/27 30,000 gal at 1385

6" at 1630

T.D. 1720 S.D.

1934
1/10 L.C. Line 1917 T.D. 1961

1000 gal acid, 76 lbs oil

20 lbs water

COMPLETED

Map No. 14 Sec. 11 Twp. 26 R. 4E

Well No. 19-Ladd


Contractor

SECTION PLAT

330 Ft. from N. Line

Ft. from S. Line

330 Ft. from E. Line

Ft. from W. Line

Location

Rig up

Drilling and Remarks:

Leg 265

RECORD

Cased in., ft.

Sand

Gas

Oil

Total Depth

PRODUCTION

1st 24 hrs. Nat.

1st 24 hrs. after shot

Gas Cu. Ft.

Dry Hole

Abandoned

Date

12-6-33 192 O. Mannick Scout

Butler
Map No. 14 Sec. 11 Twp. 26 R. 4 EWell No. 19-LaddSperry oil Company

Contractor

SECTION PLAT

330 Ft. from N. Line

Ft. from S. Line

330 Ft. from E. Line

Ft. from W. Line

COMPLETED

	0		

Location

Rig up

Drilling and Remarks:

1000 gal acid76 oil
20 water

RECORD

Cased _____ in., _____ ft.

Sand K.E.L. 1917

Gas _____

Oil _____

Total Depth 1961

PRODUCTION

1st 24 hrs. Nat. _____

1st 24 hrs. after shot _____

Gas _____ Cu. Ft.

Dry Hole _____

Abandoned _____

Date

1-10-34 192 O. Mammuch Scout