
FORM 51

Butler KANSAS

Section 10 Township 26 Range 7 E

Well No. # 1 Newby

Company Rex & Morris

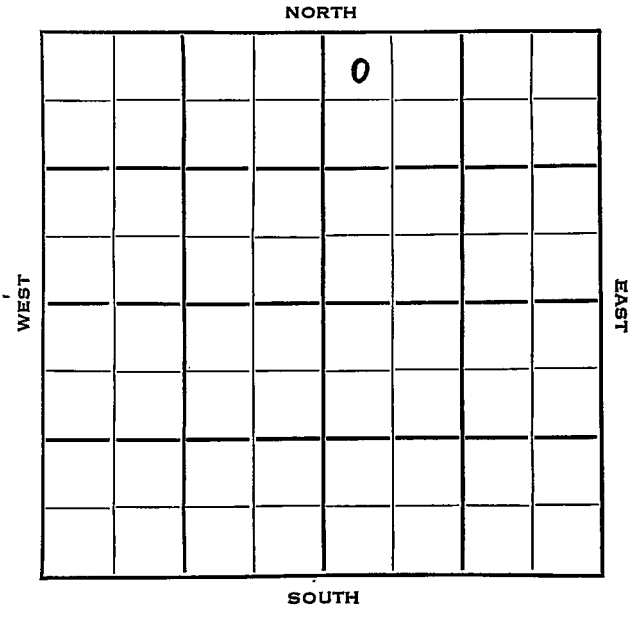

FORM 252-B

Butler KANSAS

Sec. 10 Twp. 26 R. 7E

Well No. #1 Newby Farm

Rex & Morris Company

Rex & Morris Contractor

Wildcat


330 Ft. from N. Line

Ft. from S. Line

Ft. from E. Line

330 Ft. from W. Line

NW NW NE

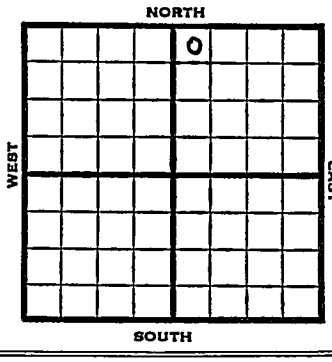

1953	Elev. 1488' REPORT
7/22	Location
10/7	Spud 9-16-53 Oil Well TD 2772' 8" @ 96' Miss 2753 TD 2772' 5" @ 2761' CO to 2772 4 bo 4 bw 16 hr. 1000 A Comp 2 bopd.

COMPLETED

FORM 275 FOR SALE BY KANSAS BLUE PRINT CO.


County Butler State Kansas

Sec. 10 (Blk. Twp.) 26 (Sur. Rge.) 7E Map No.

Operator Rex & Morris

Well No. 1 Farm Newby

Elev. Location NW NW NE

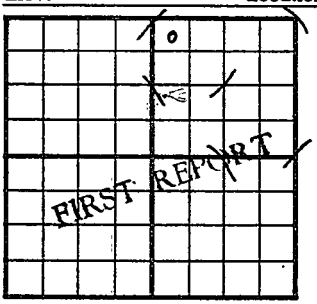

330 Ft. From N Line NE

330 Ft. From W Line Quarter

1st. Report JUL 2 1953

Completion

Remarks

Rex & Morris - Contr.

Spudding Date

Drlg. Data Wildcat

Location

J. G. McGEHEE

FORM 275 FOR SALE BY KANSAS BLUE PRINT CO.


County Butler State Kansas

Sec. 10 (Blk. Twp.) 26 (Sur. Rge.) 7E Map No.

Operator Rex & Morris

Well No. 1 Farm Newby

Elev. 1488 Location NW NW NE

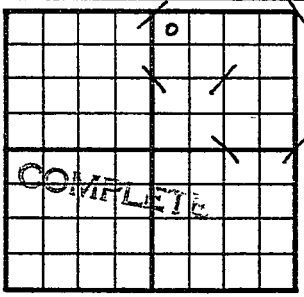

330 Ft. From N Line NE

330 Ft. From W Line Quarter

1st. Report

Completion OCT 7 1953

Remarks Wildcat

Rex & Morris - Contr.

Spudding Date 9-16-53

Drlg. Data Oil well TD 2772

8" @ 96 Miss. 2753 TD 2772

5" @ 2761 CO to 2772. 4 bo 4 bw 16 hr.

1000 A Comp. 2 bopd

J. G. McGEHEE