


E)lis.
 D. Clinton
 Phillips Petro.
 Company


Range 17
 Township 12 S
 Section 5

Sec. NW
 Elev. --- T.D. 3654'
 Date Drilled 5-21-30.
 Correlation by ---
 Prod-193 B.-24 hr.

Sec.			Twp.		
6	7	8	4	3	2
18	17	16	10	11	12
19	20	21	22	23	24
30	29	28	27	26	25
31	32	33	34	35	36

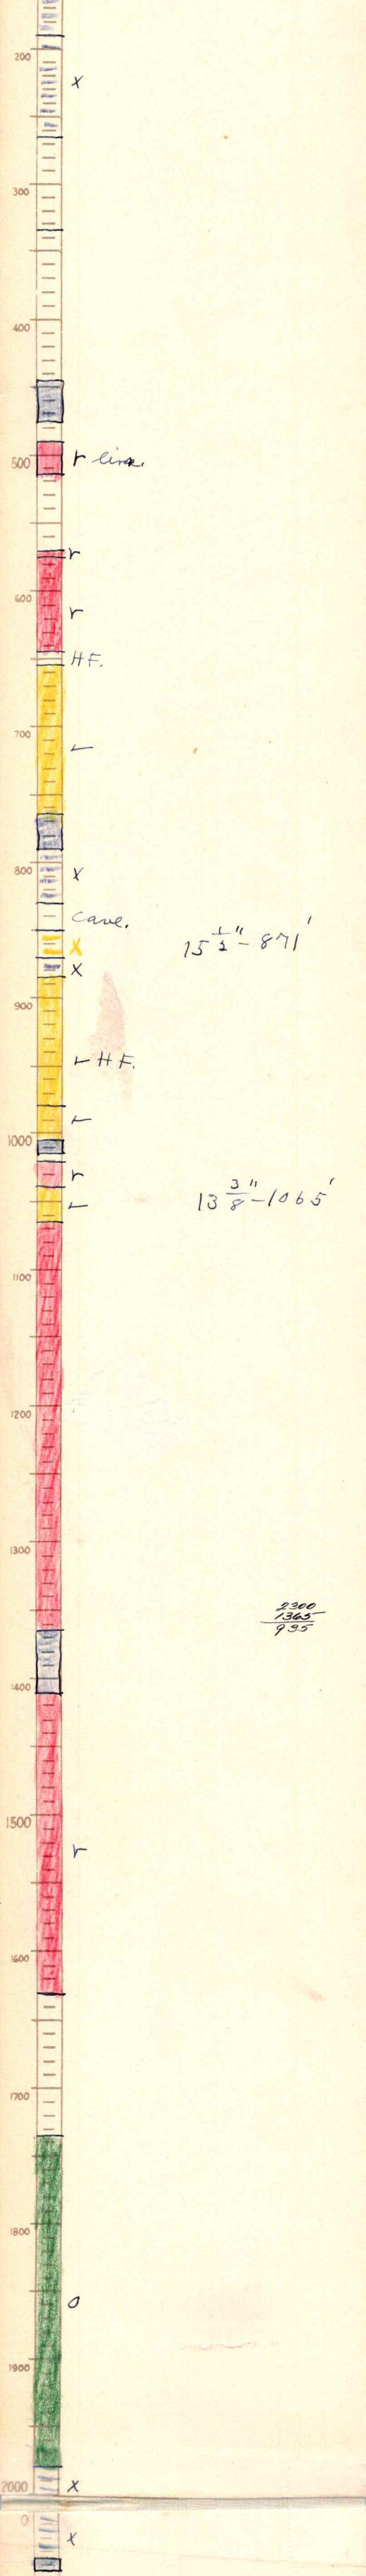

2300
 1365
 935

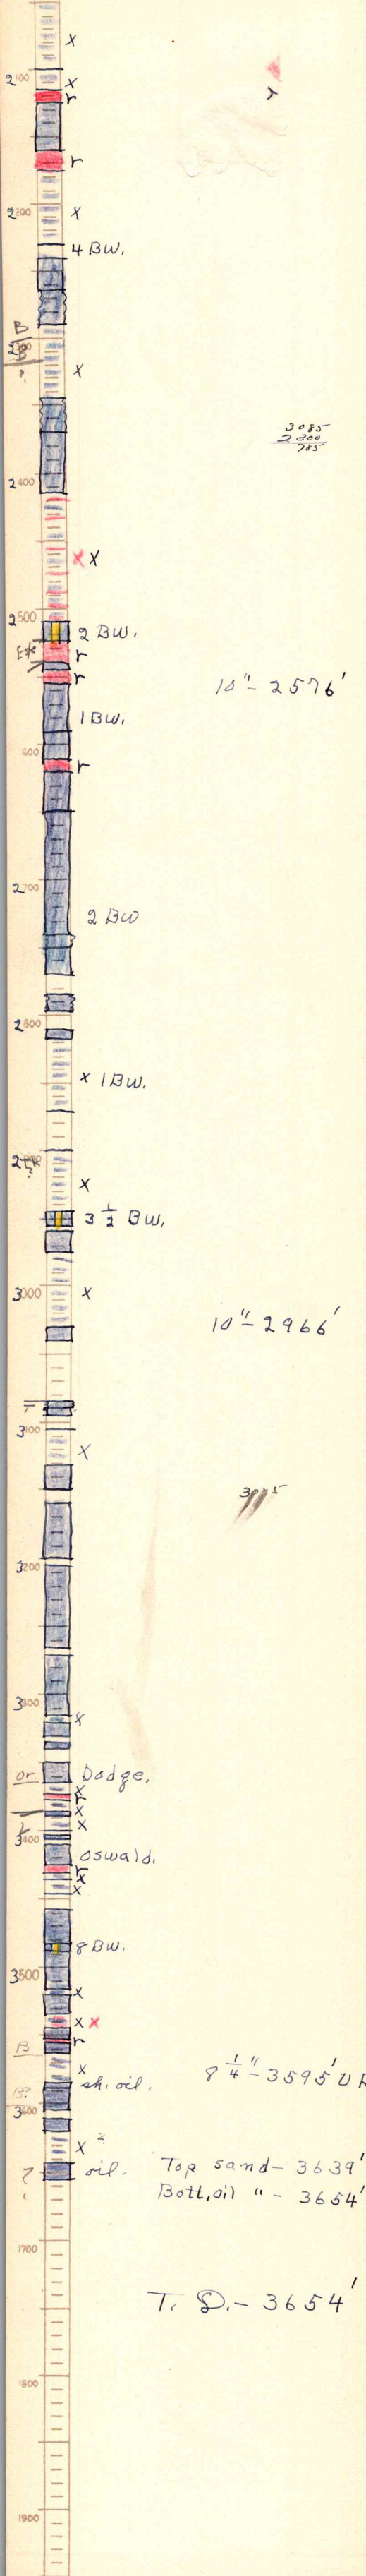

3085

10" - 2576'

10" - 2966'

8 1/4" - 3595' UR.

Top sand - 3639'
 Bott. oil " - 3654'

T. D. - 3654'