

Sec. 7 Twp. 26 Range 7

#2 Demoure

Kansas Geological Society

Demoure Syndicate

Skelly Scout Tickets

Map No. _____ Sec. 7 Twp. 26 R. 7Well No. 2 Demaure Farm
Demaure Company


Contractor _____

NE Quarter600 Ft. from N. Line

Ft. from S. Line

200 Ft. from E. Line

Ft. from W. Line

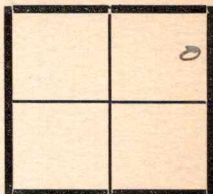Date 1/19

REPORT

10/11 AD. 1000'1/24 LD 100010/1 AD. 1000'11/8 AD. 1000'13 LD 100022 AD. 1000'26 AD 100012/6 AD 1000'13 AD. 1000'20 AD 1000'23 AD. 1000'14/20 AD. 1000'7 ✓ ✓24 Shut Down 1000'2/14 ✓ ✓ ✓3/7 ✓ ✓13 Pulling pipe to skid @ 10004/2 Skid Rig24 Drly 35029 ✓ 1100Cover

5/20 - 20 1100

31 ✓ ✓

4/23 SD for 6" @ 2400

7/3 ✓ - -

11 6 5/8 2400

24 Lrg @ 2400

8/21 - SD. 2769 (200 ft oil
1000 ft water)

8/27 fag M.R. @ 2769

9/3 fag ✓ -

9/11 fag ✓ ✓

9/15 fag ✓ 2769

12 SD -

9-29 - -

10/20 2763-65 - RD 2769 -

Plugged back to 2765
15 bbls.

- 2761 2762 2763 2764 2765

Map No. K 15 Sec. 7 Twp. 26 R. 7
Well No. 2 Demour
Demour Syndicate Company
Contractor

NORTH

WEST										EAST
600 N SOUTH 200 E										

FIRST REPORT
CHANGE LESSEE NAME

Location _____

Rig up _____

Drilling and Remarks:

Timbers

RECORD

Cased _____ in., _____ ft.
Sand _____
Gas _____
Oil _____
Total Depth _____

PRODUCTION

1st 24 hrs. Nat. _____
1st 24 hrs. after shot _____
Gas _____ Cu. Ft.
Dry Hole _____
Abandoned _____

Date

3/26 1919

Pyle


Scout

Map No. K15 Sec. 7 Twp. 26 R. 7
 Well No. 2 Demare
Demare Syndicate Company
 Contractor

NORTH

WEST

EAST

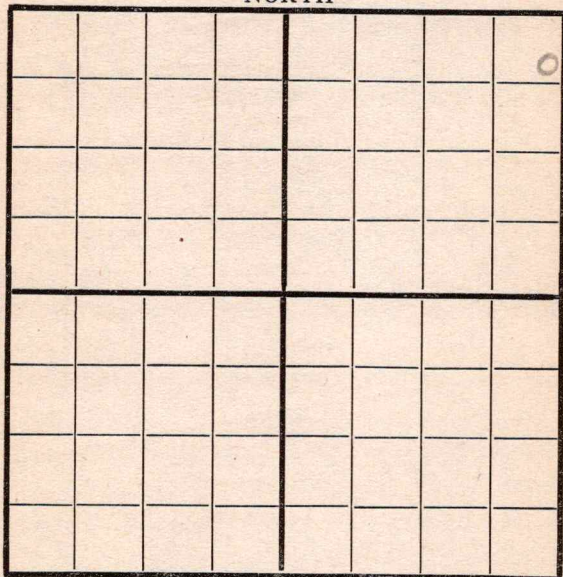

SOUTH

600 N

200 E

Location _____

Rig up ☒ _____

Drilling and Remarks:

RECORD

Cased _____ in., _____ ft.

Sand _____

Gas _____

Oil _____

Total Depth _____

PRODUCTION

1st 24 hrs. Nat. _____

1st 24 hrs. after shot _____

Gas _____ Cu. Ft.

Dry Hole _____

Abandoned _____

Date

4/3

191

9

Pyle


Scout

Map No. K 15 Sec. 7 Twp. 26 R. 7Well No. 2 Demour
Demour Syndicate Company
Contractor

NORTH

WEST

EAST

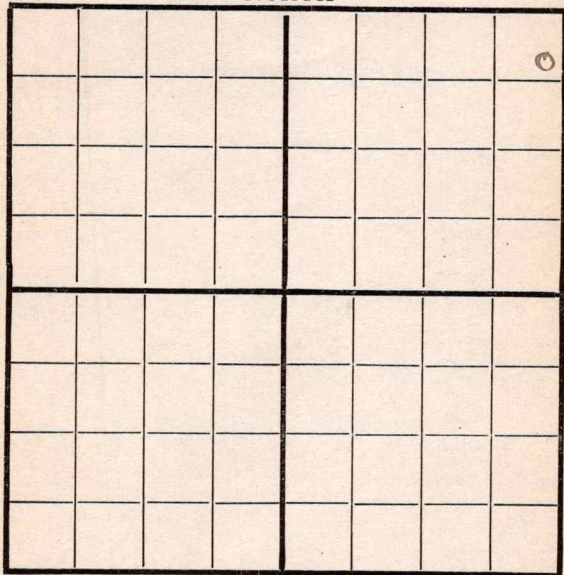

600 N

SOUTH

200 E

Location _____

Rig up ☒ _____

Drilling and Remarks:

RECORD

Cased _____ in., _____ ft.

Sand _____

Gas _____

Oil _____

Total Depth _____

PRODUCTION

1st 24 hrs. Nat. _____

1st 24 hrs. after shot _____

Gas _____ Cu. Ft.

Dry Hole _____

Abandoned _____

Date


4/11

1919

Pyle

Scout

Map No. K15 Sec. 7 Twp. 26 R. 7
Well No. 2 Demour
Demour Syndicate Company
Contractor

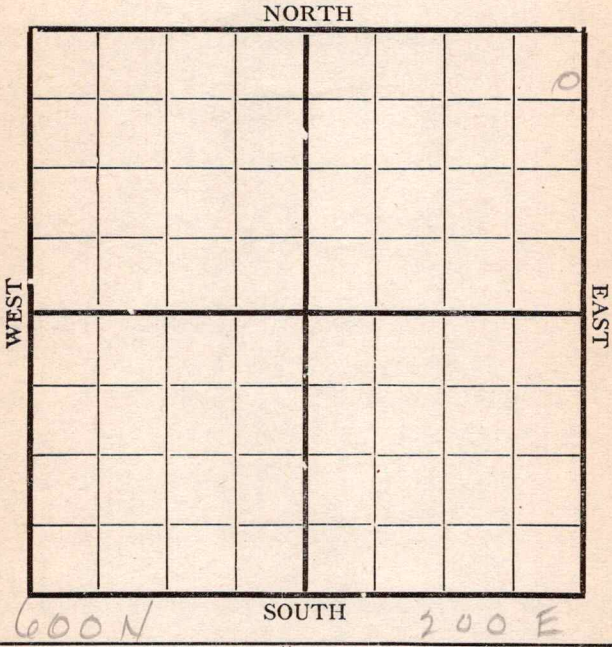


	RECORD
Location _____	Cased _____ in., _____ ft.
Rig up ☒	Sand _____
Drilling and Remarks:	Gas _____
	Oil _____
	Total Depth _____
	PRODUCTION
	1st 24 hrs. Nat. _____
	1st 24 hrs. after shot _____
	Gas _____ Cu. Ft.
	Dry Hole _____
	Abandoned _____

Map No. K 15 Sec. 07 Twp. 26 R. 7
 Well No. 2 Demourel
Demourel Syndicate Company
 Contractor

NORTH

WEST

EAST

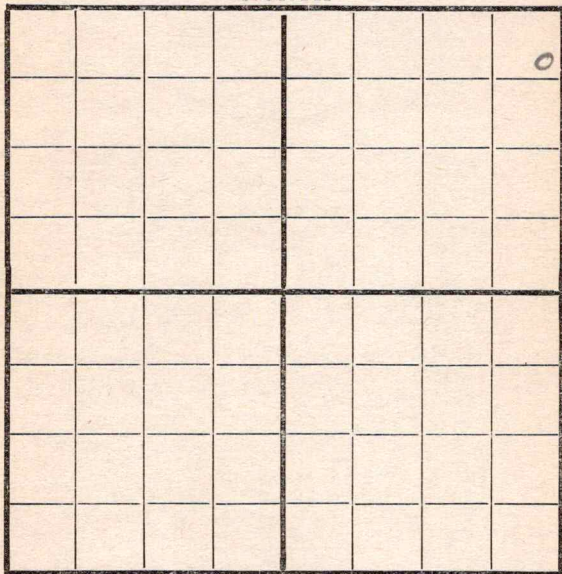

SOUTH

600 N

200 E

Location _____

Rig up ☒ _____

Drilling and Remarks:

RECORD

Cased _____ in., _____ ft.

Sand _____

Gas _____

Oil _____

Total Depth _____

PRODUCTION

1st 24 hrs. Nat. _____

1st 24 hrs. after shot _____

Gas _____ Cu. Ft.

Dry Hole _____

Abandoned _____

Date

4/23 1919

Pyle


Scout

Map No. K15 Sec. 07 Twp. 26 R. 7
 Well No. 2 Demour
Demour Syndicate Company
 Contractor

NORTH

WEST

EAST

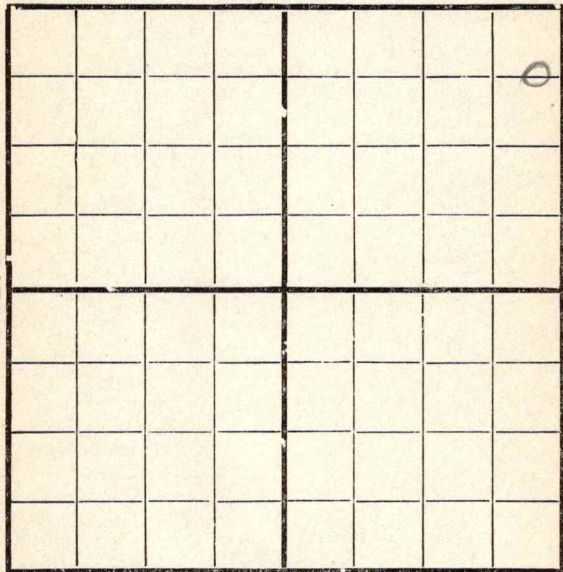

660 N

SOUTH

200 E

Location _____

Rig up _____

Drilling and Remarks:

Rigged
 up
 S.D.

RECORD

Cased _____ in., _____ ft.

Sand _____

Gas _____

Oil _____

Total Depth _____

PRODUCTION

1st 24 hrs. Nat. _____

1st 24 hrs. after shot _____

Gas _____ Cu. Ft.

Dry Hole _____

Abandoned _____

Date

5/7 191 9 **Pyle** Scout

Map No. K15 Sec. 7 Twp. 26 R. 7

Well No. 2 Demourse


Demourse Syndicate Company

Contractor

NORTH

WEST

EAST

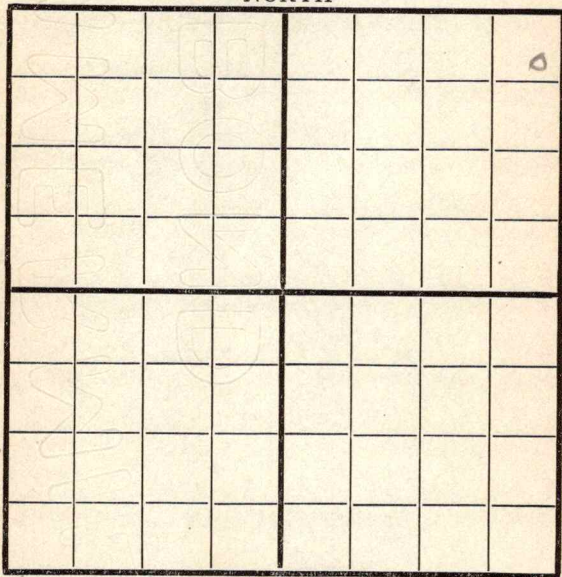

600 N

SOUTH

200 E

Location _____

Rig up _____

Drilling and Remarks:

Rigged up

RECORD

Cased _____ in., _____ ft.

Sand _____

Gas _____

Oil _____

Total Depth _____

PRODUCTION

1st 24 hrs. Nat. _____

1st 24 hrs. after shot _____

Gas _____ Cu. Ft.

Dry Hole _____

Abandoned _____

Date


5/18

1919

Pyke

Scout

Map No. K15 Sec. 7 Twp. 26 R. 7
 Well No. 2 Demour
Demour Syndicate Company
 Contractor

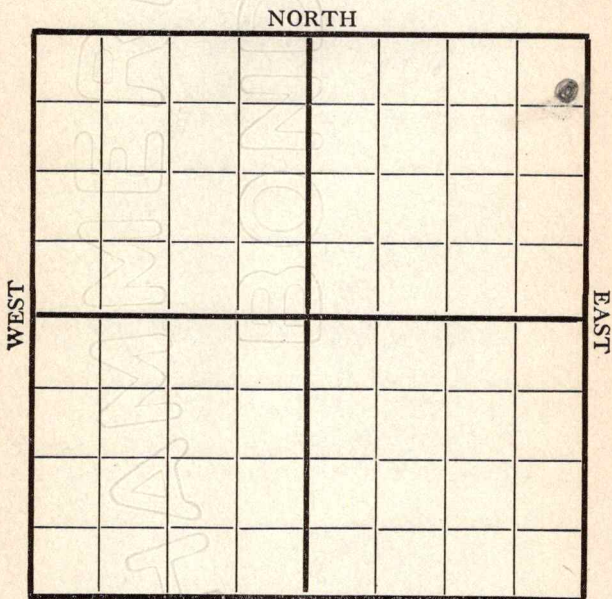

1000 N SOUTH 200 E

Location _____

Rig up _____

Drilling and Remarks:

*Rigged up
&
S.D.*

RECORD

Cased _____ in., _____ ft.

Sand _____

Gas _____

Oil _____

Total Depth _____

PRODUCTION

1st 24 hrs. Nat. _____

1st 24 hrs. after shot _____

Gas _____ Cu. Ft.

Dry Hole _____

Abandoned _____

Date

Pyle

1919


Scout

Map No. K15 Sec. 7 Twp. 26 R. 7Well No. 2 Demour
Demour Syndicate Company
Contractor

NORTH

WEST

EAST

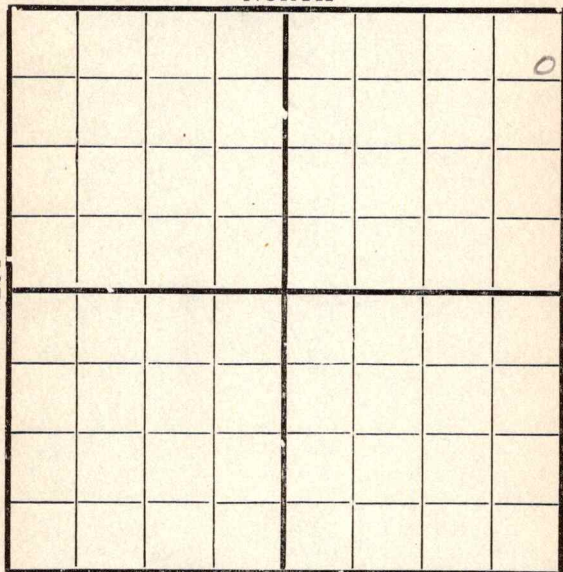

600 N

SOUTH

200 E

Location _____

Rig up _____

Drilling and Remarks:

Rigged up
8
S.D.

RECORD

Cased _____ in., _____ ft.

Sand _____

Gas _____

Oil _____

Total Depth _____

PRODUCTION

1st 24 hrs. Nat. _____

1st 24 hrs. after shot _____

Gas _____ Cu. Ft.


Dry Hole _____

Abandoned _____

Date

5/29 1919 Pyle Scout

Map No. K15 Sec. 7 Twp. 26 R. 7
Well No. 2 Hemoure
Hemoure Syndicate Company
Contractor

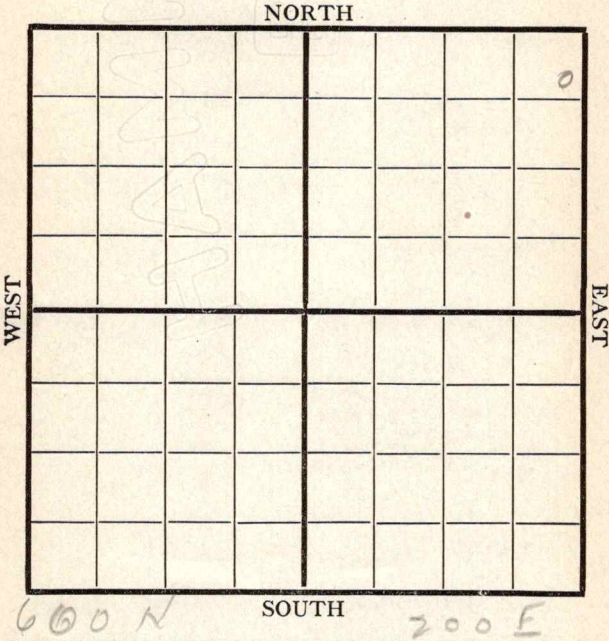

Location _____
Rig up _____
Drilling and Remarks:

RECORD

Cased _____ in., _____ ft.
Sand _____
Gas _____
Oil _____
Total Depth _____

PRODUCTION


1st 24 hrs. Nat. _____
1st 24 hrs. after shot _____
Gas _____ Cu. Ft.
Dry Hole _____
Abandoned _____

Date 6/6 1919 Pyle Scout

Map No. K 15 Sec. 7 Twp. 26 R. 7Well No. 2 DemourDemour Syndicate Company

Contractor

NORTH

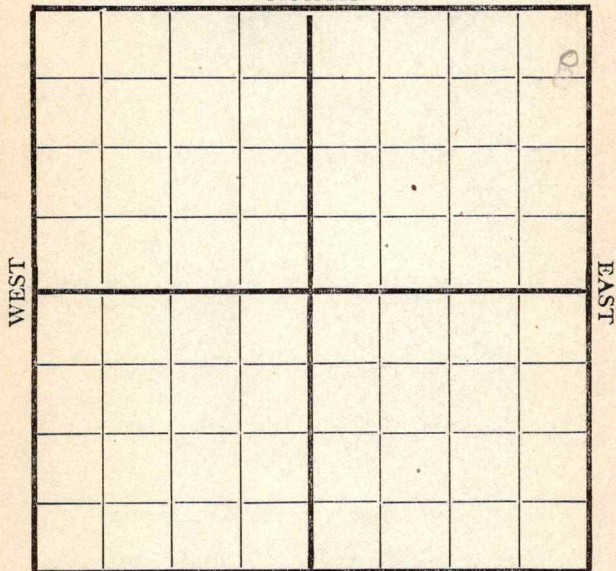

600 N

SOUTH

200 E

Location _____

Rig up _____

Drilling and Remarks:

Trying to Swedge
out 15' @
150'

RECORD

Cased _____ in., _____ ft.

Sand _____

Gas _____

Oil _____

Total Depth _____

PRODUCTION

1st 24 hrs. Nat. _____

1st 24 hrs. after shot _____

Gas _____ Cu. Ft.

Dry Hole _____

Abandoned _____

Date


6/13 1919

Pyle

Scout

Map No. K15 Sec. 7 Twp. 26 R. 7
 Well No. 2 Demore
Demore Syndicate Company
 Contractor

NORTH

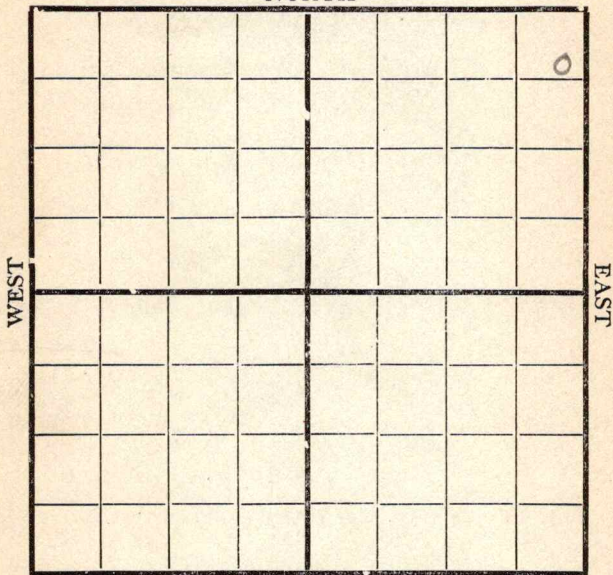

600 N

SOUTH

200 E

Location _____

Rig up _____

Drilling and Remarks:

515'

RECORD

Cased _____ in., _____ ft.

Sand _____

Gas _____

Oil _____

Total Depth _____

PRODUCTION

1st 24 hrs. Nat. _____

1st 24 hrs. after shot _____

Gas _____ Cu. Ft.

Dry Hole _____

Abandoned _____

Date

6/19

1919

Pyle

S

Map No. K15 Sec. 7 Twp. 26 R. 7
Well No. 2 Demour
Demour Syndicate Company
Contractor

NORTH

WEST

EAST

							0

SOUTH

600 N

200 E

Location _____

Rig up _____

Drilling and Remarks:

*fishing
tools @
525*

RECORD

Cased _____ in., _____ ft.

Sand _____

Gas _____

Oil _____

Total Depth _____

PRODUCTION

1st 24 hrs. Nat. _____

1st 24 hrs. after shot _____

Gas _____ Cu. Ft.

Dry Hole _____

Abandoned _____

Date


6/26 1919 Pyle Scout

Map No. K15 Sec. 7 Twp. 26 R. 7Well No. 2 Demore
Demore Syndicate Company

Contractor _____

NORTH

WEST

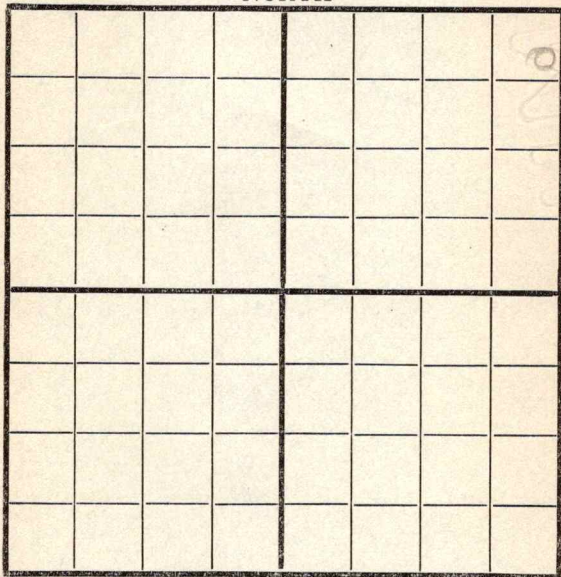

EAST

SOUTH

Location _____

Rig up _____

Drilling and Remarks:

fishing
@
525'

RECORD

Cased _____ in., _____ ft.

Sand _____

Gas _____

Oil _____

Total Depth _____

PRODUCTION

1st 24 hrs. Nat. _____

1st 24 hrs. after shot _____

Gas _____ Cu. Ft.

Dry Hole _____

Abandoned _____

Date


7/3 1919 Pyle Scout

Map No. K15 Sec. 7 Twp. 26 R. 7Well No. 2 Hemmore
Hemmore Syndicate Company
Contractor

NORTH

WEST

EAST

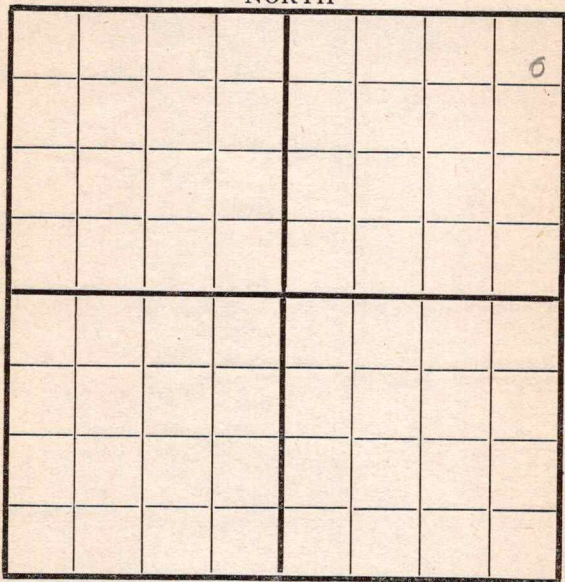

SOUTH

600 N200 E

Location _____

Rig up _____

Drilling and Remarks:

0.10 @
525'

RECORD

Cased _____ in., _____ ft.

Sand _____

Gas _____

Oil _____

Total Depth _____

PRODUCTION

1st 24 hrs. Nat. _____

1st 24 hrs. after shot _____

Gas _____ Cu. Ft.

Dry Hole _____

Abandoned _____

Date

7/12 1919

Gyle Scout

Map No. K15 Sec. 7 Twp. 26 R. 7Well No. 2 DemourDemour Syndicate Company

Contractor

NORTH

WEST

EAST

SOUTH

Location _____

Rig up _____

Drilling and Remarks:

J. 10 @
525 Tools
in hole

RECORD

Cased _____ in., _____ ft.

Sand _____

Gas _____

Oil _____

Total Depth _____

PRODUCTION

1st 24 hrs. Nat. _____

1st 24 hrs. after shot _____

Gas _____ Cu. Ft.

Dry Hole _____

Abandoned _____

Date

7/19 191 9. Pyle Scout


Map No. K15 Sec. 7 Twp. 26 R. 7Well No. 2 DennoreDennore Syndicate Company

Contractor _____

NORTH

WEST

EAST

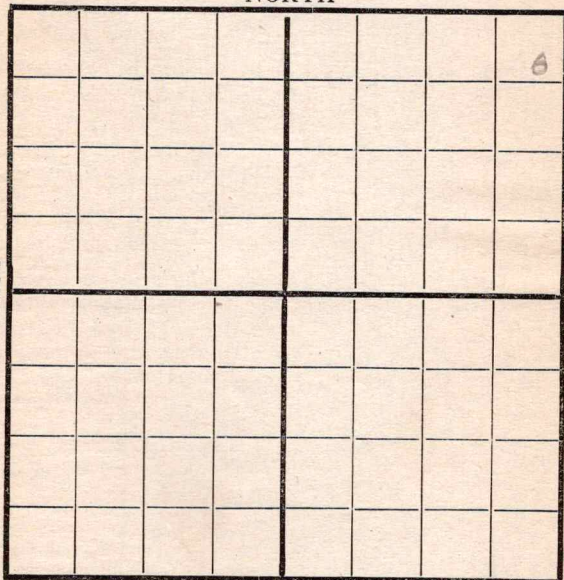

SOUTH

600 H200 E

Location _____

Rig up _____

Drilling and Remarks:

fishing @
525'

RECORD

Cased _____ in., _____ ft.

Sand _____

Gas _____

Oil _____

Total Depth _____

PRODUCTION

1st 24 hrs. Nat. _____

1st 24 hrs. after shot _____

Gas _____ Cu. Ft.


Dry Hole _____

Abandoned _____

Date

7/23 1919 Py Scout

Map No. K15 Sec. 7 Twp. 26 R. 7
 Well No. 2 Demore
Demore Syndicate Company
 Contractor

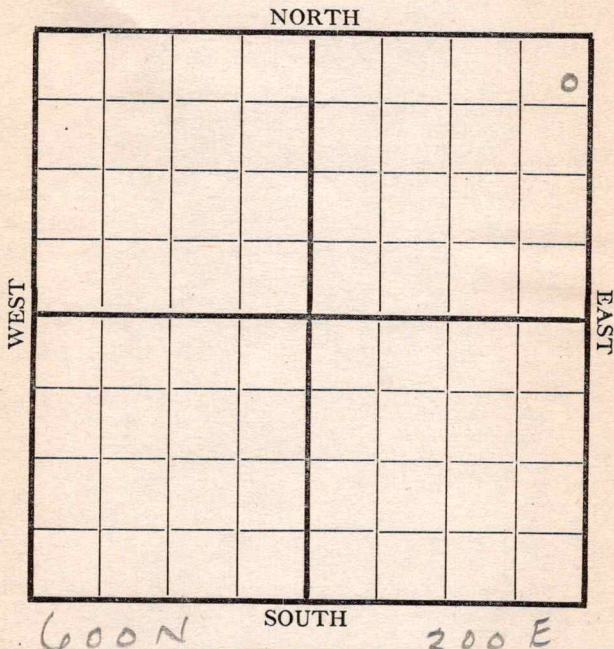

Location _____

Rig up _____

Drilling and Remarks:

840'

RECORD

Cased _____ in., _____ ft.

Sand _____

Gas _____

Oil _____

Total Depth _____

PRODUCTION

1st 24 hrs. Nat. _____

1st 24 hrs. after shot _____

Gas _____ Cu. Ft.

Dry Hole _____

Abandoned _____

Date

8/3 1919


Cycle Scout

Map No. K15 Sec. 7 Twp. 26 R. 7
 Well No. 2 Demour
Demour Syndicate Company
 Contractor

NORTH

WEST

EAST

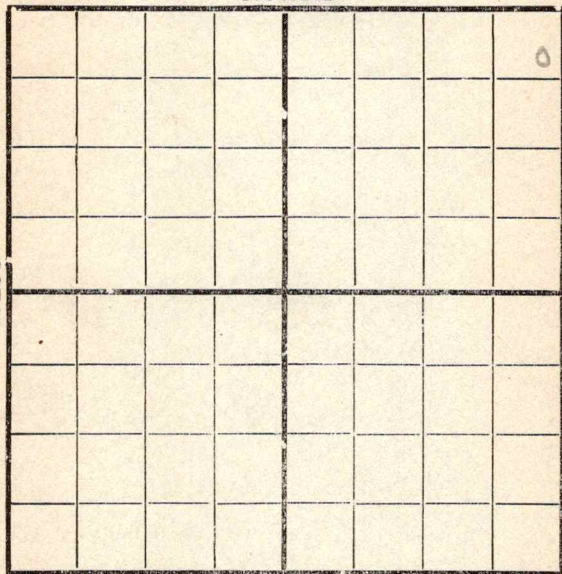

SOUTH

600 N

200 E

Location _____

Rig up _____

Drilling and Remarks:

D. 10 @
 840'

RECORD

Cased _____ in., _____ ft.

Sand _____

Gas _____

Oil _____

Total Depth _____

PRODUCTION

1st 24 hrs. Nat. _____

1st 24 hrs. after shot _____

Gas _____ Cu. Ft.

Dry Hole _____

Abandoned _____

Date

191

9

Pyle

Scout

Map No. K 15 Sec. 7 Twp. 26 R. 7
 Well No. 2 Demour
Demour Syndicate Company
 Contractor

NORTH							
WEST							
SOUTH							
600 N				400 E			

Location _____

Rig up _____

Drilling and Remarks:

1000

RECORD

Cased _____ in., _____ ft.

Sand _____

Gas _____

Oil _____

Total Depth _____

PRODUCTION

1st 24 hrs. Nat. _____

1st 24 hrs. after shot _____

Gas _____ Cu. Ft.

Dry Hole _____

Abandoned _____

Date

8/15

191 9

Pyle

Scout

Sec. 7 Twp. 26 Rge. 7
Owner Demore Syndicate
Farm Demore Well No. 2
Contractor _____

Feet from lines, N. 600 E. 200 S. _____ W. _____

Casing used _____

15½ _____ ft.

12½ _____ ft.

10 _____ ft.


8¼ _____ ft.

6⅝ _____ ft.

5 3-16 _____ ft.

Location _____

Rig _____

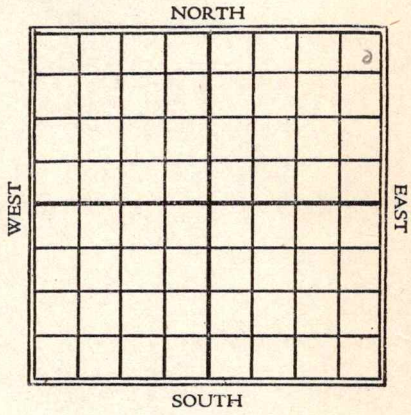

Drilling at _____ ft. Fishing at _____ ft.

Total Depth _____ Completed _____

1st 24 Hrs. Nat. _____ Producing _____

1st 24 Hrs. Shot _____ Dry Hole _____

Gas _____ Cu. ft. Abandoned _____

Sands — give name and depth. Top _____ Bottom _____

2000
1000

Date of Report 7/20

Reported by _____

Pyle

Map No. K15 Sec. 7 Twp. 26 R. 7Well No. 2 Demare
Demare Syndicate Company

Contractor _____

SECTION PLAT

600 Ft. from N. Line

_____ Ft. from S. Line

200 Ft. from E. Line

_____ Ft. from W. Line

			<u>0</u>

Location _____

Rig up _____

Drilling and Remarks:

D. D. @
1000'

RECORD

Cased _____ in., _____ ft.

Sand _____

Gas _____

Oil _____

Total Depth _____

PRODUCTION

1st 24 hrs. Nat. _____

1st 24 hrs. after shot _____

Gas _____ Cu. Ft.

Dry Hole _____

Abandoned _____

Date

8/29 1919

Pyle

Scout

Map No. K 13 Sec. 7 Twp. 26 R. 7Well No. 2 DemourseDemourse Syndicate Company

Contractor _____

SECTION PLAT

600 Ft. from N. Line

_____ Ft. from S. Line

200 Ft. from E. Line

_____ Ft. from W. Line

			o

Location _____

Rig up _____

Drilling and Remarks:

S. D. C.
1000

RECORD

Cased _____ in., _____ ft.

Sand _____

Gas _____

Oil _____

Total Depth _____

PRODUCTION

1st 24 hrs. Nat. _____

1st 24 hrs. after shot _____

Gas _____ Cu. Ft.

Dry Hole _____

Abandoned _____

Date

9/4 1919

Pyle

Scout

Map No. K 15 Sec. 7 Twp. 26 R. 7Well No. 2 DemourDemour Syndicate Company

Contractor

SECTION PLAT

600 Ft. from N. Line

Ft. from S. Line

100 Ft. from E. Line

Ft. from W. Line

			o

Location

Rig up

Drilling and Remarks:

D. D. @
1000

RECORD

Cased _____ in., _____ ft.

Sand _____

Gas _____

Oil _____

Total Depth _____

PRODUCTION

1st 24 hrs. Nat. _____

1st 24 hrs. after shot _____

Gas _____ Cu. Ft.

Dry Hole _____

Abandoned _____

Date

9/15 1919Oyle

Scout

Map No. K 15 Sec. 7 Twp. 26 R. 7Well No. 2 DemourDemour Syndicate Company

Contractor

SECTION PLAT

600 Ft. from N. Line

_____ Ft. from S. Line

200 Ft. from E. Line

_____ Ft. from W. Line

			<u>0</u>

Location _____

Rig up _____

Drilling and Remarks:

DD @
1000'

RECORD

Cased _____ in., _____ ft.

Sand _____

Gas _____

Oil _____

Total Depth _____

PRODUCTION

1st 24 hrs. Nat. _____

1st 24 hrs. after shot _____

Gas _____ Cu. Ft.

Dry Hole _____

Abandoned _____

Date

9/ 191920

Pyle

Scout

Map No. K15 Sec. 7 Twp. 26 R. 7Well No. 2 DemoreDemore Syndicate Company

Contractor

SECTION PLAT

600 Ft. from N. Line

Ft. from S. Line

200 Ft. from E. Line

Ft. from W. Line

			0

Location

Rig up

Drilling and Remarks:

D. 10 @
1000'

RECORD

Cased _____ in., _____ ft.

Sand _____

Gas _____

Oil _____

Total Depth _____

PRODUCTION

1st 24 hrs. Nat. _____

1st 24 hrs. after shot _____

Gas _____ Cu. Ft.

Dry Hole _____

Abandoned _____

Date

9/ 191 9 Pyle Scout
26

Map No. K15 Sec. 7 Twp. 26 R. 7Well No. 2 RemaineRemaine Syndicate Company

Contractor

SECTION PLAT

600 Ft. from N. Line

Ft. from S. Line

200 Ft. from E. Line

Ft. from W. Line

			0

Location

Rig up

Drilling and Remarks:

RECORD

Cased in., ft.

Sand

Gas

Oil

Total Depth

PRODUCTION

1st 24 hrs. Nat.

1st 24 hrs. after shot

Gas Cu. Ft.

Dry Hole

Abandoned

Date

10/4 1919

Pyle

Scout

Map No. K15 Sec. 7 Twp. 26 R. 7

Well No. 2 Demour

Demour Syndicate Company
Contractor

SECTION PLAT

600 Ft. from N. Line

_____ Ft. from S. Line

200 Ft. from E. Line

_____ Ft. from W. Line

			0

Location _____

Rig up _____

Drilling and Remarks:

D. O. C.
1000'

RECORD

Cased _____ in., _____ ft.

Sand _____

Gas _____

Oil _____

Total Depth _____

PRODUCTION

1st 24 hrs. Nat. _____

1st 24 hrs. after shot _____

Gas _____ Cu. Ft.

Dry Hole _____

Abandoned _____

Date

10/19 1919

Pyle

Scout

Map No. K15 Sec. 7 Twp. 26 R. 7Well No. 2 DemoureDemoure Syndicate Company

Contractor

SECTION PLAT

600 Ft. from N. Line

Ft. from S. Line

200 Ft. from E. Line

Ft. from W. Line



Location

Rig up

Drilling and Remarks:

Plugged
back to 2765

RECORD

Cased _____ in., _____ ft.

Sand 2763-65

Gas _____

Oil _____

Total Depth 2769

PRODUCTION

1st 24 hrs. Nat. 15 bbls

1st 24 hrs. after shot _____

Gas _____ Cu. Ft.

Dry Hole _____

Abandoned _____

Date

10/20 1920

Pyle

Scout