

Map No. _____ Sec 10 Twp 26 R 4Well No. 9 Calston Farm _____Eureka Oil Company _____

NORTH

WEST

EAST

SOUTH

COMPLETED

Location _____

Rig Up _____

Drilling Remarks:

Drilling Remarks:

RECORD

Cased _____ in _____ Ft.

Sand _____

Gas _____

Oil _____

Total Depth _____

PRODUCTION

1st 24 hrs. Nat. _____

1st 24 hrs. after shot _____


Gas _____ Cu. Ft.

Dry Hole _____

Abandoned _____

Map No. _____ Sec. 10 Twp. 26 R. 4
 Well No. 9 Ralston Farm _____
Eureka Oil Company

NORTH

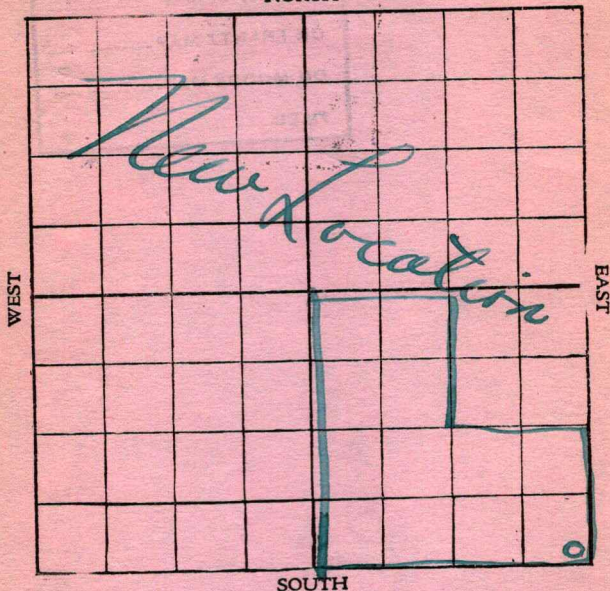

SOUTH

Location _____

Rig up _____

Drilling and remarks:

Rig'

RECORD

Cased _____ in. _____ Ft.

Sand _____

Gas _____

Oil _____

Total Depth _____

PRODUCTION

1st 24 hrs. Nat. _____

1st 24 hrs. after shot _____

Gas _____ Cu. Ft.


Dry Hole _____

Abandoned _____

Date

5/26, 1917, Brocker Scout

Map No. _____ Sec. 10 Twp. 26 R. 4
 Well No. 9 Ralston Farm _____
Eureka Oil Company _____

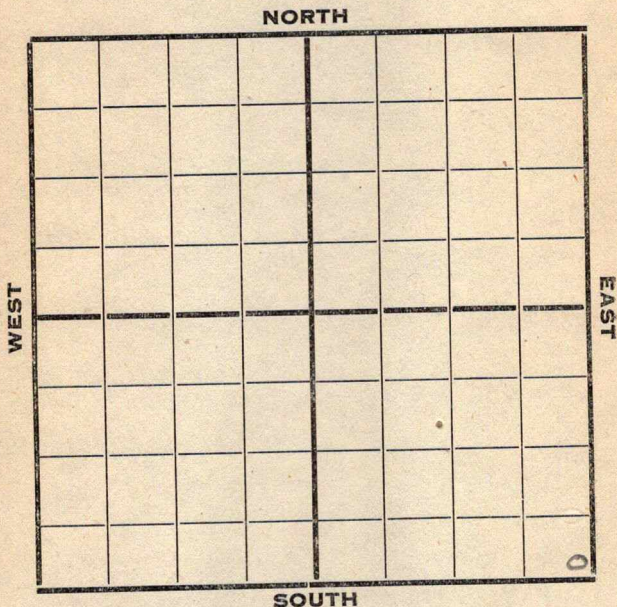

Location _____
 Rig up _____
 Drilling and Remarks:

Rig

RECORD

Cased _____ in. _____ Ft.
 Sand _____
 Gas _____
 Oil _____
 Total Depth _____

PRODUCTION


1st 24 hrs. Nat. _____
 1st 24 hrs. after shot _____
 Gas _____ Cu. Ft.
 Dry Hole _____
 Abandoned _____

Date

6/12, 1917, E. J. Crocker Scout

Map No. _____ Sec. 10 Twp. 26 R. 4Well No. 9 Ralston Farm _____Eureka Oil Company _____

NORTH

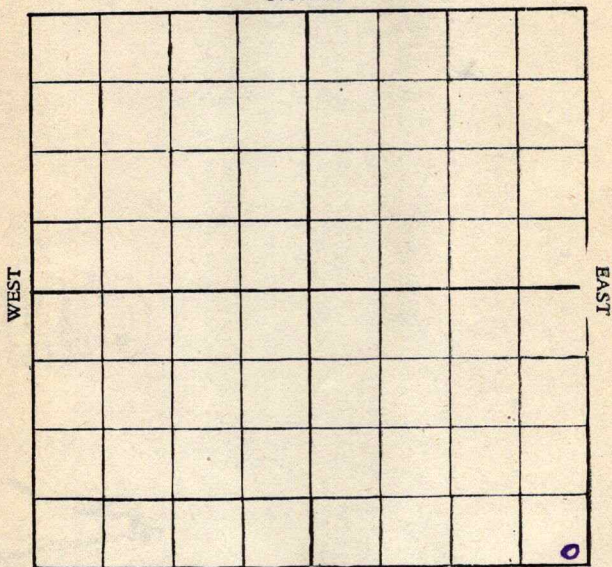

SOUTH

Location _____

Rig up _____

Drilling and remarks:

Spud.

RECORD

Cased _____ in. _____ Ft.

Sand _____

Gas _____

Oil _____

Total Depth _____

PRODUCTION

1st 24 hrs. Nat. _____

1st 24 hrs. after shot _____

Gas _____ Cu. Ft.

Dry Hole _____

Abandoned _____

Date

JUN 9 - 1917G. T. Crocker


Scout

Map No. _____ Sec. 10 Twp. 26 R. 4

Well No. 9 Ralston Farm

Eureka Oil Company

NORTH

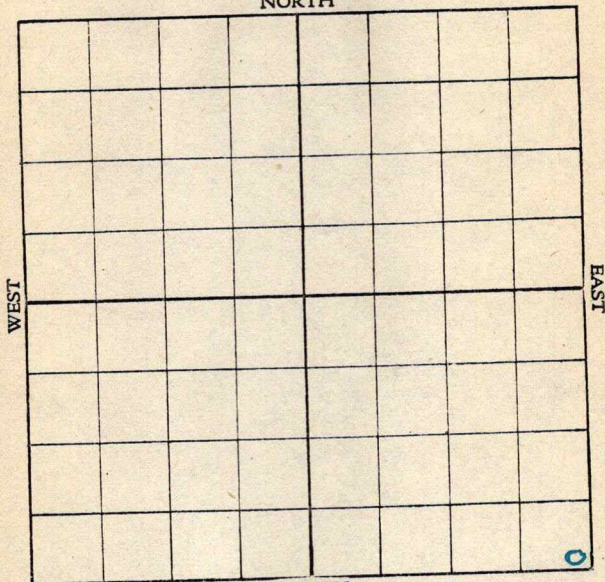

SOUTH

Location _____

Rig up _____

Drilling and remarks:

D-300'

RECORD

Cased _____ in. _____ Ft.

Sand _____

Gas _____

Oil _____

Total Depth _____

PRODUCTION

1st 24 hrs. Nat. _____

1st 24 hrs. after shot _____

Gas _____ Cu. Ft.

Dry Hole _____

Abandoned _____

Date

JUN 16 1917


G. T. Crocker

Scout

_____, 191_____, _____

Map No. _____ Sec. 10 Twp. 26 R. 4
 Well No. 9 Ralston Farm
Eureka Oil Company

NORTH

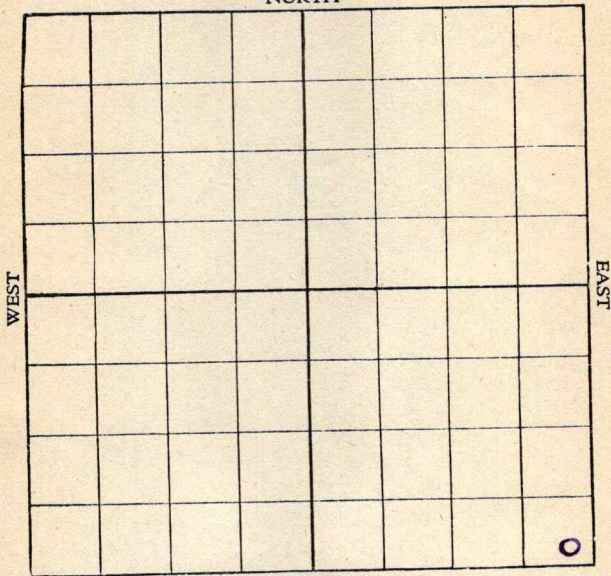

SOUTH

Location _____

Rig up _____

Drilling and remarks:

D-450

RECORD

Cased _____ in. _____ Ft.

Sand _____

Gas _____

Oil _____

Total Depth _____

PRODUCTION

1st 24 hrs. Nat. _____

1st 24 hrs. after shot _____

Gas _____ Cu. Ft.

Dry Hole _____

Abandoned _____

Date


JUN 22 1917

, 191

E. J. Crocker Scout

Map No. _____ Sec. 10 Twp. 24 R. 4
 Well No. 9 Palston Farm _____
Eureka Oil Company

NORTH

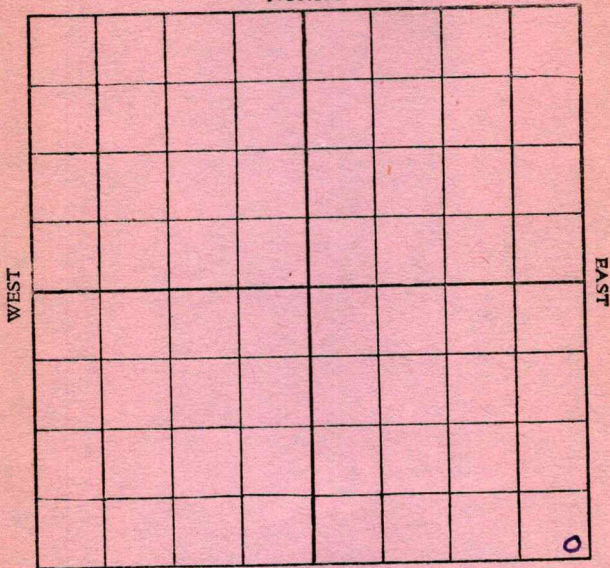

SOUTH

Location _____
 Rig up _____
 Drilling and remarks:

D-1050'
Running
15 bails of
water per hr

RECORD

Cased _____ in. _____ Ft.
 Sand _____
 Gas _____
 Oil _____
 Total Depth _____

PRODUCTION

1st 24 hrs. Nat. _____
 1st 24 hrs. after shot _____
 Gas _____ Cu. Ft.
 Dry Hole _____
 Abandoned _____


Date JUN 30 1917
 _____, 191 _____, C. J. Crocker Scout

Map No. _____ Sec. 18 Twp. 26 R. 4

Well No. 9 Ralston Farm

Eureka Oil Company

NORTH

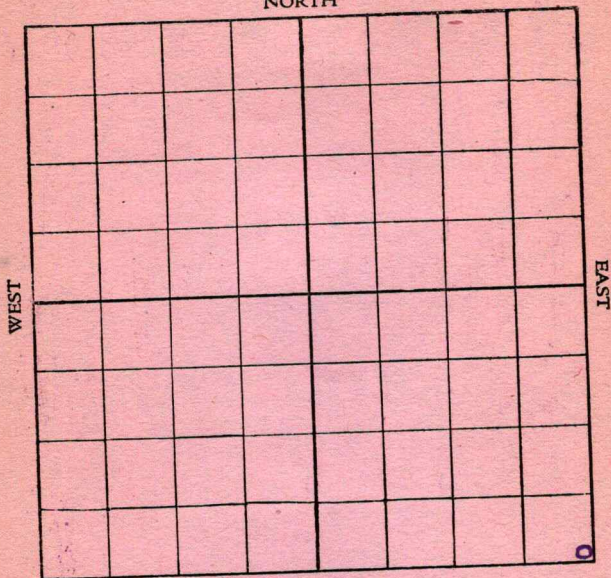

SOUTH

Location _____

Rig up _____

Drilling and remarks:

73-2-1540

RECORD

Cased _____ in. _____ Ft.

Sand _____

Gas _____

Oil _____

Total Depth _____

PRODUCTION

1st 24 hrs. Nat. _____

1st 24 hrs. after shot _____

Gas _____ Cu. Ft.

Dry Hole _____

Abandoned _____


Date JUL 7 1917

, 191

E. J. Crocker Scout

Map No. _____ Sec. 10 Twp. 26 R. 4
 Well No. 9 Palston Farm
Europa Oil Company

NORTH

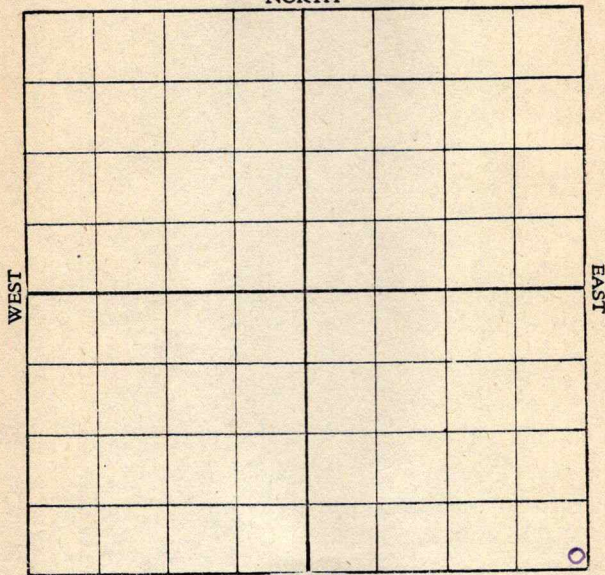

SOUTH

Location _____

Rig up _____

Drilling and remarks:

D- 1700'

RECORD

Cased _____ in. _____ Ft.

Sand _____

Gas _____

Oil _____

Total Depth _____

PRODUCTION

1st 24 hrs. Nat. _____

1st 24 hrs. after shot _____

Gas _____ Cu. Ft.

Dry Hole _____


Abandoned _____

Date

JUL 14 1917C. T. Crocker Scout

Map No. _____ Sec. 10 Twp. 26 R. 4Well No. 9 Ralston Farm _____
Eureka Oil Company

NORTH

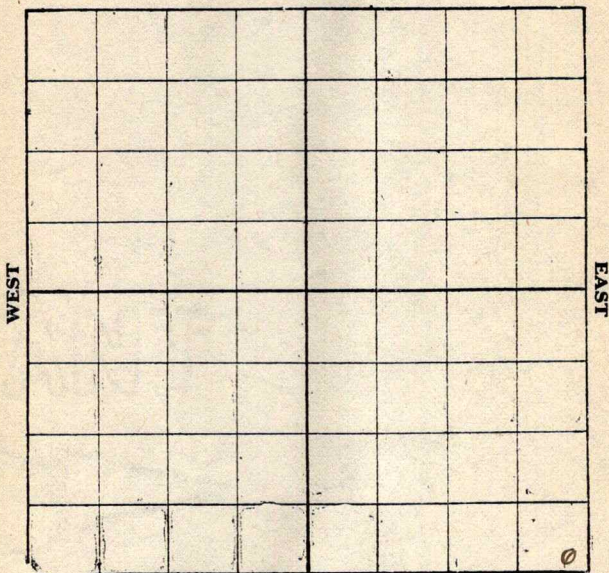

SOUTH

RECORD

Location _____

Rig up _____

Drilling and Remarks: _____

Cased _____ in. _____ Ft.

Sand _____

Gas _____

Oil _____

Total Depth _____

PRODUCTION

1st 24 hrs. Nat. _____

1st 24 hrs. after shot _____

Gas _____ Cu. Ft.

Dry Hole _____


Abandoned _____

Date

7/27, 1917, Cordiff Scout

Map No. _____ Sec. 10 Twp. 26 R. 4
 Well No. 9 Balscon Farm _____
Cure 12a Company _____

NORTH

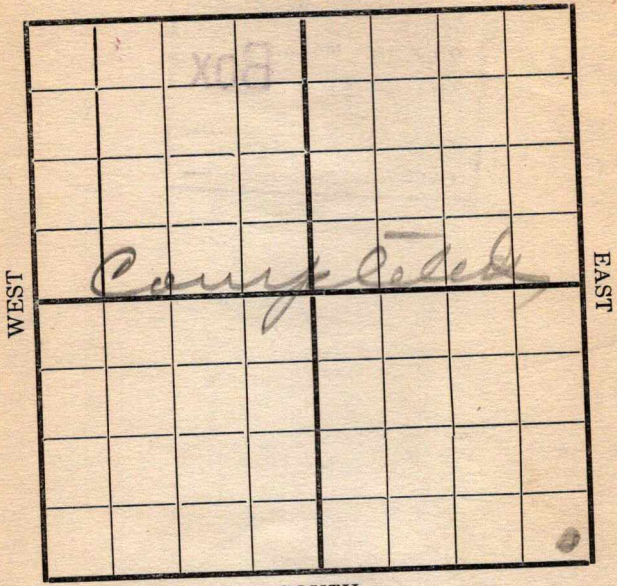

SOUTH

Location _____
 Rig Up _____
 Drilling and remarks
Estimated
at 200
13 bbls

RECORD

Cased _____ in. _____ Ft.
 Sand 2345-2405
 Gas _____
 Oil _____
 Total Depth _____

PRODUCTION

1st 24 hrs. Nat. _____
 1st 24 hrs. after shot _____
 Gas _____ Cu. Ft.
 Dry Hole _____
 Abandoned _____

Date 8/3, 1912 Carey Scout _____

K14 **KANSAS** SEC. 10 TWP. 76S R. 4E

WELL NO. 9 Ralston
Eureka oil COMPANY

CONTRACTOR

SECTION PLAT

ABANDONED

_____ FT. FROM N. LINE

_____ FT. FROM S. LINE

_____ FT. FROM E. LINE

_____ FT. FROM W. LINE

LOCATION _____

RIG UP _____

DRILLING AND REMARKS:

RECORD

CASED _____ IN. _____ FT.

SAND _____

GAS _____

OIL _____

TOTAL DEPTH 2409

PRODUCTION

1ST 24 HRS. NAT. _____

1ST 24 HRS. AFTER SHOT _____

GAS _____ CU. FT.

DRY HOLE _____

ABANDONED _____

DATE

8-8 1917 SCOUT