
Butler KANSAS

FORM 51

Section 11 Township 26 Range 7E

Well No. #2 Marshall

Company Rex & Morris

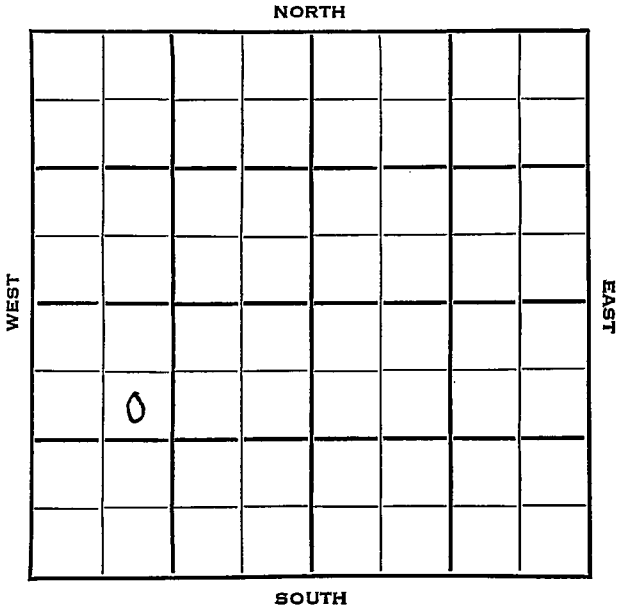

Butler KANSAS

SEC.	TWP.	R.
11	26	7E

WELL NO.

2 Marshall FARM

COMPANY

Rex & Morris

CONTRACTOR

Rex & Morris

NE Long Pool


990 Ft. from N. Line

Ft. from S. Line

Ft. from E. Line

990 Ft. from W. Line

SE NW SW

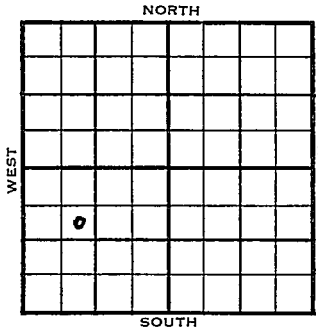

	ELEVATION	REPORT
1953	1502'	
9/23	Location	
10/7	Spud 9-22-53 8" @ 89' KC 2096', Miss 2766 TD 2806' D & A	

ABANDONED

DX-78

FORM 275 FOR SALE BY KANSAS BLUE PRINT CO.

County Butler State Kansas

Sec. 11 (Blk. Twp.) 26 (Sur. Rge.) 7E Map No.

Operator Rex & Morris

Well No. 2 Farm Marshall

Elev. Location SE NW SW

FIRST REPORT

990 Ft. From N Line SW

990 Ft. From W Line Quarter

1st. Report SEP 23 1953

Completion

Remarks

Rex & Morris - Contr.

Spudding Date

Drlg. Data NE Long Pool

Location

J. G. McGEHEE

FORM 275 FOR SALE BY KANSAS BLUE PRINT CO.

County Butler State Kansas

Sec. 11 (Blk. Twp.) 26 (Sur. Rge.) 7E Map No.

Operator Rex & Morris

Well No. 2 Farm Marshall

Elev. 1502 Location SE NW SW



990 Ft. From N Line SW

990 Ft. From W Line Quarter

1st. Report

Completion OCT 7 1953

Remarks NE Long Pool

Rex & Morris - Contr.

Spudding Date 9-22-53

Drlg. Data

8" @ 89 KC 2096 Miss. 2766 TD 2806

D & A

J. G. McGEHEE