

Map No. _____ Sec 10 Twp 26 R 4Well No. J. Ralston Farm _____Eureka Oil Company _____

NORTH

WEST

EAST

SOUTH

COMPLETED

Location _____

Rig Up _____

Drilling Remarks:

Drilling Remarks:

RECORD

Cased _____ in _____ Ft.

Sand _____

Gas _____

Oil _____

Total Depth _____

PRODUCTION

1st 24 hrs. Nat. _____

1st 24 hrs. after shot _____

Gas _____ Cu. Ft.

Dry Hole _____


Abandoned _____

Map No. _____ Sec. 10 Twp. 26 R. 4

Well No. 8 Kalston Farm _____

Eureka Oil Company _____

NORTH

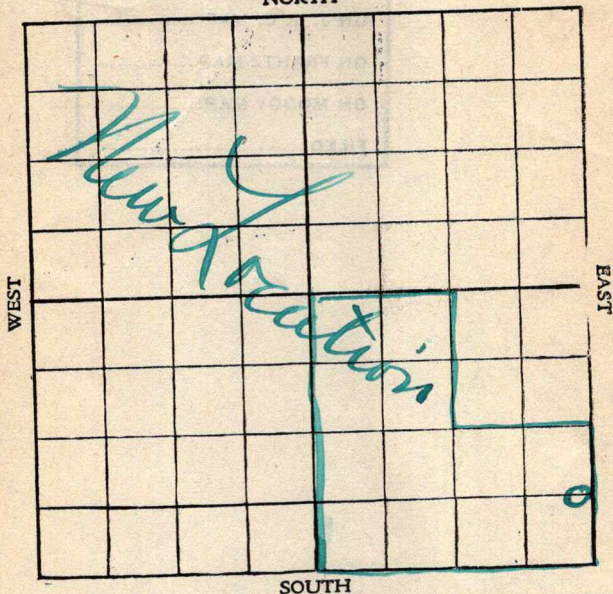

SOUTH

Location _____

Rig up _____

Drilling and remarks:

Rig.

RECORD

Cased _____ in. _____ Ft.

Sand _____

Gas _____

Oil _____

Total Depth _____

PRODUCTION

1st 24 hrs. Nat. _____

1st 24 hrs. after shot _____


Gas _____ Cu. Ft.

Dry Hole _____

Abandoned _____

Date

5/26/1917 Procker Scout

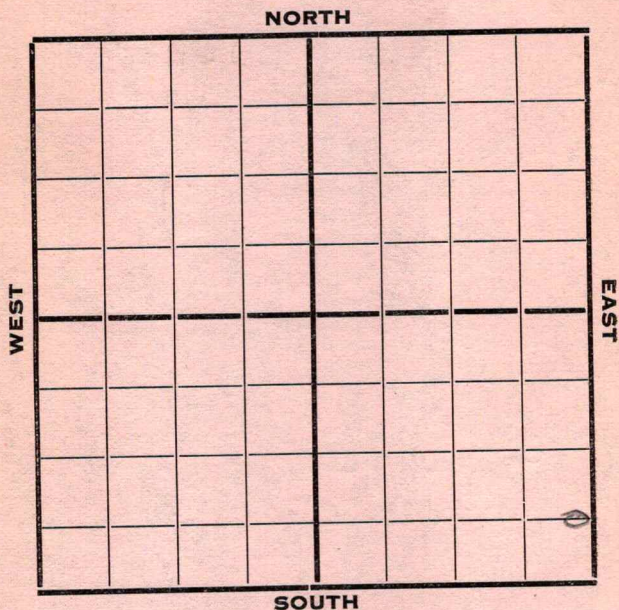Map No. _____ Sec. 10 Twp. 26 R. 4Well No. 8 Ralston Farm
Eureka Oil Company

Location _____

Rig up _____

Drilling and Remarks:

Rig.**RECORD**

Cased _____ in. _____ Ft.

Sand _____

Gas _____

Oil _____

Total Depth _____

PRODUCTION

1st 24 hrs. Nat. _____

1st 24 hrs. after shot _____

Gas _____ Cu. Ft.

Dry Hole _____

Abandoned _____

Date


6/2, 1917, C. J. Crocker Scout

Map No. _____ Sec. 10 Twp. 26 R. 4

Well No. 8 Palston Farm

Eureka Oil Company

NORTH

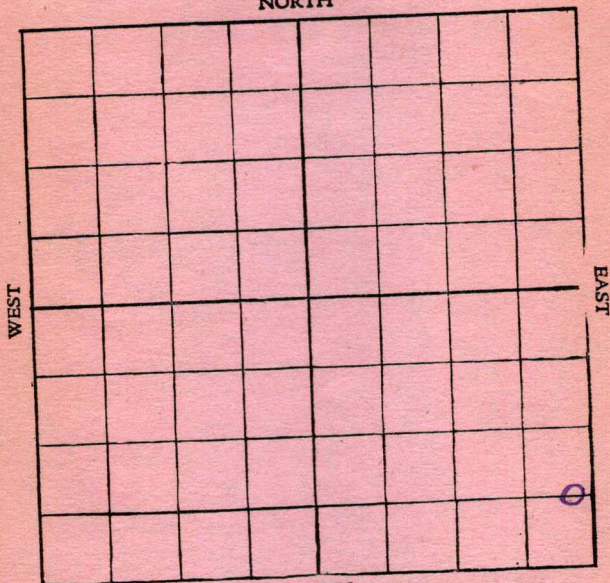

SOUTH

Location _____

Rig up _____

Drilling and remarks:

Rig.

RECORD

Cased _____ in. _____ Ft.

Sand _____

Gas _____

Oil _____

Total Depth _____

PRODUCTION

1st 24 hrs. Nat. _____

1st 24 hrs. after shot _____

Gas _____ Cu. Ft.

Dry Hole _____

Abandoned _____

Date

JUN 9 - 1917

, 191

E. J. Crocker


Scout

Map No. _____ Sec. 10 Twp. 26 R. 4

Well No. 8 Ralston Farm _____

Eureka Oil Company _____

NORTH

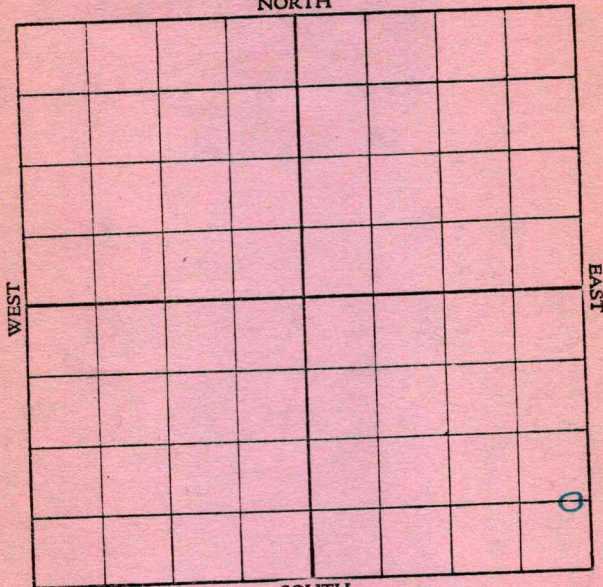

SOUTH

Location _____

Rig up _____

Drilling and remarks:

Rig up

RECORD

Cased _____ in. _____ Ft.

Sand _____

Gas _____

Oil _____

Total Depth _____

PRODUCTION

1st 24 hrs. Nat. _____

1st 24 hrs. after shot _____

Gas _____ Cu. Ft.

Dry Hole _____


Abandoned _____

Date
JUN 16 1917

_____, 191____,

E. J. Crocker
Scout

Map No. _____ Sec. 10 Twp. 26 R. 4
 Well No. 8 Ralston Farm
Eureka Oil Company

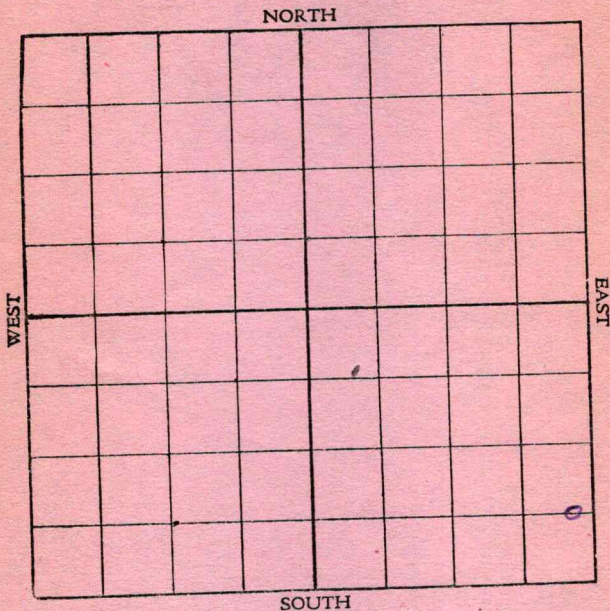

Location _____

Rig up _____

Drilling and remarks:

250

RECORD

Cased _____ in. _____ Ft.

Sand _____

Gas _____

Oil _____

Total Depth _____

PRODUCTION

1st 24 hrs. Nat. _____

1st 24 hrs. after shot _____

Gas _____ Cu. Ft.

Dry Hole _____

Abandoned _____

Date

JUN 22 1917


C. T. Crocker
 Scout

Map No. _____ Sec. 10 Twp. 26 R. 4

Well No. 8 Ralston Farm _____

Eureka Oil Company _____

NORTH

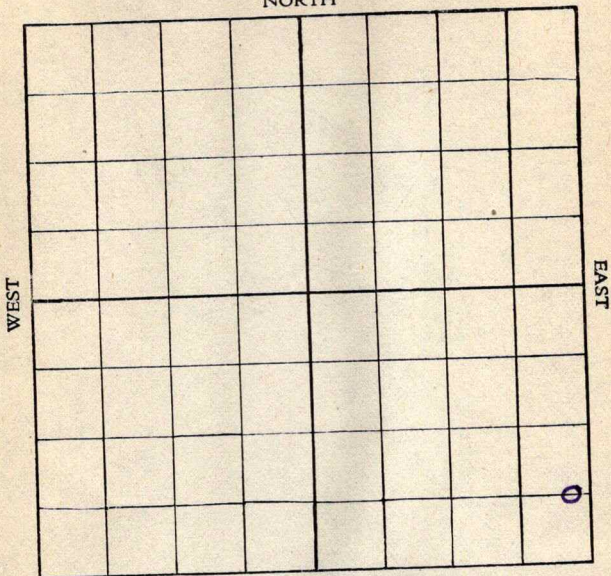

SOUTH

Location _____

Rig up _____

Drilling and remarks:

D-725'

RECORD

Cased _____ in. _____ Ft.

Sand _____

Gas _____

Oil _____

Total Depth _____

PRODUCTION

1st 24 hrs. Nat. _____

1st 24 hrs. after shot _____

Gas _____ Cu. Ft.

Dry Hole _____

Abandoned _____

Date JUN 30 1917

_____, 191____,

G. J. Crocker


Scout

Map No. _____ Sec. 10 Twp. 26 R. 4

Well No. 8 Ralston Farm

Eureka Oil Company

NORTH

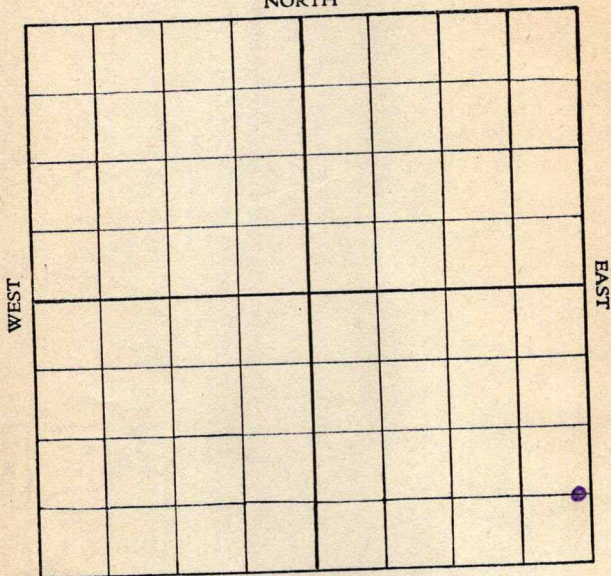

SOUTH

Location _____

Rig up _____

Drilling and remarks:

D-1020'

RECORD

Cased _____ in. _____ Ft.

Sand _____

Gas _____

Oil _____

Total Depth _____

PRODUCTION

1st 24 hrs. Nat. _____

1st 24 hrs. after shot _____

Gas _____ Cu. Ft.

Dry Hole _____


Abandoned _____

Date JUL 7 1917

, 191

C. J. Crocker Scout

Map No. _____ Sec. 10 Twp. 26 R. 4
 Well No. 8 Palston Farm _____
Eureka Oil Company

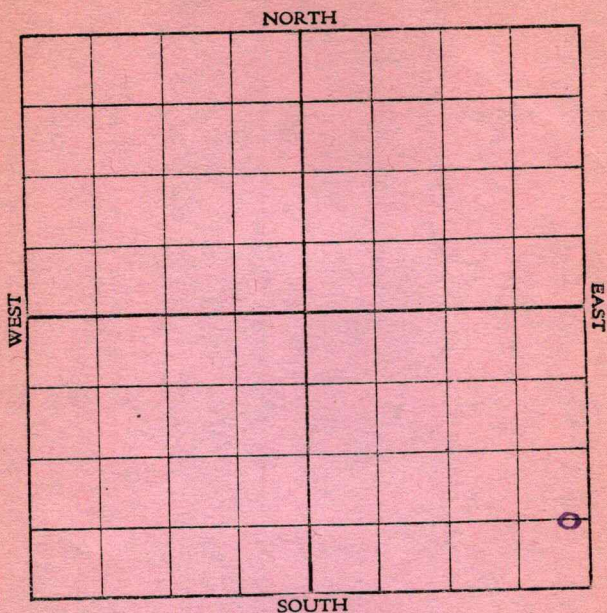

Location _____
 Rig up _____
 Drilling and remarks:

D-1415'

RECORD

Cased _____ in. _____ Ft.
 Sand _____
 Gas _____
 Oil _____
 Total Depth _____

PRODUCTION

1st 24 hrs. Nat. _____
 1st 24 hrs. after shot _____
 Gas _____ Cu. Ft.
 Dry Hole _____
 Abandoned _____


Date

JUL 14 1917, 191 E. J. Crocker Scout

Map No. _____ Sec. 10 Twp. 26 R. X

Well No. 8 Ralston Farm _____
Eureka Oil Company _____

NORTH

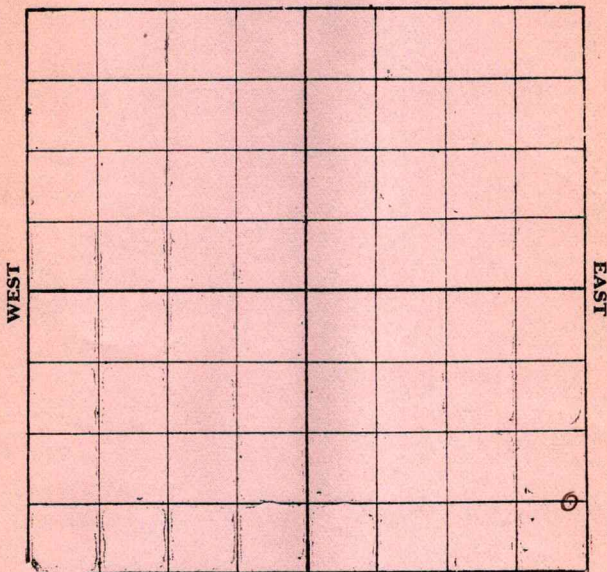

SOUTH

Location _____

Rig up _____

Drilling and Remarks:

RECORD

Cased _____ in. _____ Ft.

Sand _____

Gas _____

Oil _____

Total Depth _____

PRODUCTION

1st 24 hrs. Nat. _____

1st 24 hrs. after shot _____

Gas _____ Cu. Ft.

Dry Hole _____

Abandoned _____

Date


7/26, 1917, Conroy Scout

Map No. _____ Sec. 10 Twp. 26 R 4

NORTH

WEST

EAST

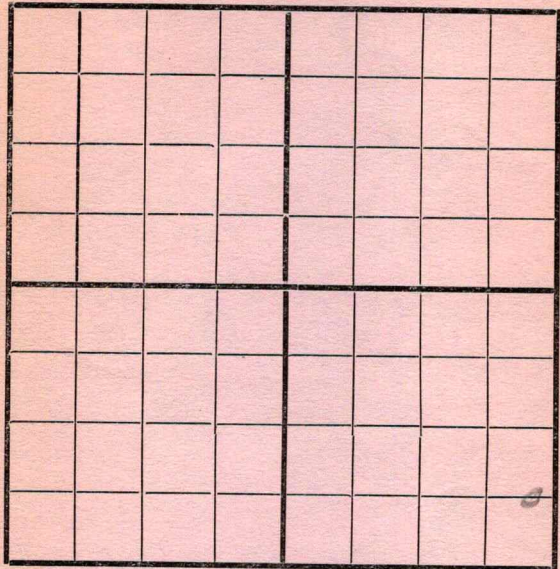

SOUTH

Location _____
Rig Up _____
Drilling and remarks _____

Tap sand
2360

RECORD

Cased _____ in. _____ Ft.
Sand _____
Gas _____
Oil _____
Total Depth _____

PRODUCTION

1st 24 hrs. Nat. _____
1st 24 hrs. after shot _____
Gas _____ Cu. Ft.
Dry Hole _____
Abandoned _____


Date

8/1, 1917 Candey Scout

Map No. _____ Sec. 10 Twp. 26 R. 4Well No. 8 Ralston Farm _____
Eureka Company _____

NORTH

WEST

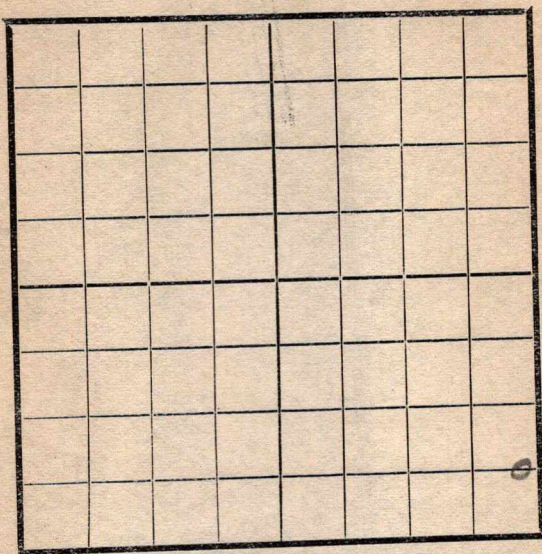

EAST

SOUTH

RECORD

Location _____

Cased _____ in. _____ Ft.

Rig Up _____

Sand _____

Drilling and remarks

Gas _____

Oil _____

Total Depth _____

PRODUCTION

1st 24 hrs. Nat. _____

1st 24 hrs. after shot _____

Gas _____ Cu. Ft.

Dry Hole _____

Abandoned _____


Date

8/9, 1917 Conley Scout _____

Map No. _____ Sec. 10 Twp. 26 R. 4

NORTH

WEST

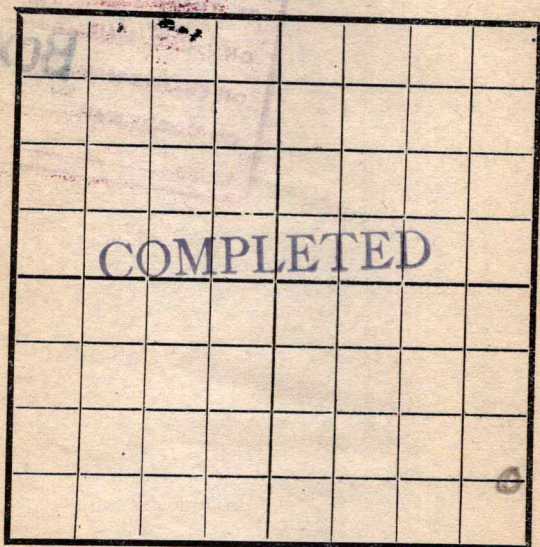

EAST

SOUTH

Location _____
 Rig Up _____
 Drilling and remarks

Col at
110 Barre

RECORD

Cased _____ in. _____ Ft.
 Sand 2360-2390
 Gas _____
 Oil _____
 Total Depth _____

PRODUCTION

1st 24 hrs. Nat. _____
 1st 24 hrs. after shot _____
 Gas _____ Cu. Ft.
 Dry Hole _____
 Abandoned _____

Date

8/17, 1911 J. Conley Scout

MAP NO. KANSAS SEC. 10 TWP. 26 S R. 18

WELL NO. 8 Ralston

Franklin Oil COMPANY

CONTRACTOR

ABANDONED

SECTION PLAT

_____ FT. FROM N. LINE

_____ FT. FROM S. LINE

_____ FT. FROM E. LINE

_____ FT. FROM W. LINE

LOCATION _____

RIG UP _____

DRILLING AND REMARKS:

RECORD

CASED _____ IN. _____ FT.

SAND _____

GAS _____

OIL _____

TOTAL DEPTH 2418

PRODUCTION

1ST 24 HRS. NAT. _____

1ST 24 HRS. AFTER SHOT _____

GAS _____ Cu. Ft.

DRY HOLE _____

ABANDONED ☒

DATE

8-10 1917 _____ SCOUT